POOR ORIGINAL COPY

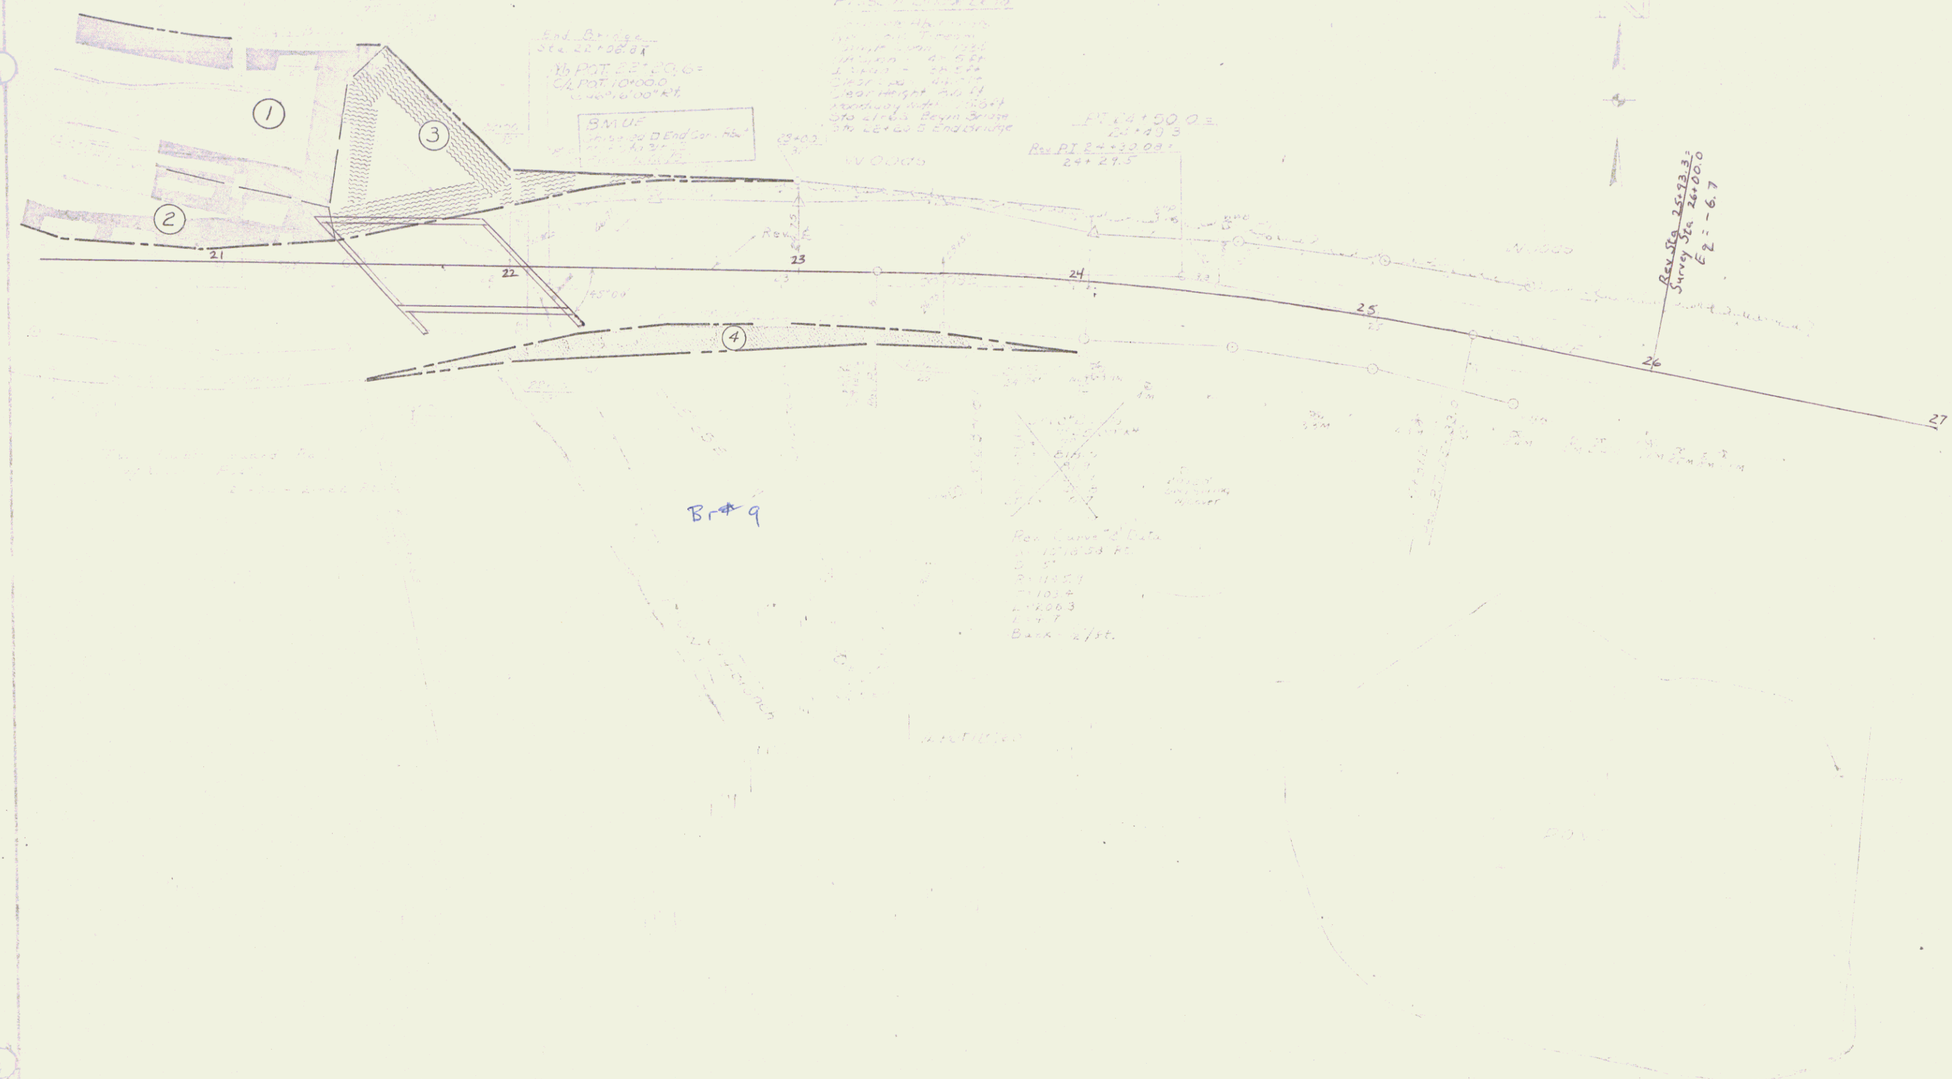

MA/734/2531/65

SHEET 2