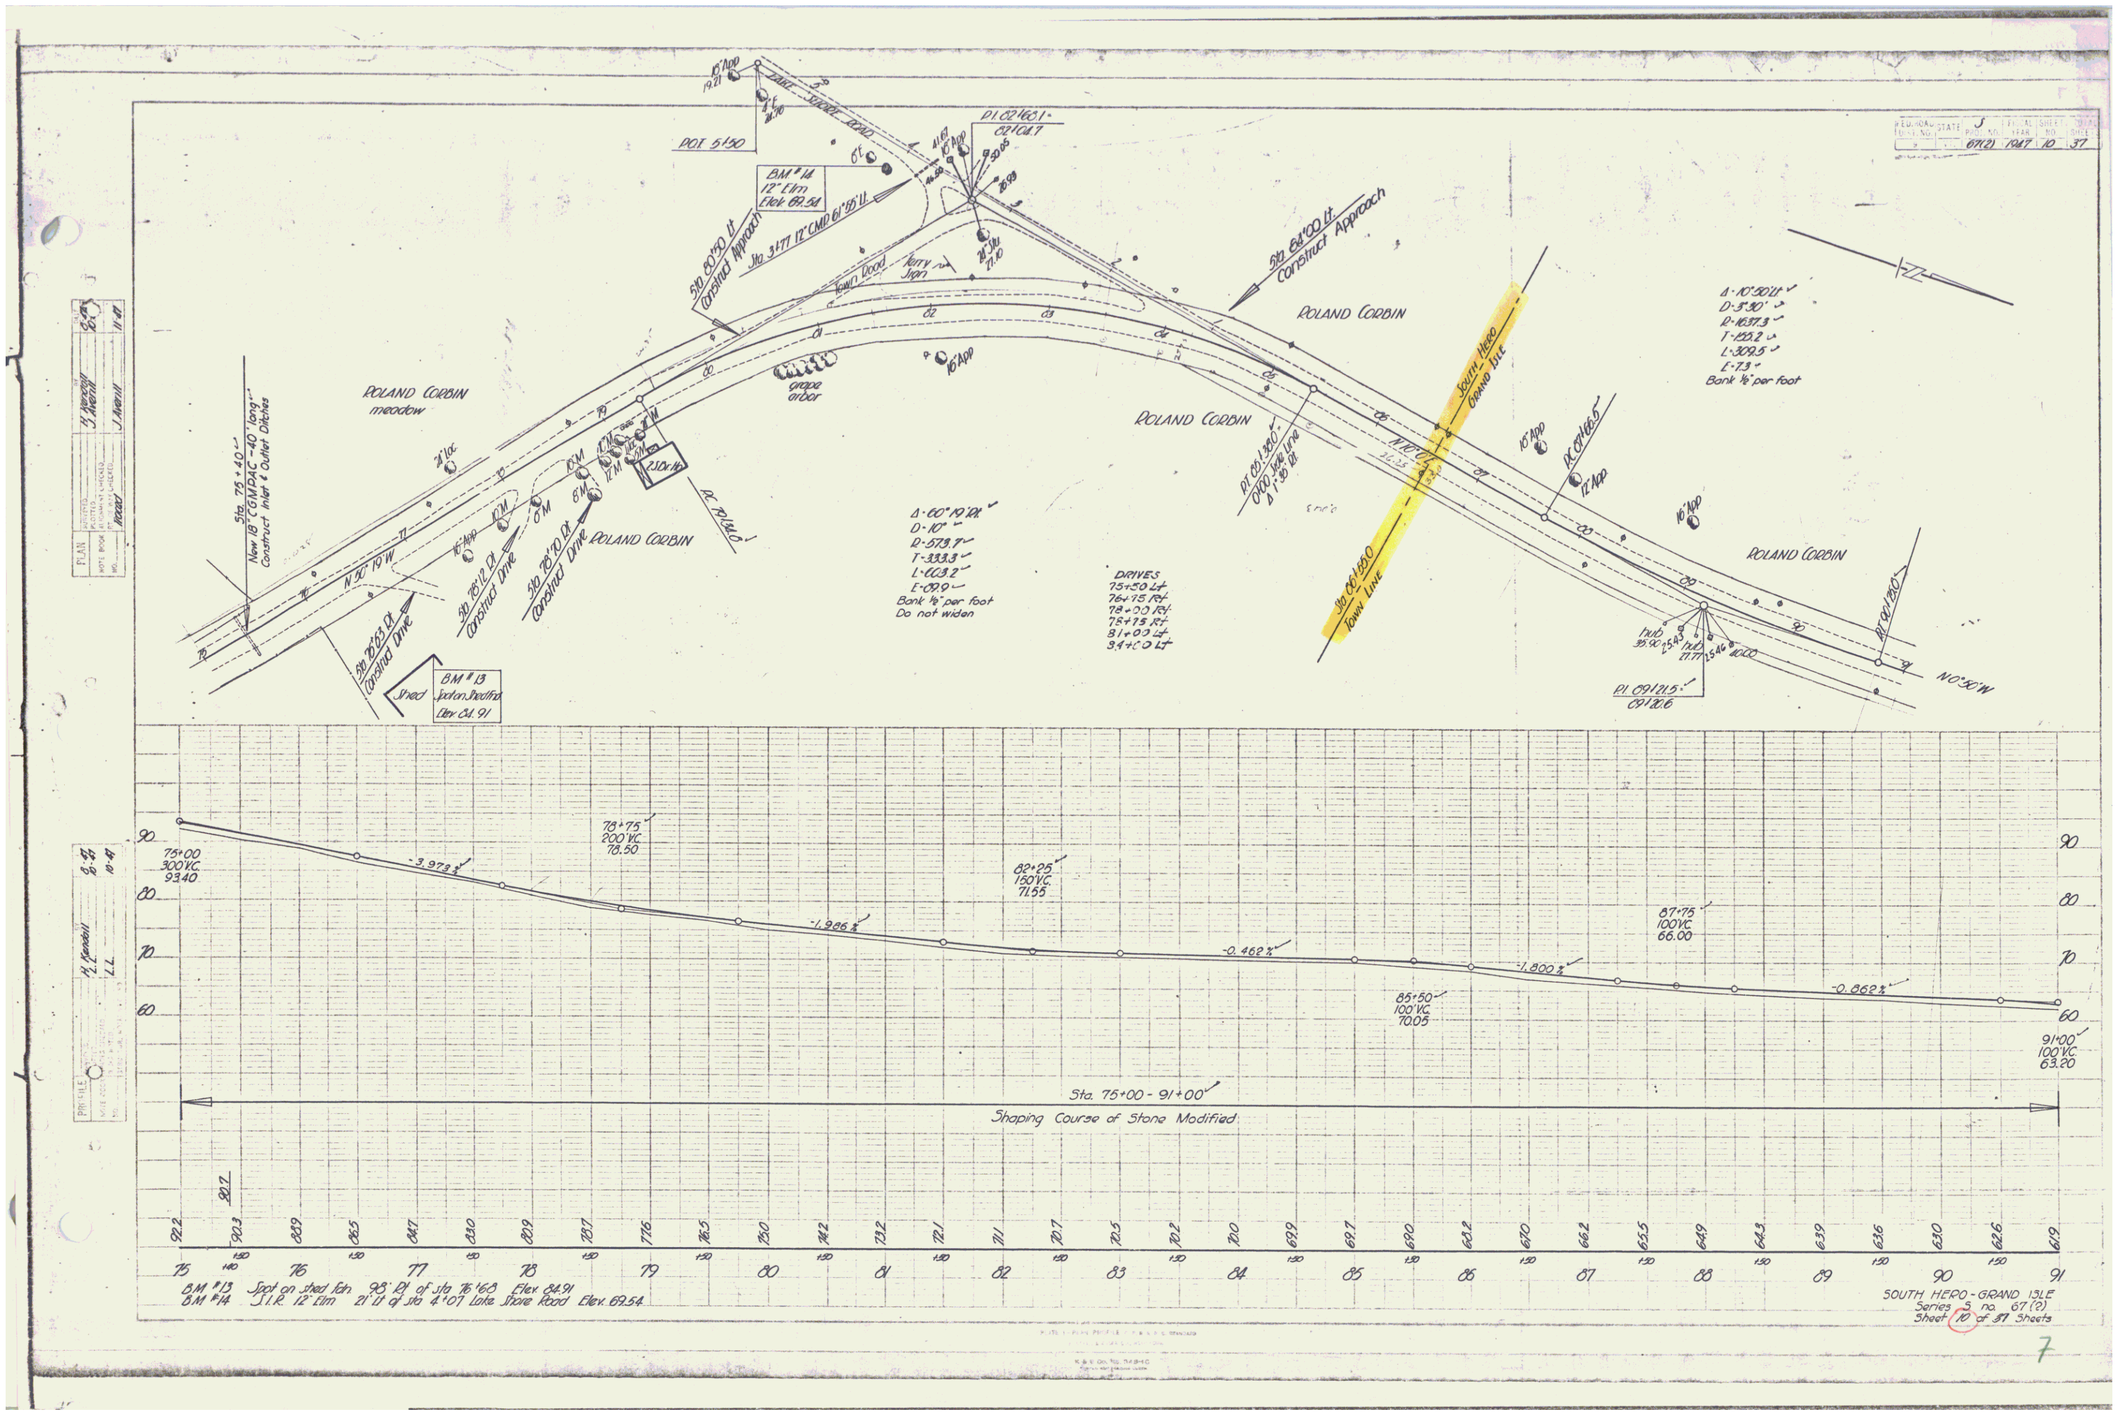
POT. 5+50
BM #14
12" Elm
Elev. 69.54
Sta. 3+77 12" CMP 61'55" Lt.
Sta. 69+50 Lt.
Construct Approach
Sta. 84+00 Lt.
Construct Approach
Town Road
Jerry Jon
ROLAND CORBIN
meadow
grape arbor
ROLAND CORBIN
ROLAND CORBIN
ROLAND CORBIN
South Hero
Grand Isle
Town Line
New 18" CGMPAC - 40' long
Construct Inlet & Outlet Ditches
Sta. 75+40
N 30° 19' W
Sta. 75+55 Rt.
Construct Drive
Sta. 76+12 Rt.
Construct Drive
Sta. 76+70 Rt.
Construct Drive
Shed
BM #13
Jordan Shedfield
Elev. 84.91
Δ - 60° 19' 12"
D - 10°
R - 573.7'
T - 333.3'
L - 603.2'
E - 69.9
Bank ½" per foot
Do not widen
DRIVES
75+50 Lt.
76+75 Rt.
78+00 Rt.
78+75 Rt.
81+00 Lt.
84+00 Lt.
Δ - 10° 30' Lt.
D - 5° 30'
R - 1037.3'
T - 150.2'
L - 309.5'
E - 7.3'
Bank ½" per foot
N 0° 30' W
75+00
300' VC.
93.40
-3.973 %
78+75
200' VC.
78.50
-1.986 %
82+25
150' VC.
71.55
-0.462 %
85+50
100' VC.
70.05
-1.800 %
87+75
100' VC.
66.00
-0.862 %
91+00
100' VC.
63.20
Sta. 75+00 - 91+00
Shaping Course of Stone Modified
BM #13 Spot on shed foh 98' Rt of sta 76+68 Elev. 84.91
BM #14 J.I.R. 12" Elm 21' Lt of sta 4+07 Lake Shore Road Elev. 69.54
SOUTH HERO - GRAND ISLE
Series S no. 67 (2)
Sheet 10 of 37 Sheets

7