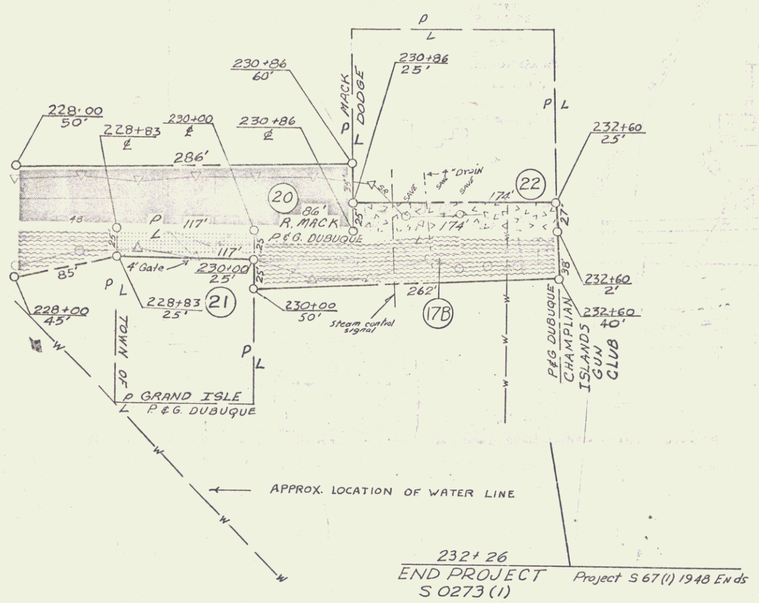

5

#314

0' 50' 100' 150'

VERMONT DEPARTMENT OF HIGHWAYS
RIGHT - OF - WAY PLANS
PROJECT: GRAND ISLE
No. S 0273(1)
SHEET 15 OF 23
Revised 11/12/69

17