RED. LEAD DIST. NO.	STATE	PROJ. NO.	FISCAL YEAR	SHEET NO.	TOTAL SHEETS
5	VT	67(1)	1947	6	22

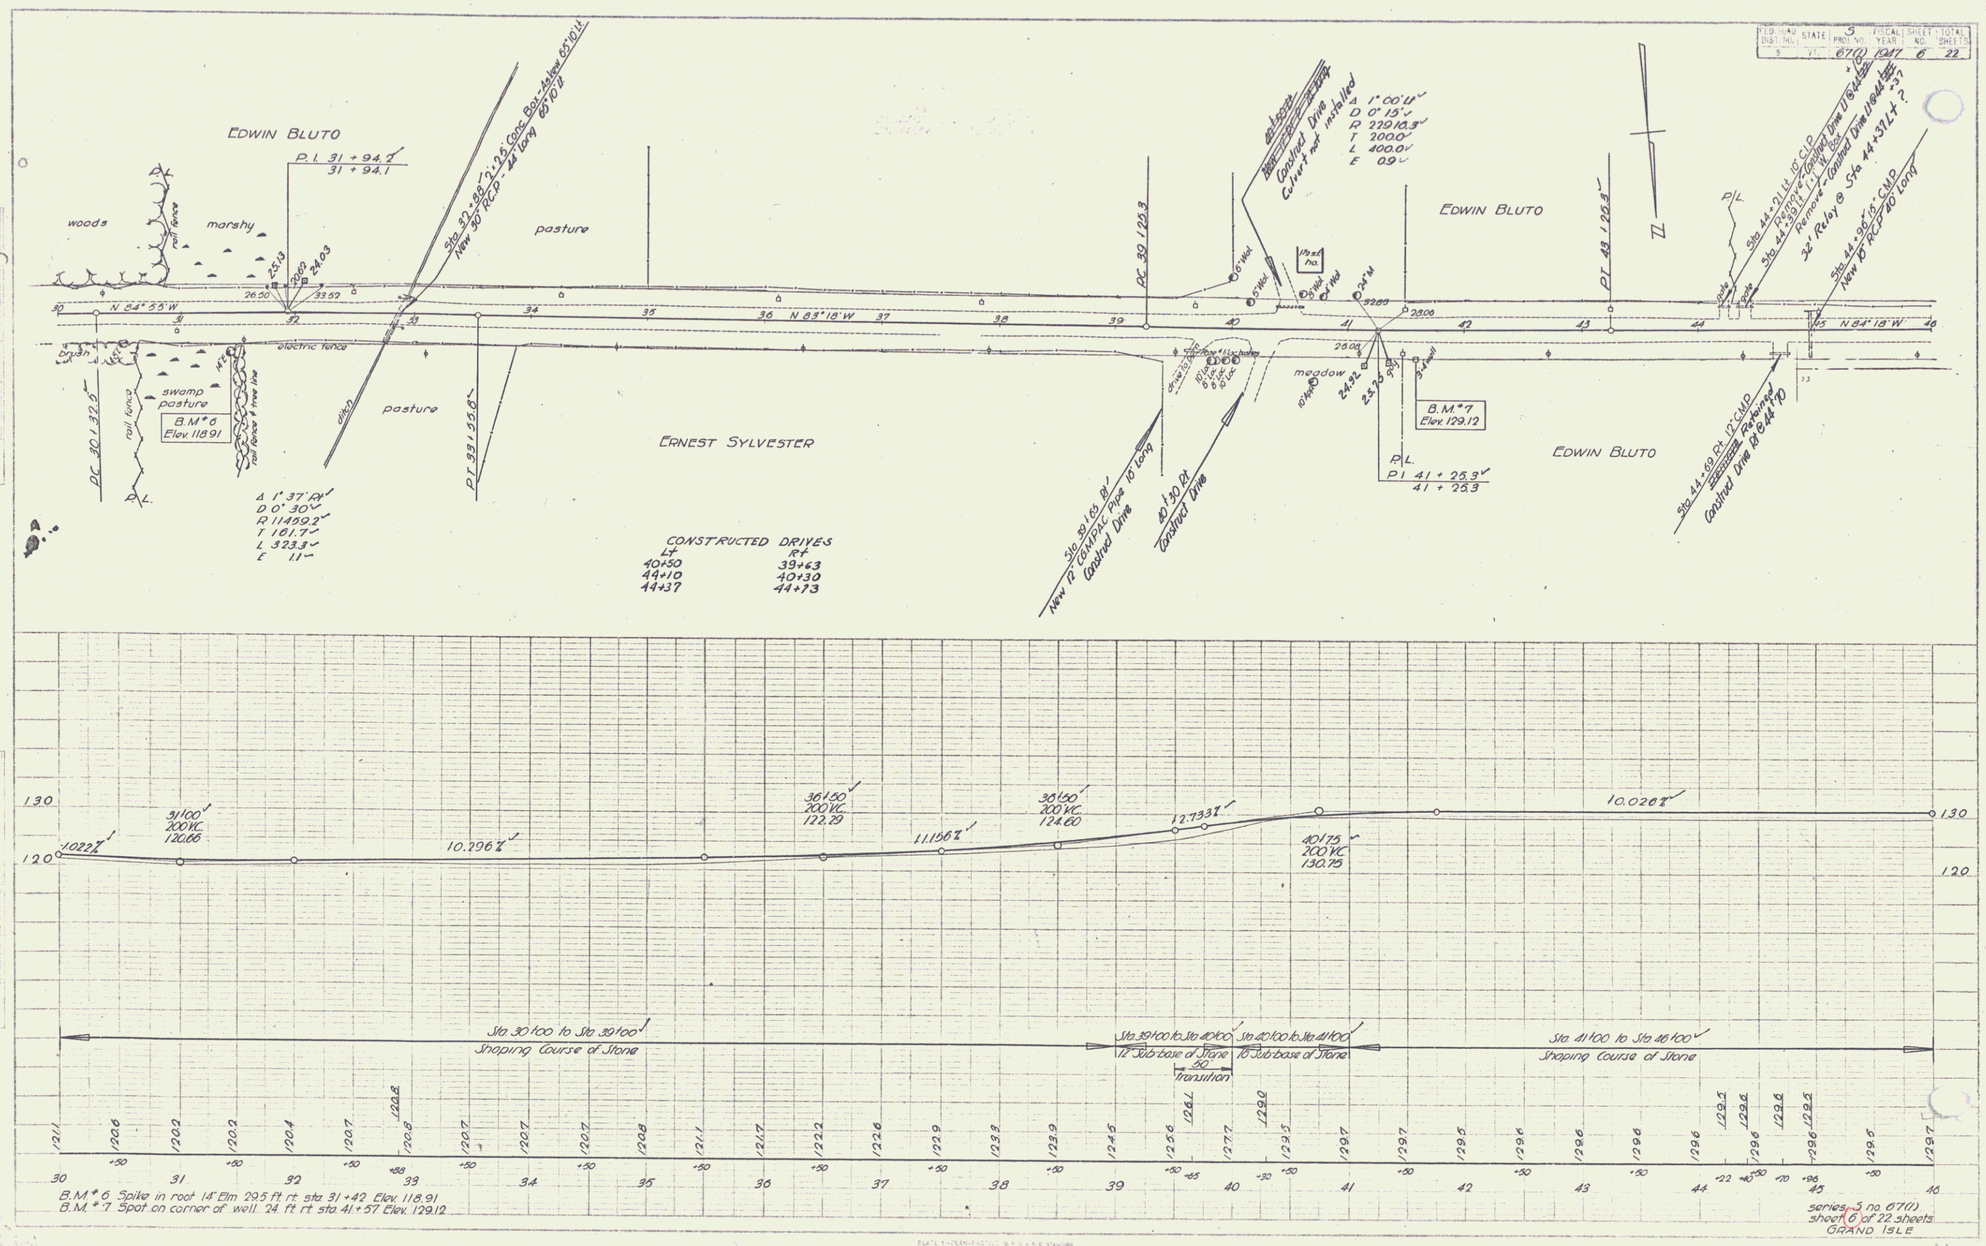

B.M. #6 Spike in root 14" Elm 29.5 ft. rt. sta. 31+42 Elev. 118.91
B.M. #7 Spot on corner of well 24 ft. rt. sta. 41+57 Elev. 129.12

series 5 no. 67(1)
sheet 6 of 22 sheets
GRAND ISLE

4