FED. AID DIV. NO.	STATE	S PROJ. NO.	FISCAL YEAR	SHEET NO.	TOTAL SHEETS
5	VT.	67(1)	1947	7	22

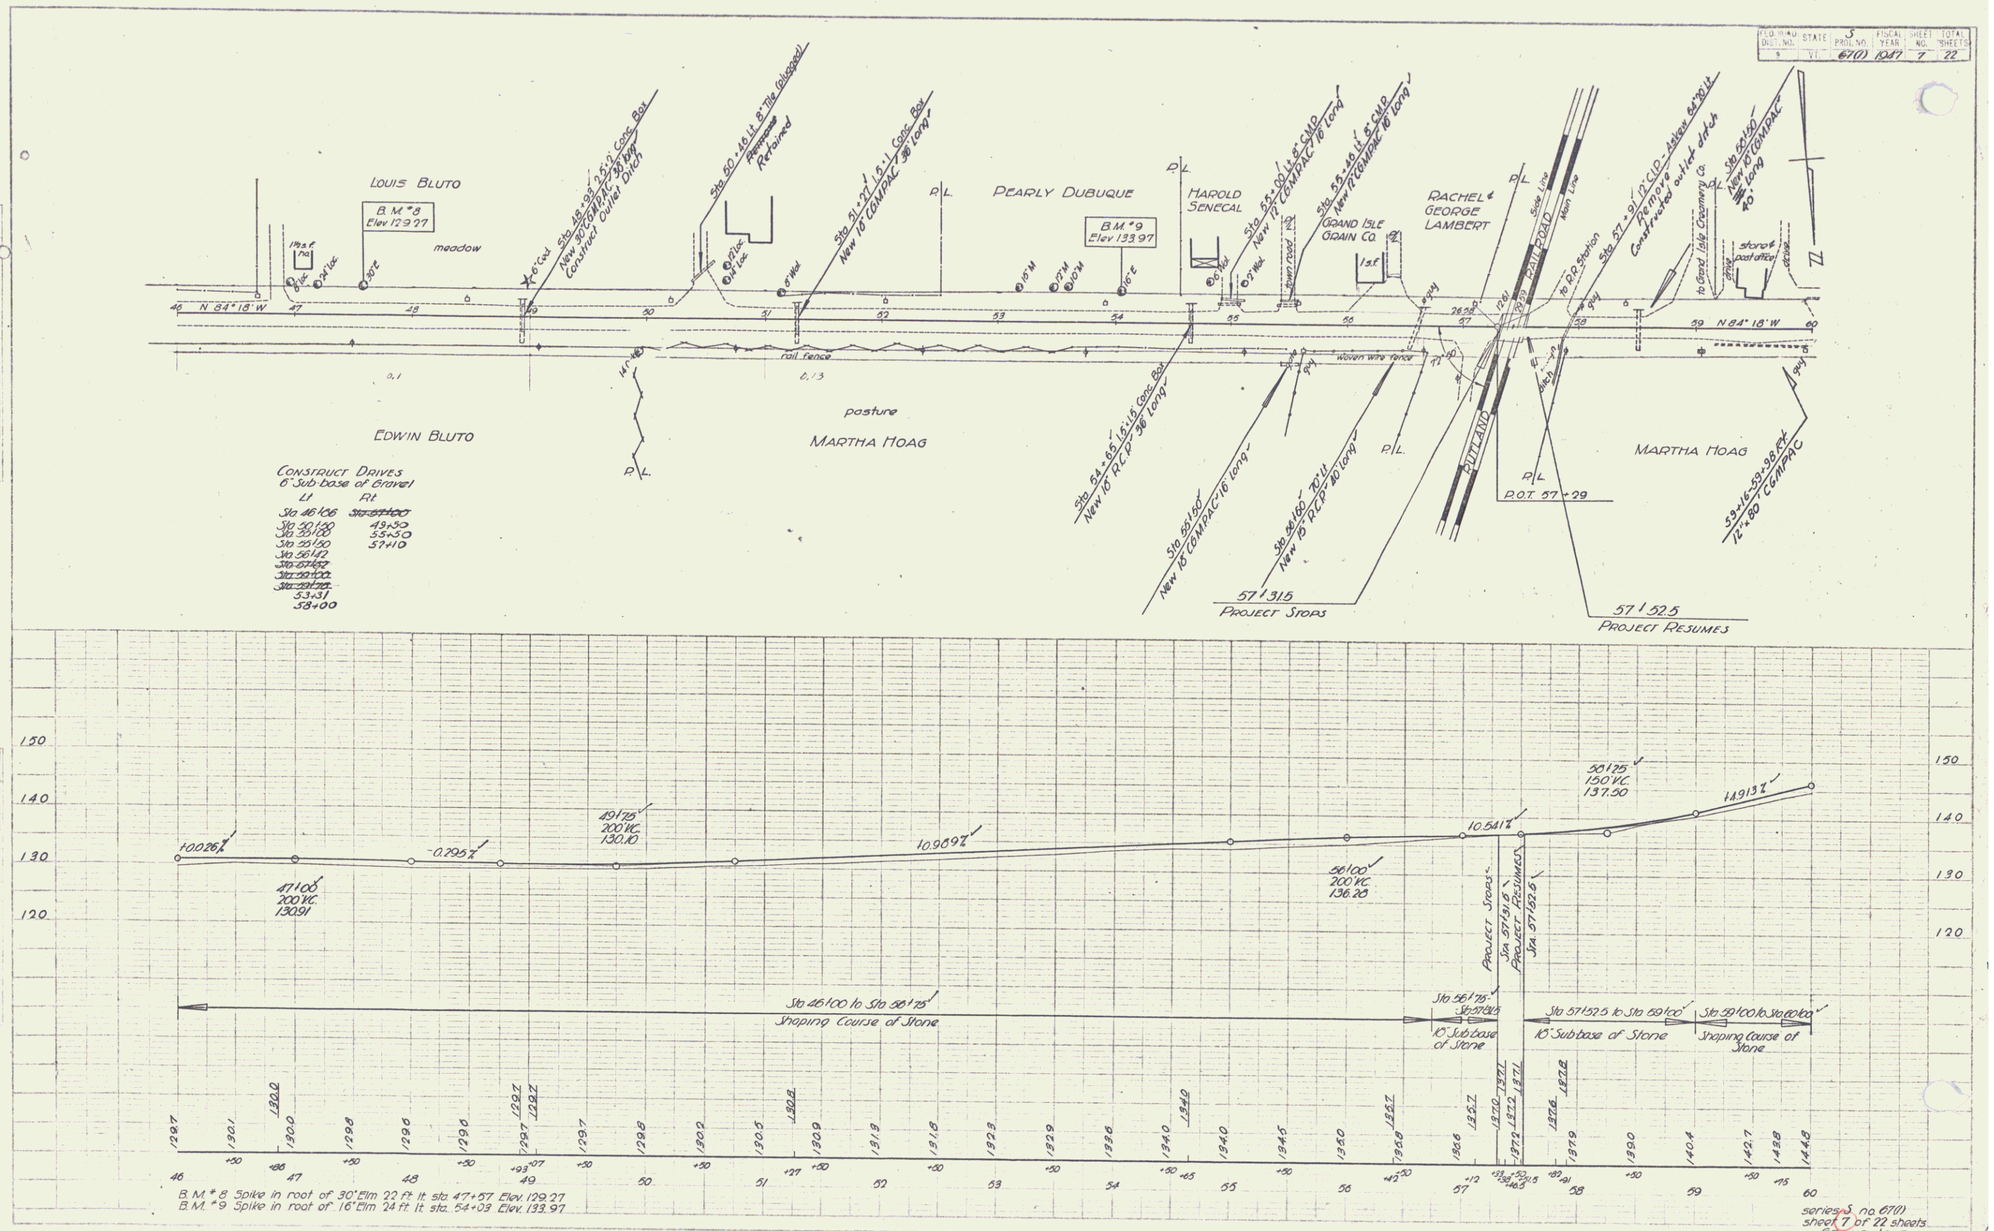

series S no. 67(1)
sheet 7 of 22 sheets
GRAND ISLE

5