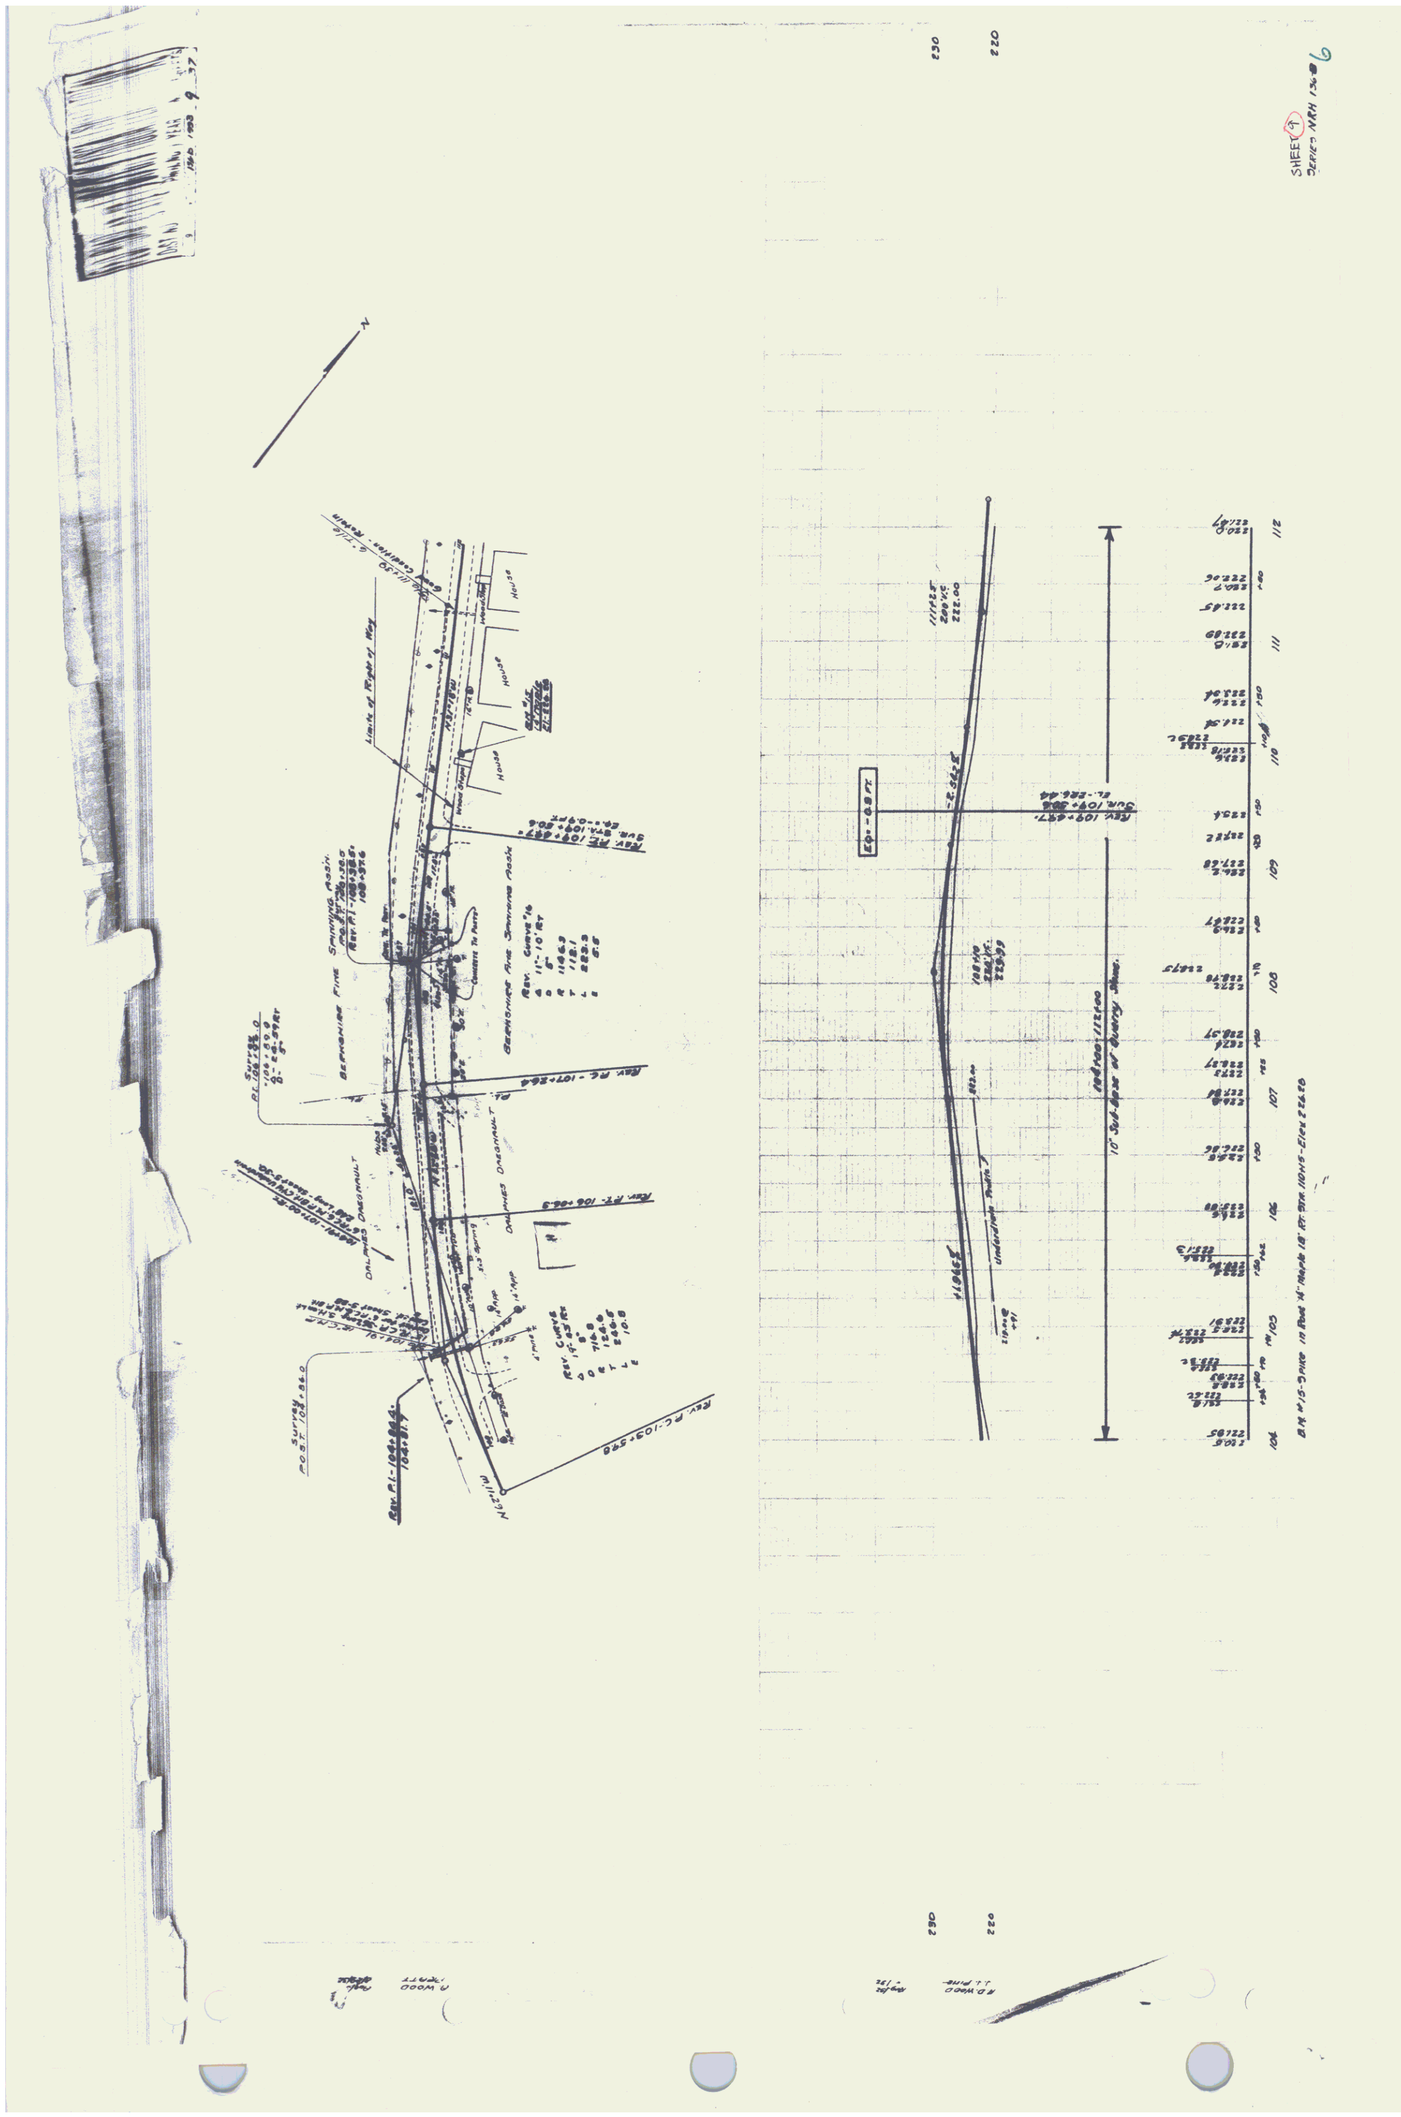
SERIES NRN 136-6
Limits of Right of Way
HOUSE
HOUSE
HOUSE
Wood Shed
Rev. Curve Data
Rev. PC-107+26.4
Rev. PT-106+06.3
Rev. PI-104+94.4
104+81.4
Rev. PC-103+57.8
Rev. PI-107+26.4
Rev. PC-107+26.4
Rev. PT-106+06.3
Rev. PC-103+57.8
Rev. 107+67
Sub. 109+28.8
EL-226.44
Rev. 107+67
Sub. 109+28.8
EL-0.9 FT
10" Sub-drain or Quarry Run.
Undercut Sub-grade
