CROSSING REMOVED

FED. AID DIST. NO.	STATE	W.P.&H. FAC. NO.	FISCAL YEAR	SHEET NO.	TOTAL SHEETS
3	VT.	136-C	1936	2	6

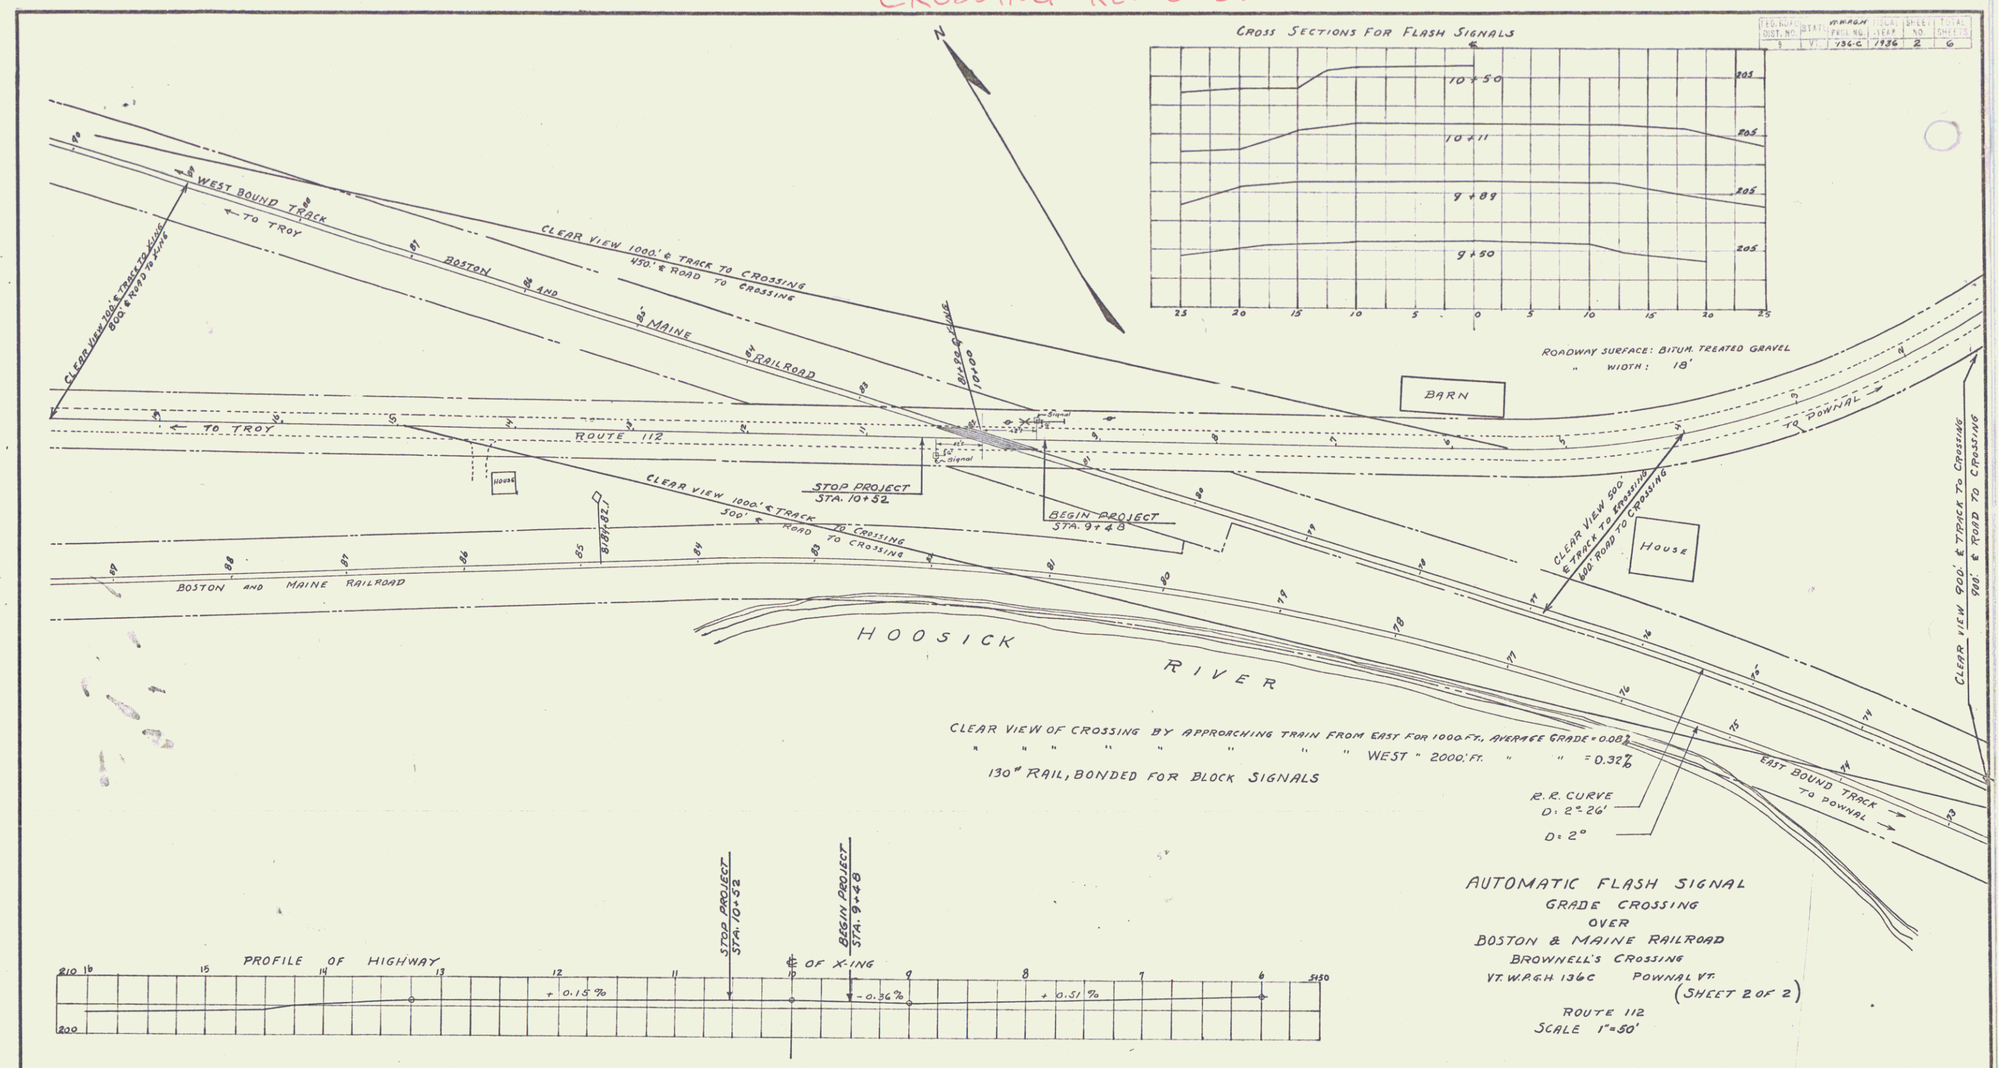

AUTOMATIC FLASH SIGNAL
GRADE CROSSING
OVER
BOSTON & MAINE RAILROAD
BROWNELL'S CROSSING
VT. W.P.&H. 136C POWNAL VT.
(SHEET 2 OF 2)

ROUTE 112
SCALE 1"=50'

GRADE CROSSING NO. 1

ESTIMATED QUANTITIES

REQUIRED: 2 SIGNALS WITH WIRING

Surveyed by HOBSON
Designed by
Drawn by
Traced by A.R.CRAM 8/16/36
Checked by
Series W.P.&H. No. 136-C Filed
Sheet 2 of 6 Sheets

2