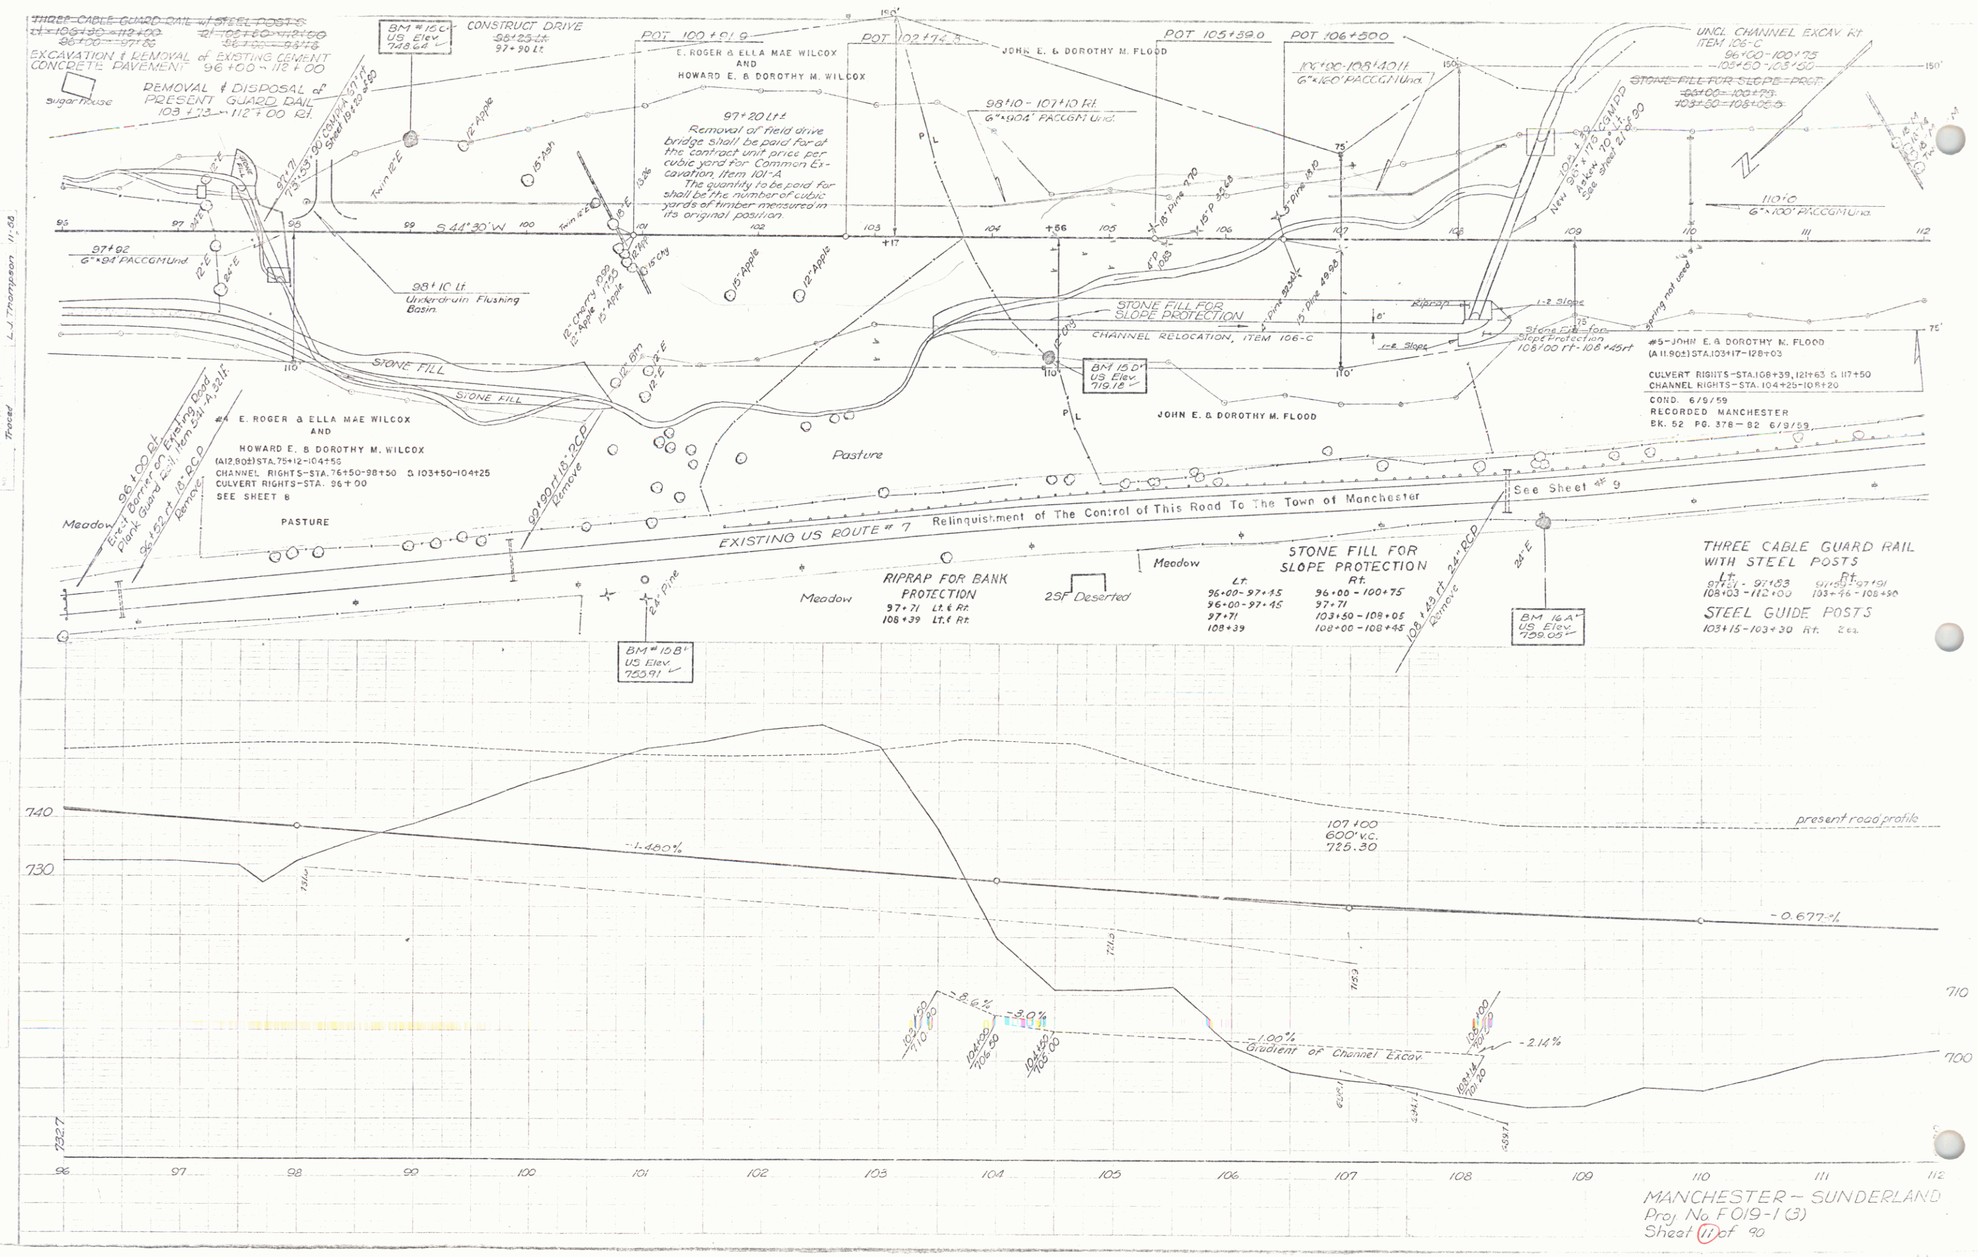

MANCHESTER - SUNDERLAND
Proj. No. F019-1(3)
Sheet 11 of 90

4