


SCALE 8 3/4" = 1"

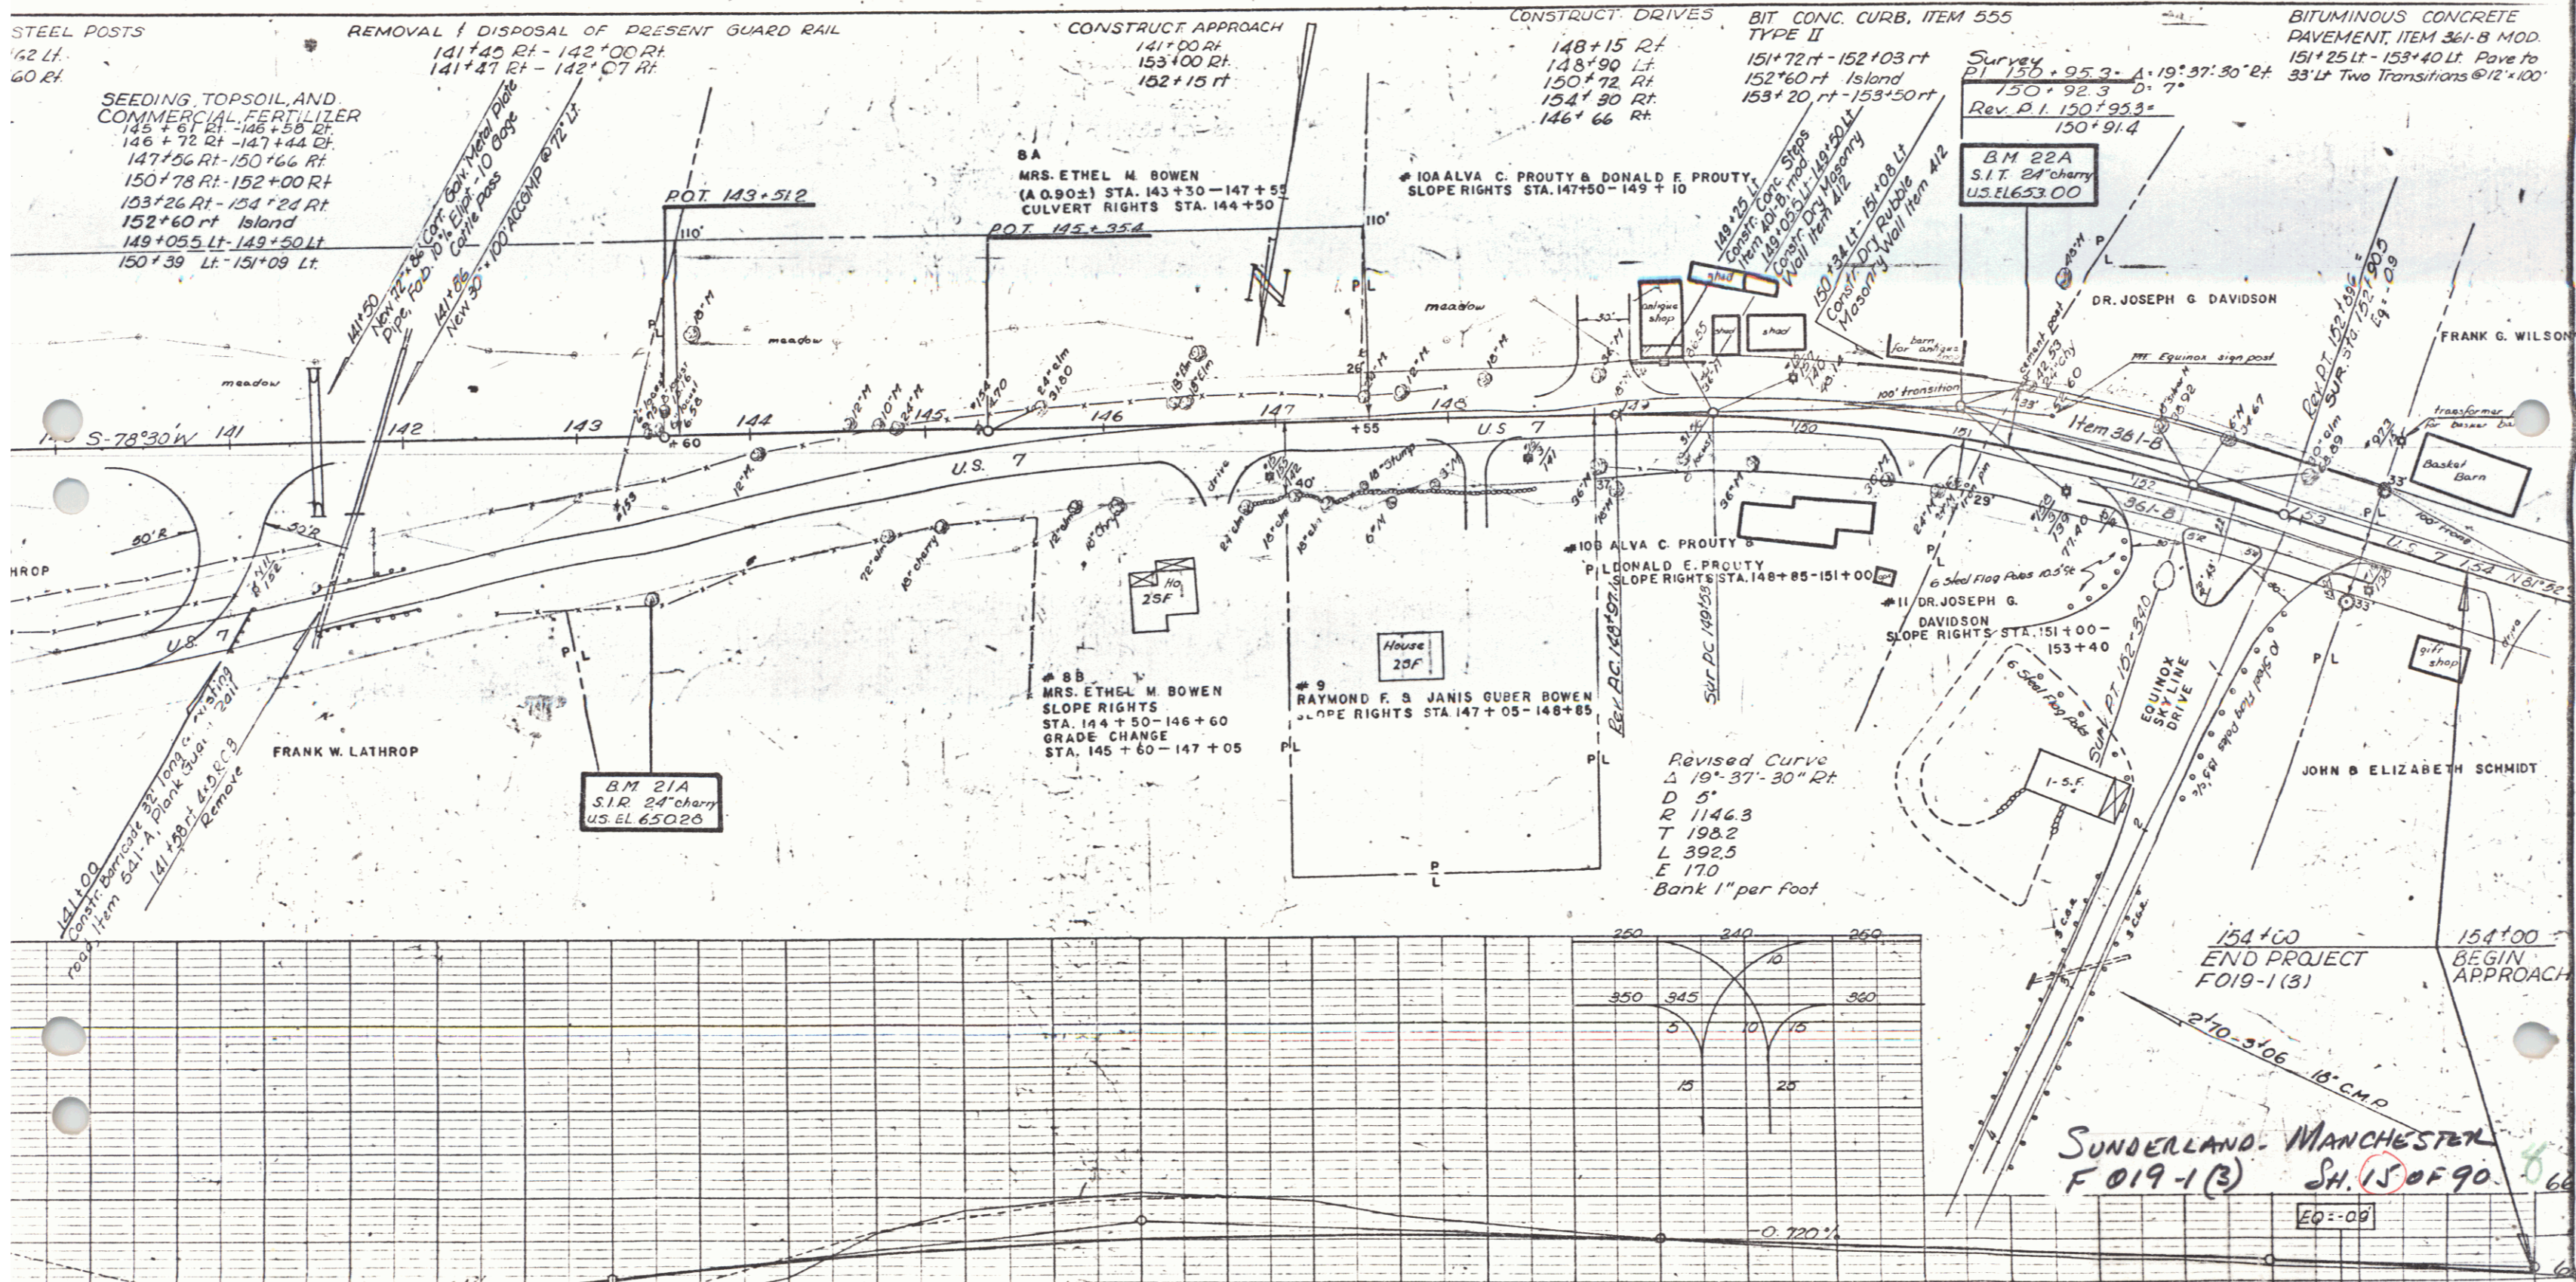

SUNDERLAND-MANCHESTER
F 019-1(3) SH. 15 OF 90
EQ-00