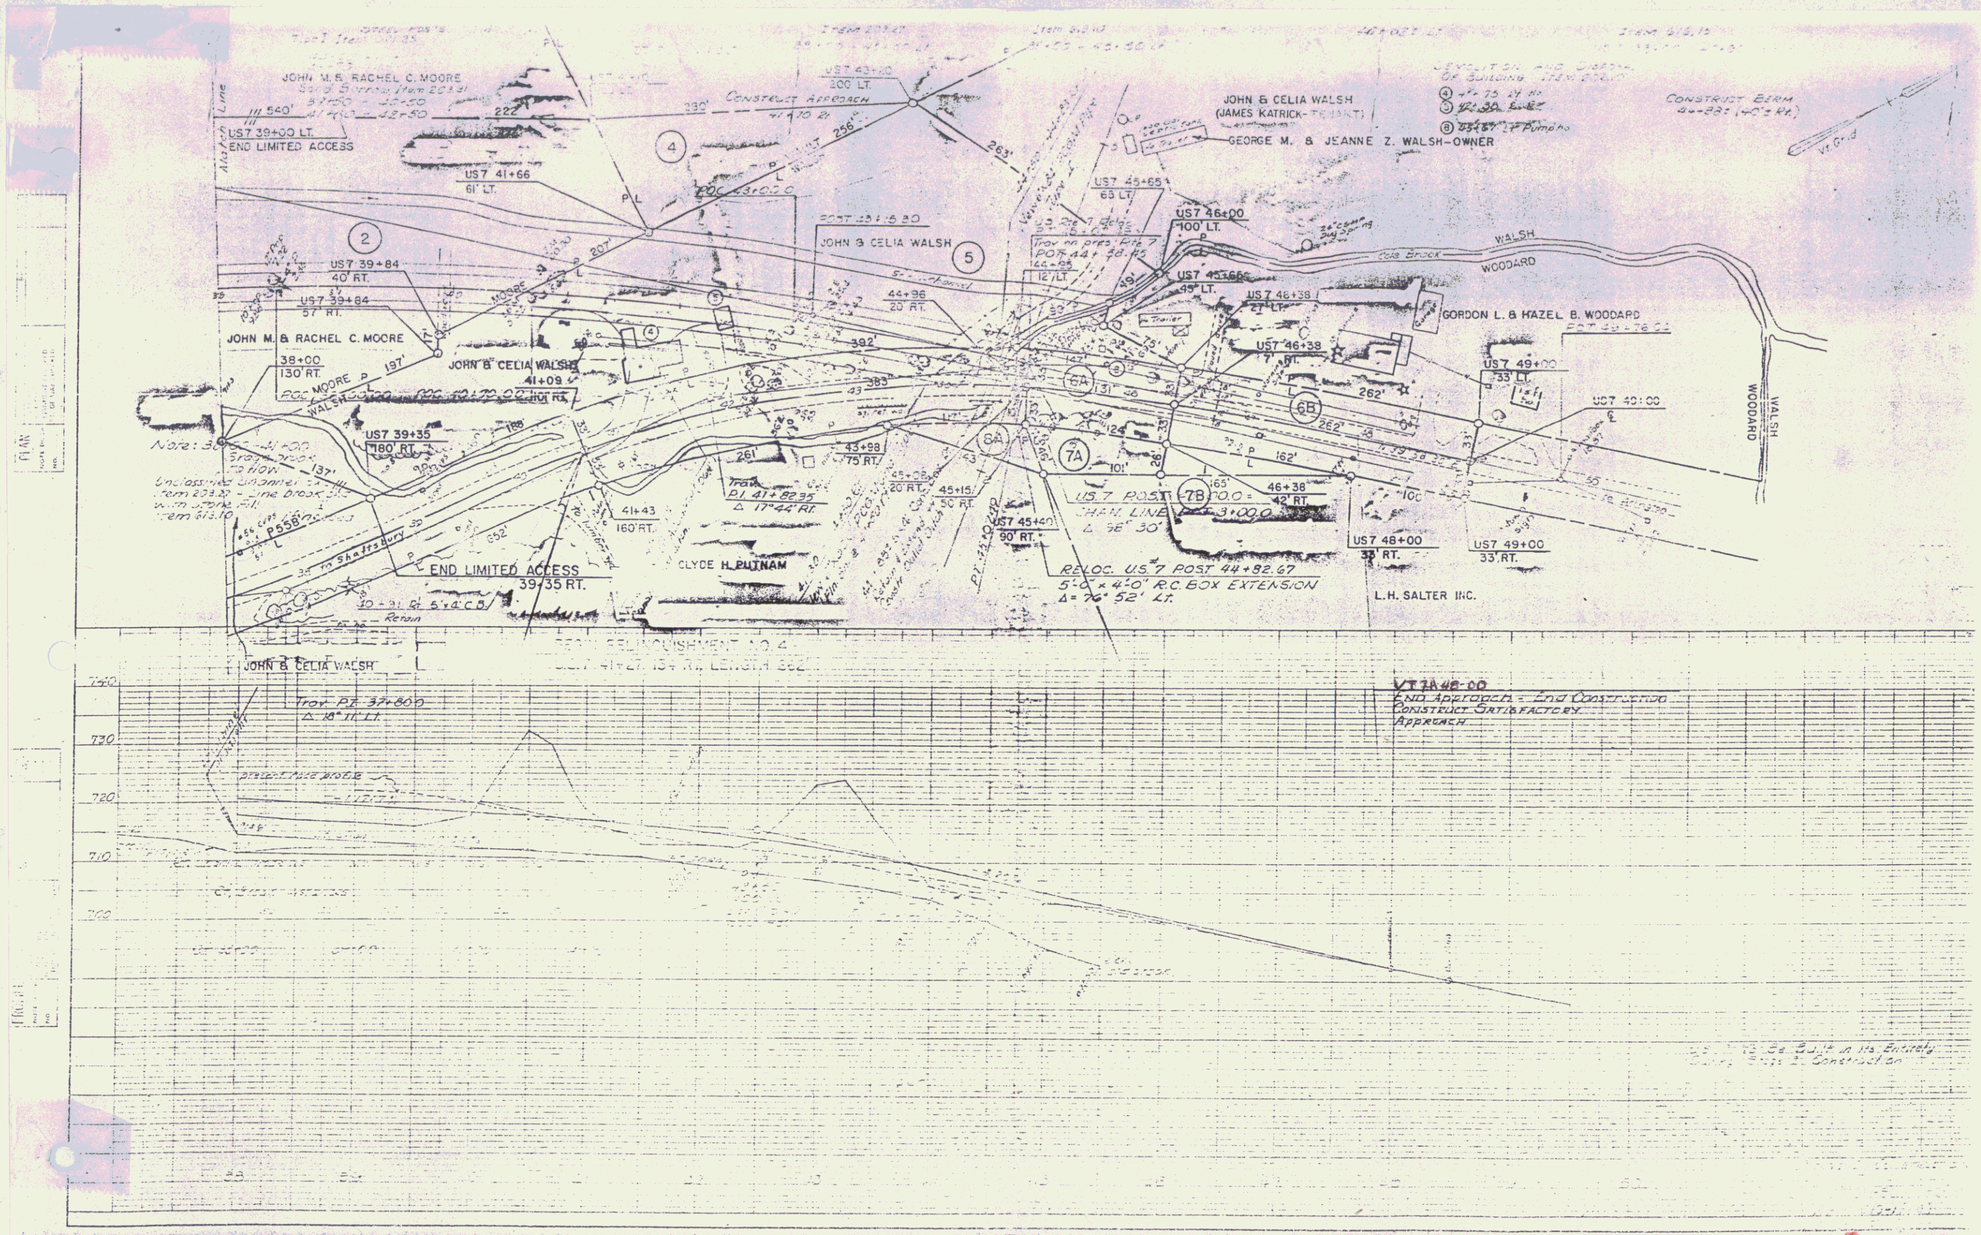
JOHN M. & RACHEL C. MOORE
US7 39+00 LT.
END LIMITED ACCESS
CONSTRUCT APPROACH
US7 43+00
200' LT.
JOHN & CELIA WALSH
(JAMES KATRICK-TENANT)
GEORGE M. & JEANNE Z. WALSH-OWNER
CONSTRUCT BERM
US7 41+66
61' LT.
US7 45+65
63 LT.
US7 46+00
100' LT.
US7 45+66
45' LT.
US7 46+38
21' LT.
US7 39+84
40' RT.
US7 39+84
57' RT.
JOHN & CELIA WALSH
44+96
20 RT.
WALSH
WOODARD
GORDON L. & HAZEL B. WOODARD
38+00
130' RT.
JOHN & CELIA WALSH
41+09
US7 46+38
71' RT.
US7 49+00
33' LT.
US7 40+00
US7 39+35
180' RT.
43+98
75' RT.
45+08
20' RT.
45+15
50' RT.
41+43
160' RT.
US7 POST
46+38
42' RT.
US7 45+40
90' RT.
US7 48+00
33' RT.
US7 49+00
33' RT.
END LIMITED ACCESS
39+35 RT.
CLYDE H. PUTNAM
RELOC. US.7 POST 44+82.67
5'-0" x 4'-0" R.C. BOX EXTENSION
L.H. SALTER INC.
JOHN & CELIA WALSH
VT 7A 42.00
END APPROACH = END CONSTRUCTION
CONSTRUCT SATISFACTORY
APPROACH
Sheet 14 of 27

4