FED. ROAD DIST. NO.	STATE	FED. AID PROJ. NO.	FISCAL YEAR	SHEET NO.	TOTAL SHEETS
9	VT	26	1921	10	53

GUARD RAIL REQUIRED

ON LEFT

Sta. 109+37 to Sta. 110+01 Length 64 ft.
" 110+23 " " 111+19 " 96 "
" 117+64 " " 118+72 " 108 "
" 120+72 " " 120+96 " 24 "

ON RIGHT

" 109+95 to Sta. 110+11 " 16 "
" 110+33 " " 111+21 " 88 "
" 117+64 " " 118+72 " 108 "
" 120+72 " " 120+96 " 24 "

TOTAL THIS SHEET 528 "

NEW CULVERTS REQUIRED

Sta. 118+36 16" Corr. I.P. 40 ft
1-2½-5 Concrete 1.5 cu. yds.

CULVERT REPAIRS REQUIRED

Sta. 120+82 18" x 21" Concrete Box
1-2-4 Concrete 0.3 cu. yds.

SUB BASE REQUIRED

Sta. 106+00 to Sta. 108+75 Length 275 ft.
" 111+50 " " 115+50 " 400 "

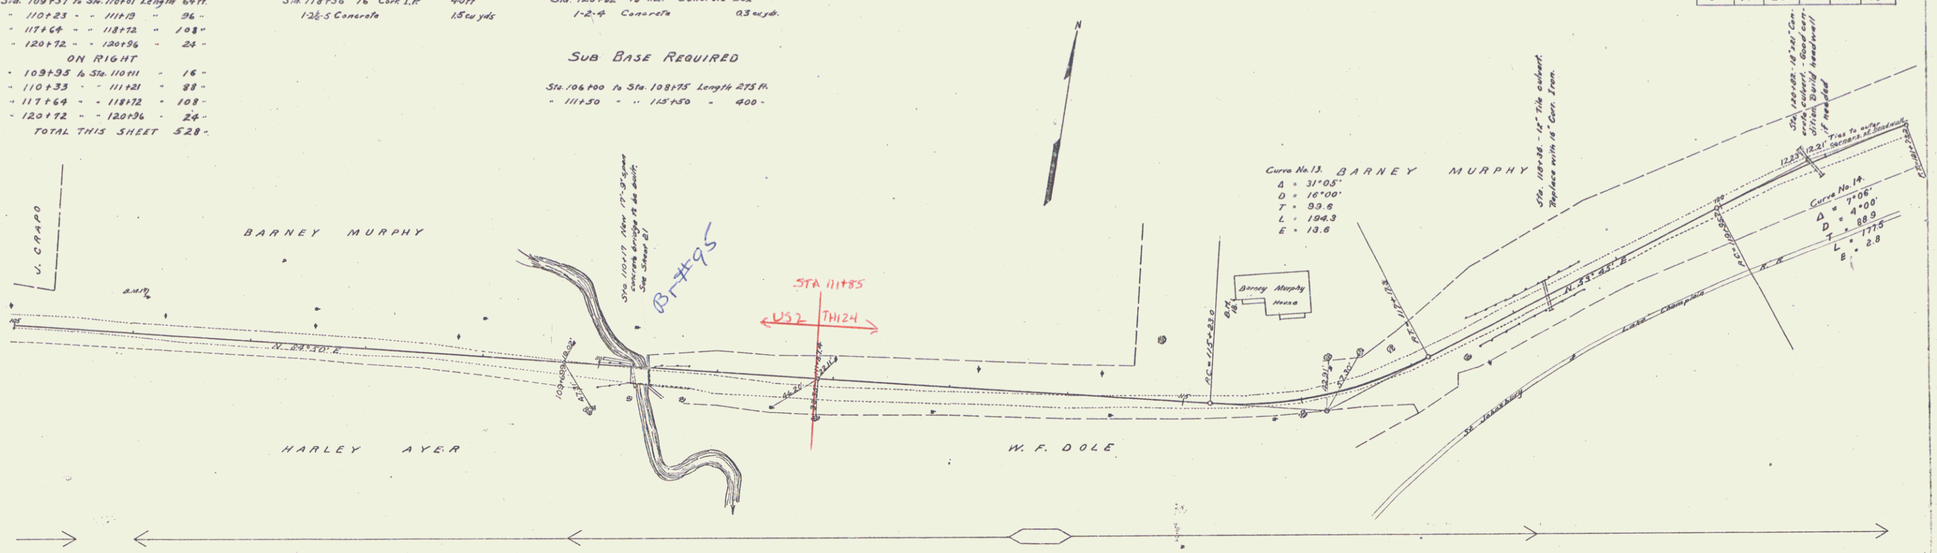

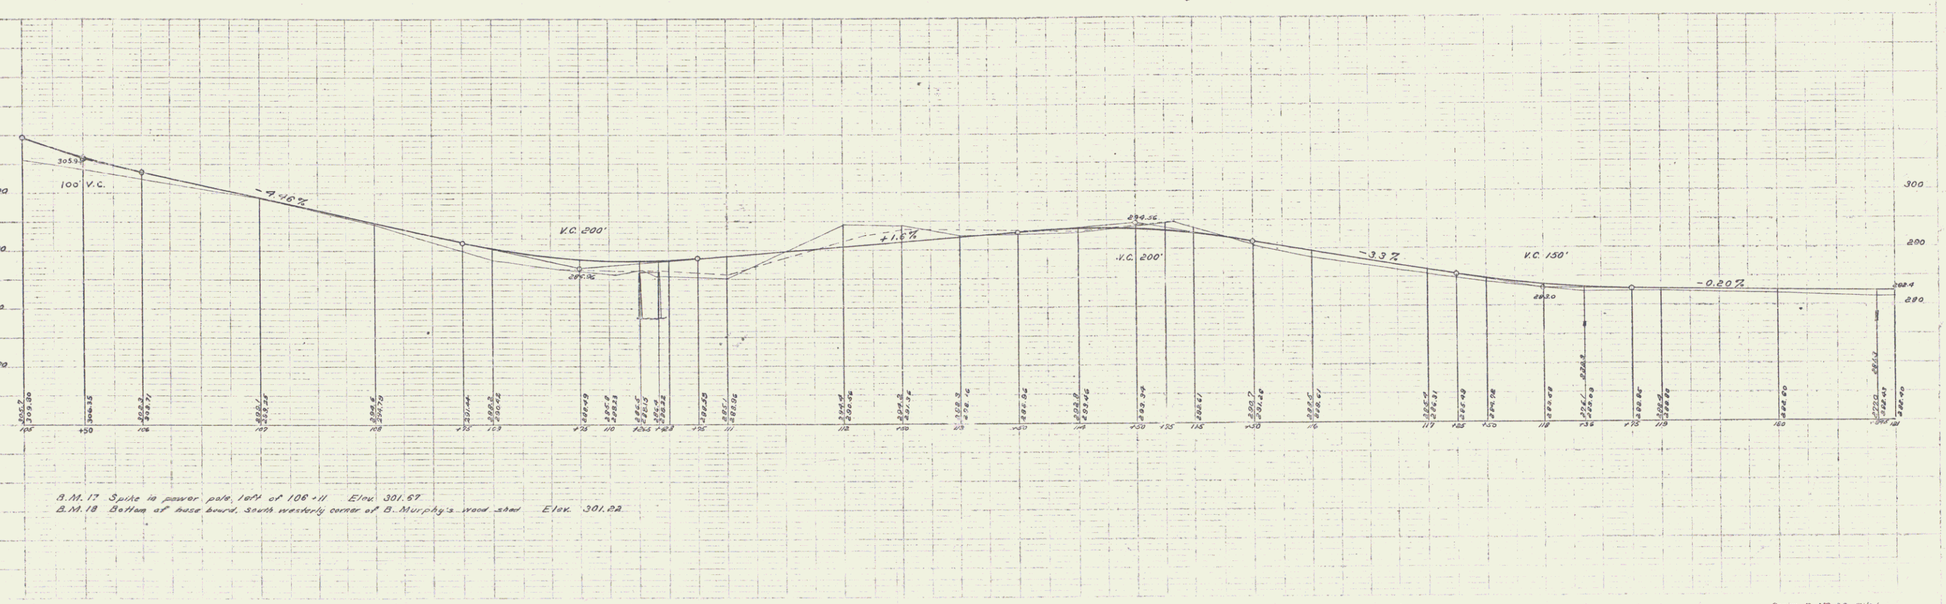

B.M. 17 Spike in power pole, left of 108+11 Elev. 301.67
B.M. 18 Bottom of base board, south westerly corner of B. Murphy's wood shed Elev. 301.22

Sheet 10 of 53

12