FED. ROAD DIST. NO.	STATE	FED. AID PROJ. NO.	FISCAL YEAR	SHEET NO.	TOTAL SHEETS
9	VT.	26	1921	13	53

GUARD RAIL REQUIRED

ON LEFT

Sta. 150+00 to Sta. 151+19 Length 119 ft.
- 161+36 - - 165+96 - 400 -

ON RIGHT

- 150+00 to Sta. 150+27 - 27 -
- 162+72 - - 166+00 - 328 -
TOTAL THIS SHEET 874 -

NEW CULVERTS REQUIRED

Sta. 150+03	18" Corr. I.P.	40 ft.	
1-2½-5 Concrete		1.5 cu yds.	
Sta. 164+98	2' x 2' Concrete Box		
1-2-4 Concrete		9.5 cu yds.	
1-2½-5	"	11.1 "	

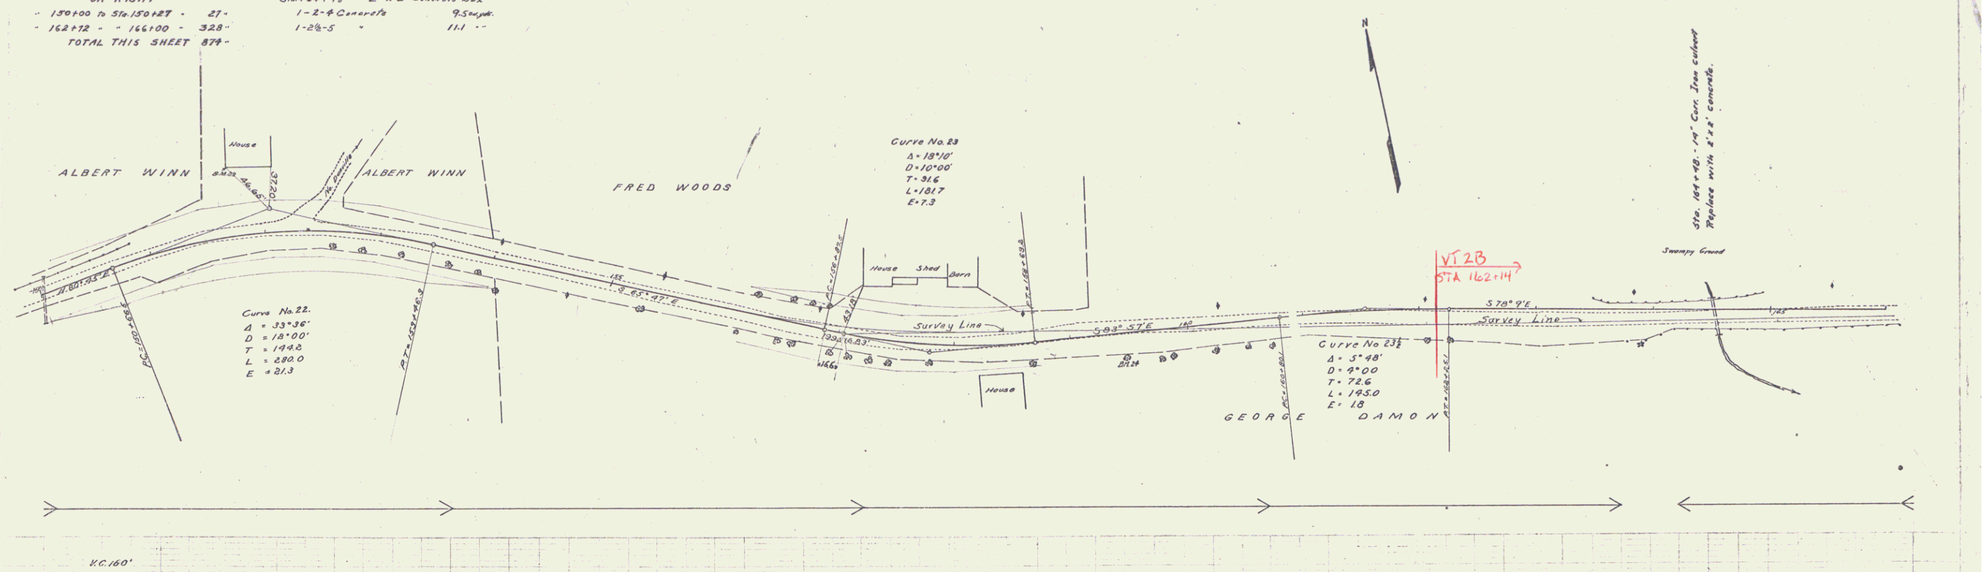

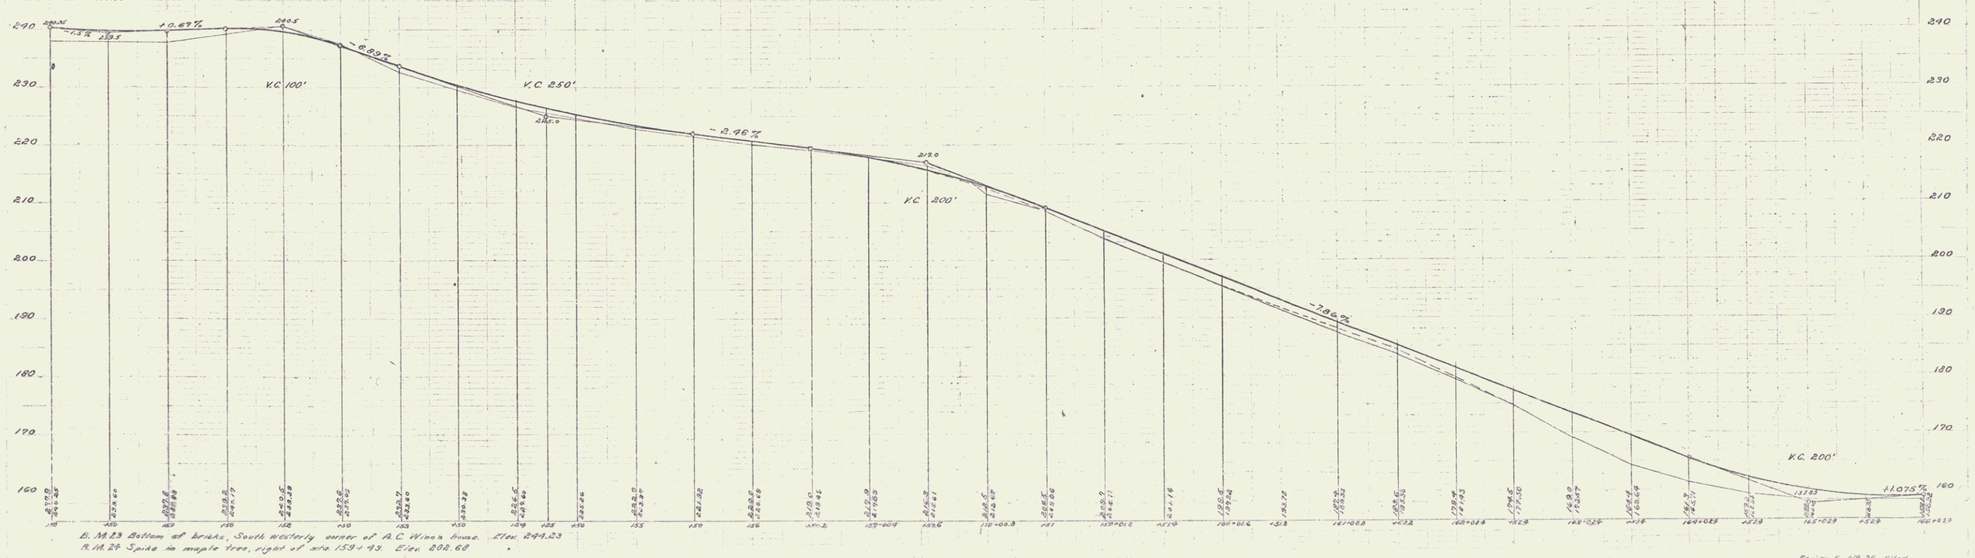

Series F 26-26, Filed
Sheet 13 of 53

15