

FED. ROAD DIST. NO.	STATE	PROJECT NO.	YEAR	SHEET NO.	TOTAL SHEETS
118 A	VA	118 A	1928	3	24


WOOD GUARD RAIL REQUIRED
 ON LEFT
 9+33 " 9+57 " 24 FT
RIGHT
 " 9+33 " 9+57 " 24 FT

NEW CULVERTS REQUIRED



STA. 0+00
 BEGINNING OF PROJECT

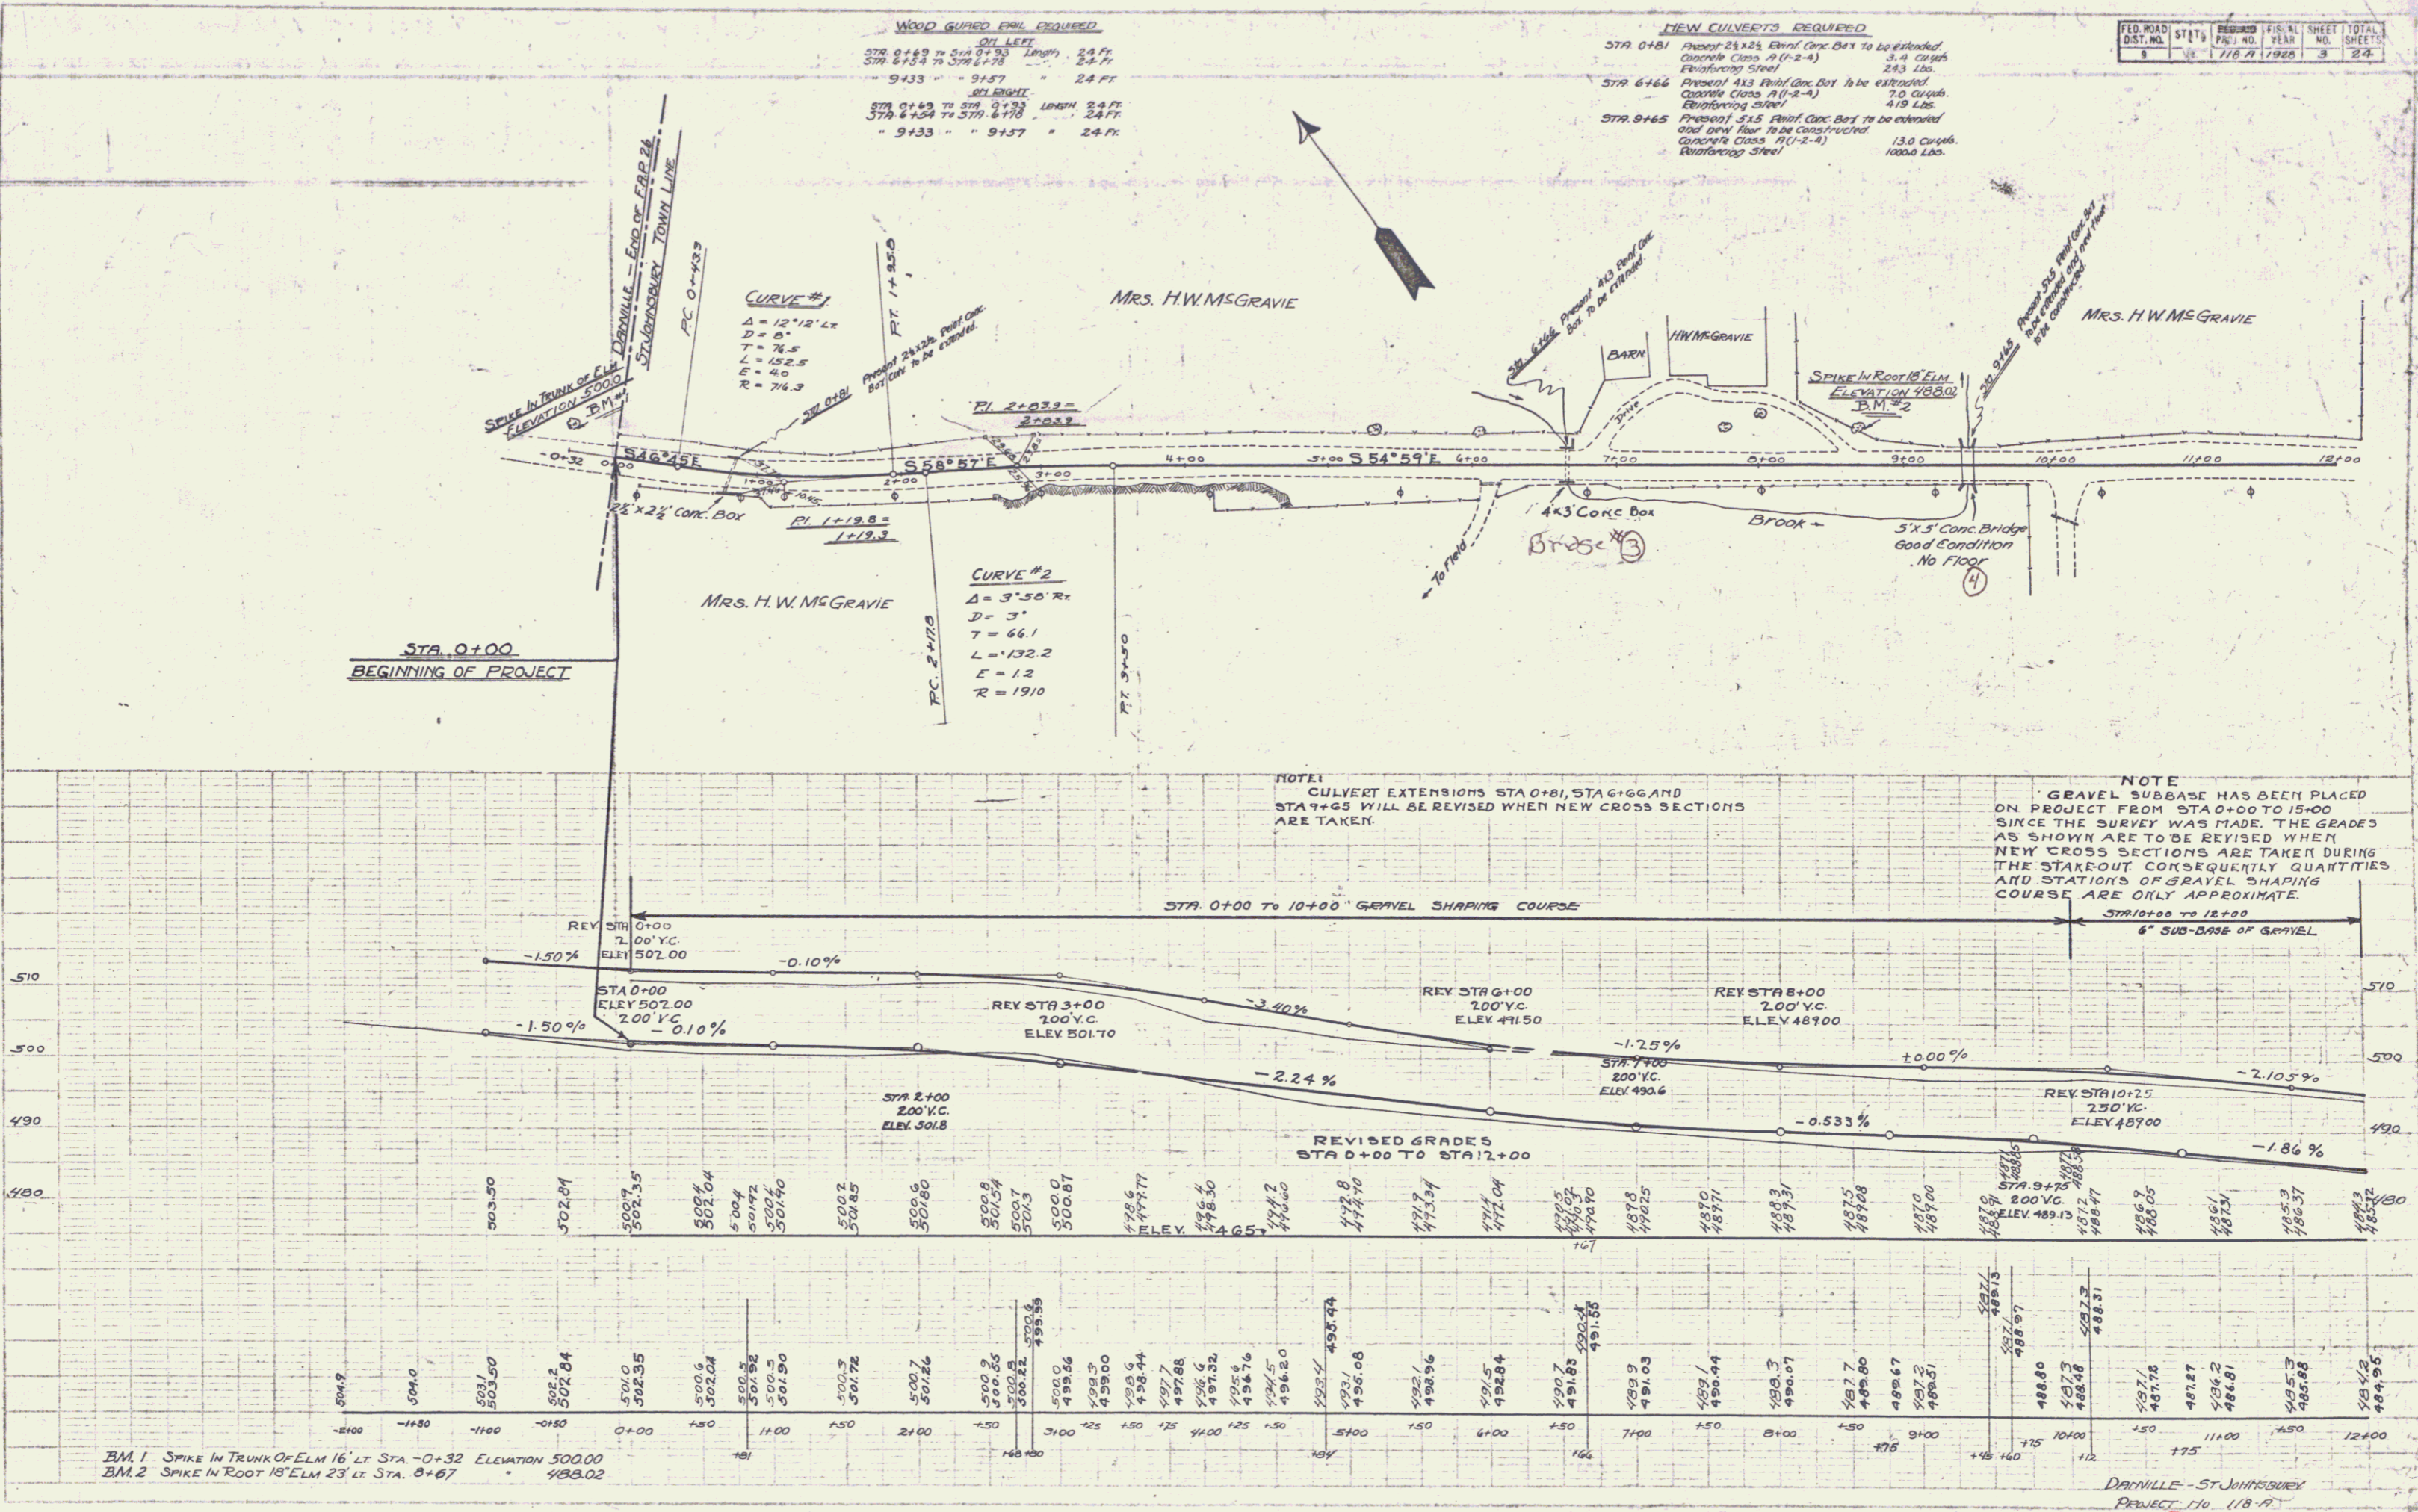

BM. 1 SPIKE IN TRUNK OF ELM 16' LT STA. -0+32 ELEVATION 500.00
 BM. 2 SPIKE IN ROOT 18' ELM 23' LT STA. 0+67 ELEVATION 488.02

 PROJECT NO. 118 A
 SHEET 3 of 24