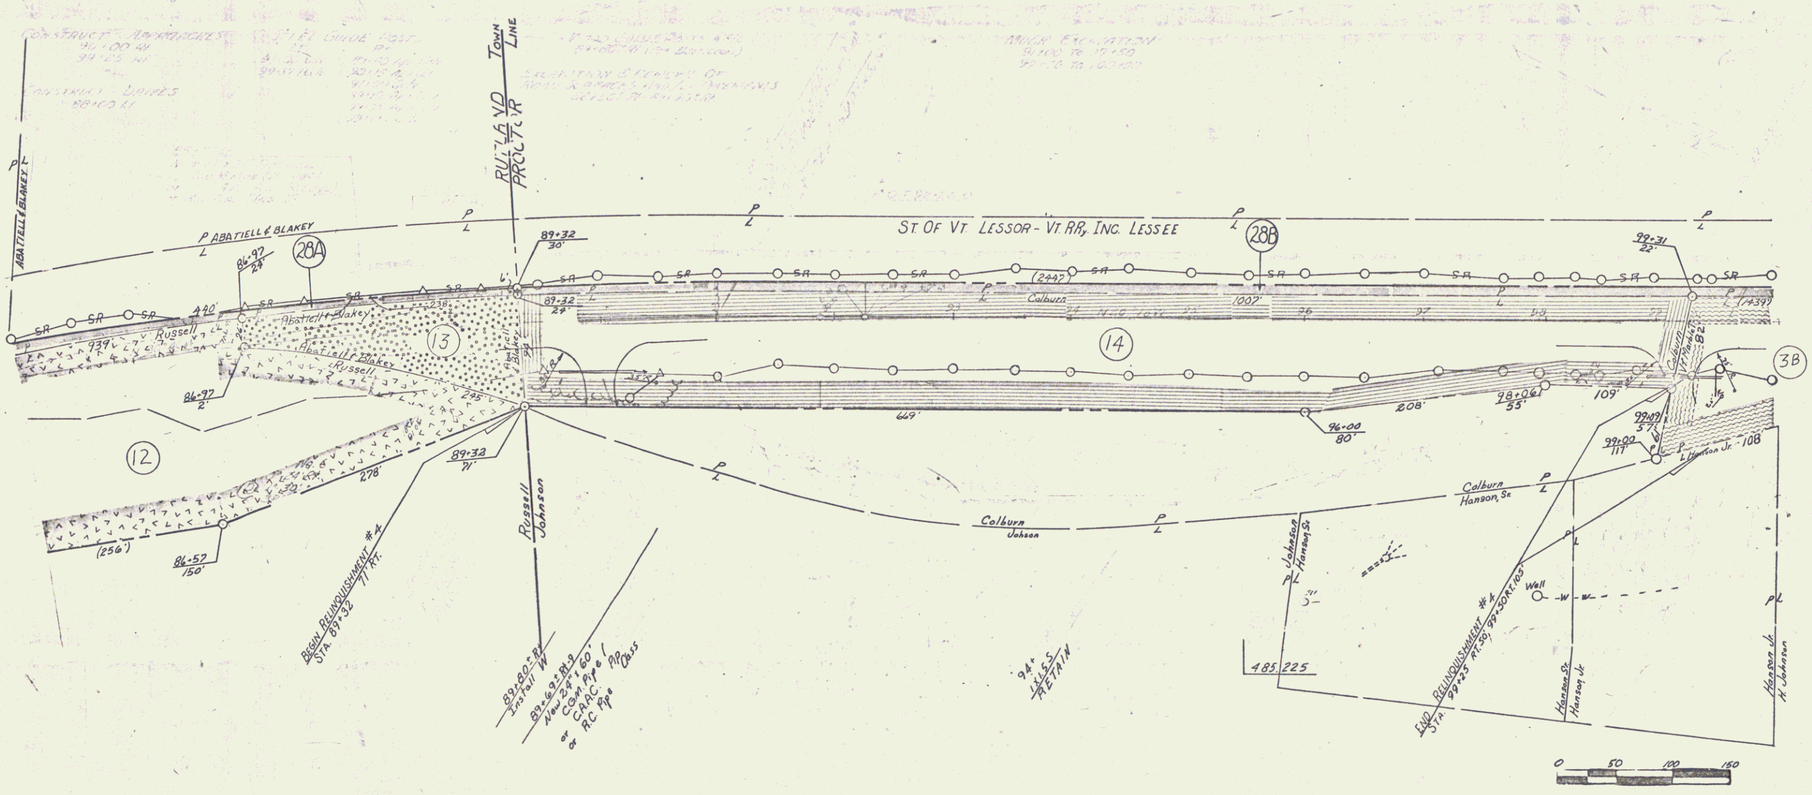

VERMONT DEPARTMENT OF HIGHWAYS

RIGHT - OF - WAY PLANS

PROJECT: RUTLAND - PROCTOR

NO 50163(1)

SHEET 23 OF 45