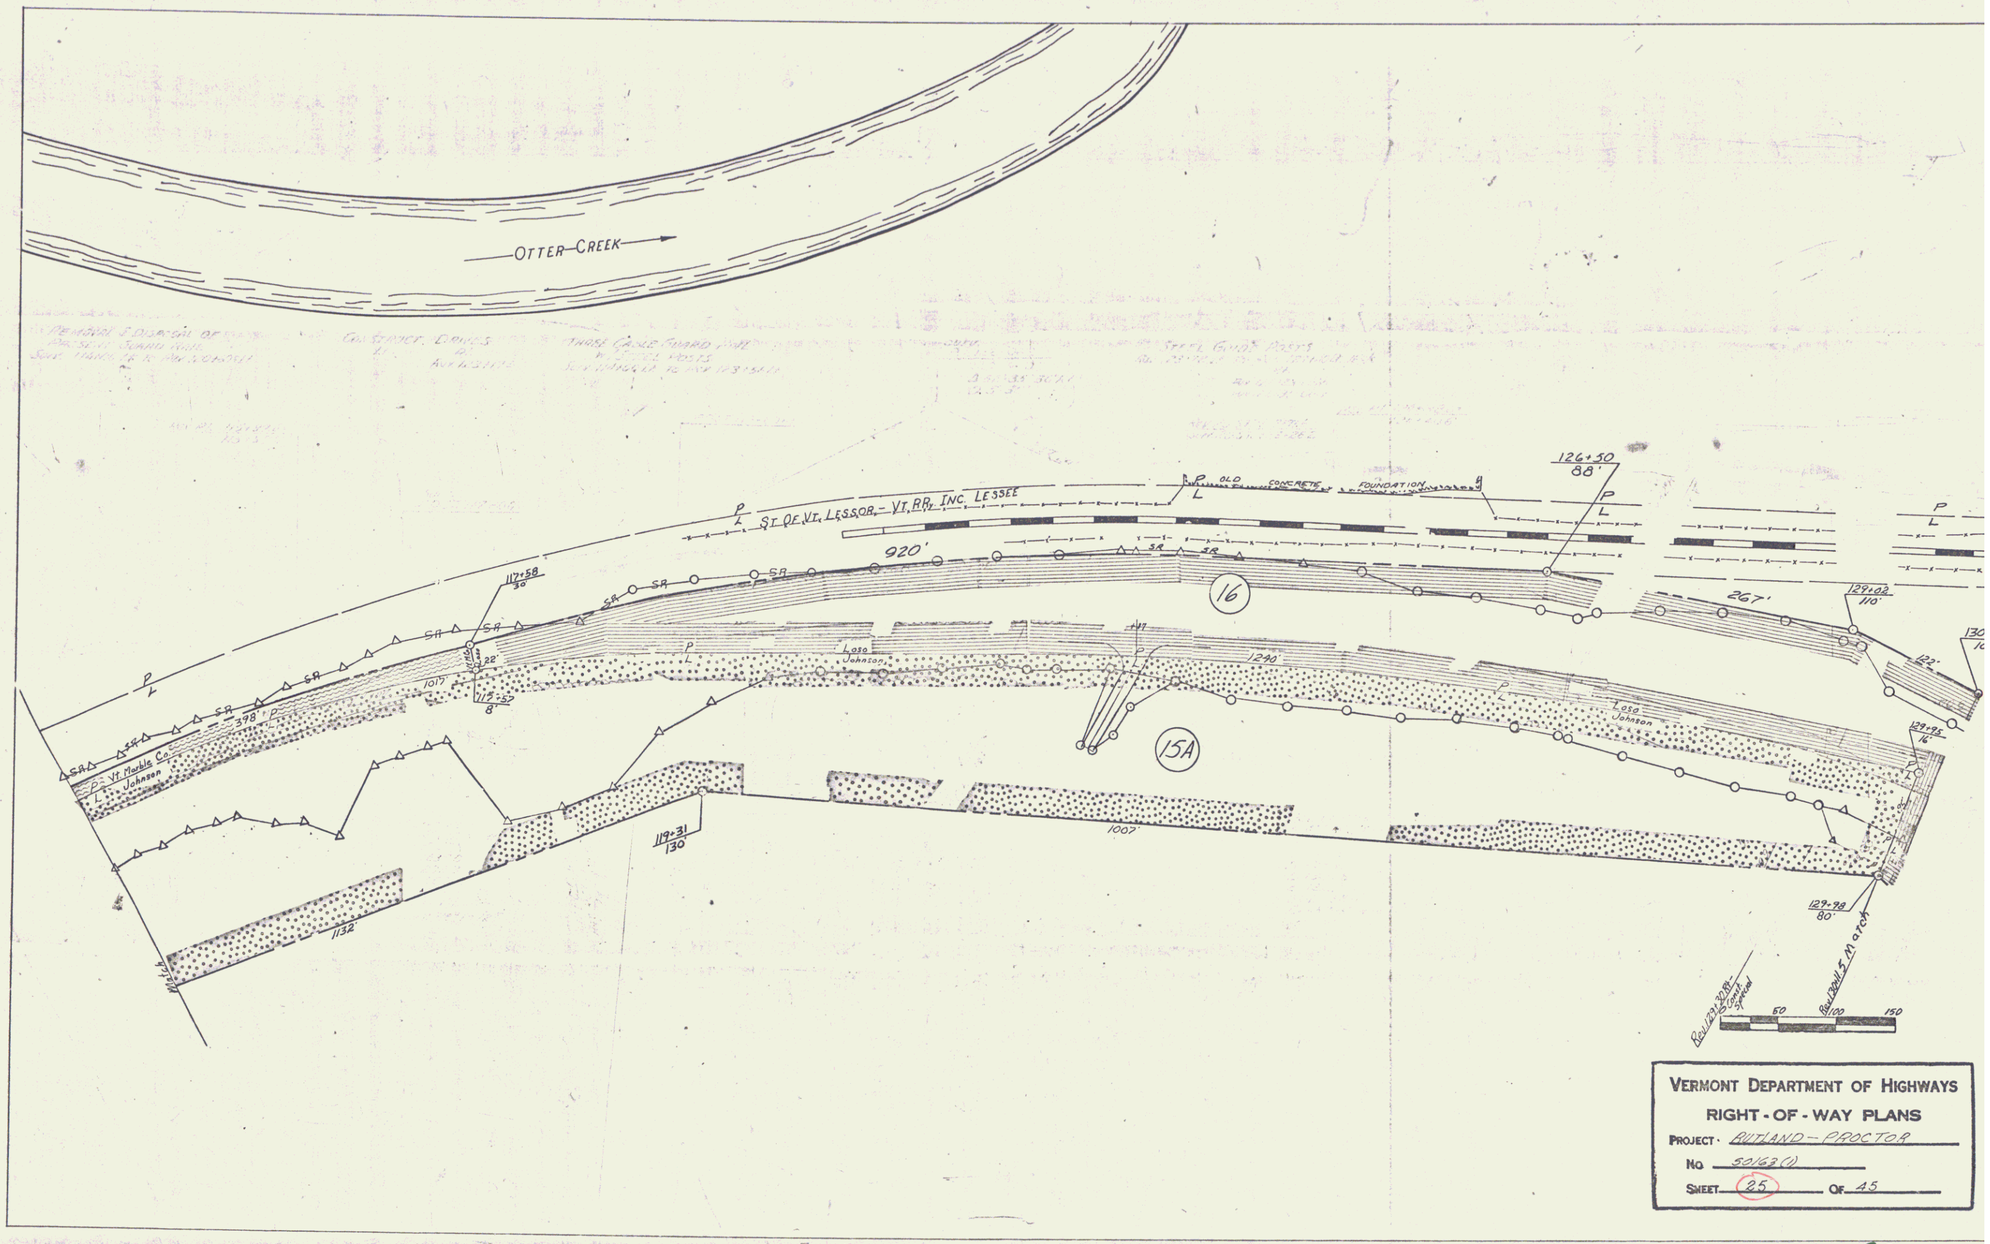

VERMONT DEPARTMENT OF HIGHWAYS
RIGHT-OF-WAY PLANS
PROJECT: RUTLAND - PROCTOR
NO. 50163(1)
SHEET 25 OF 45

22