PROPERTY PLAN

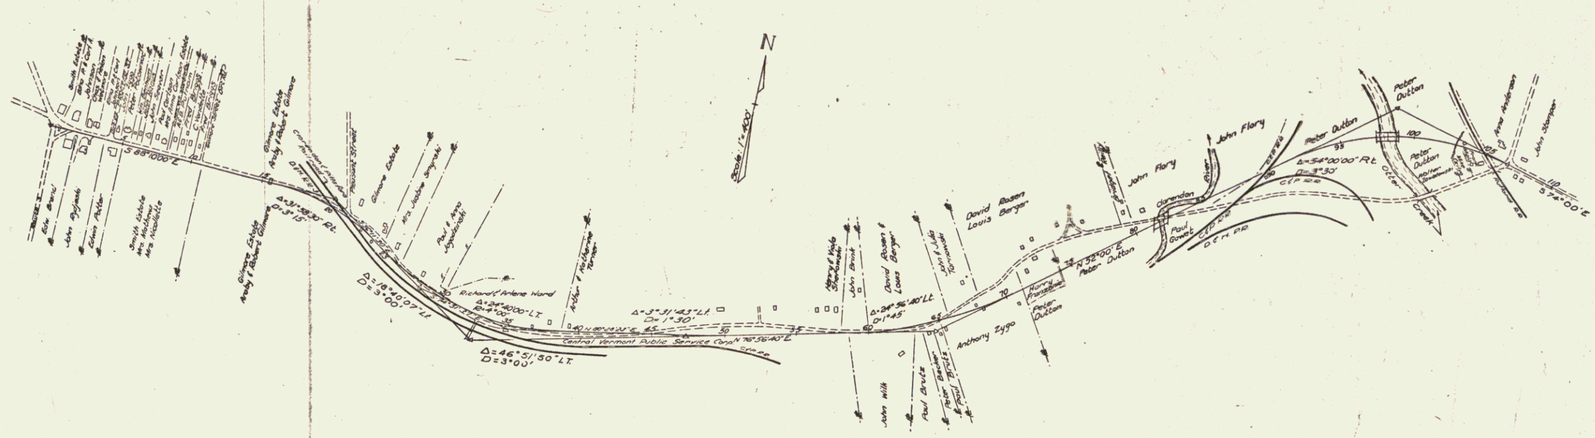
N
Scale 1"=100'
Richard & Irene Ward
Central Vermont Public Service Corp.
John Flory
Peter Dutton
David Rosen
Louis Berger
Anthony Zygo
John Hills
Paul Davis
Peter Dutton
Paul Davis
Peter Dutton
Peter Dutton
Peter Dutton