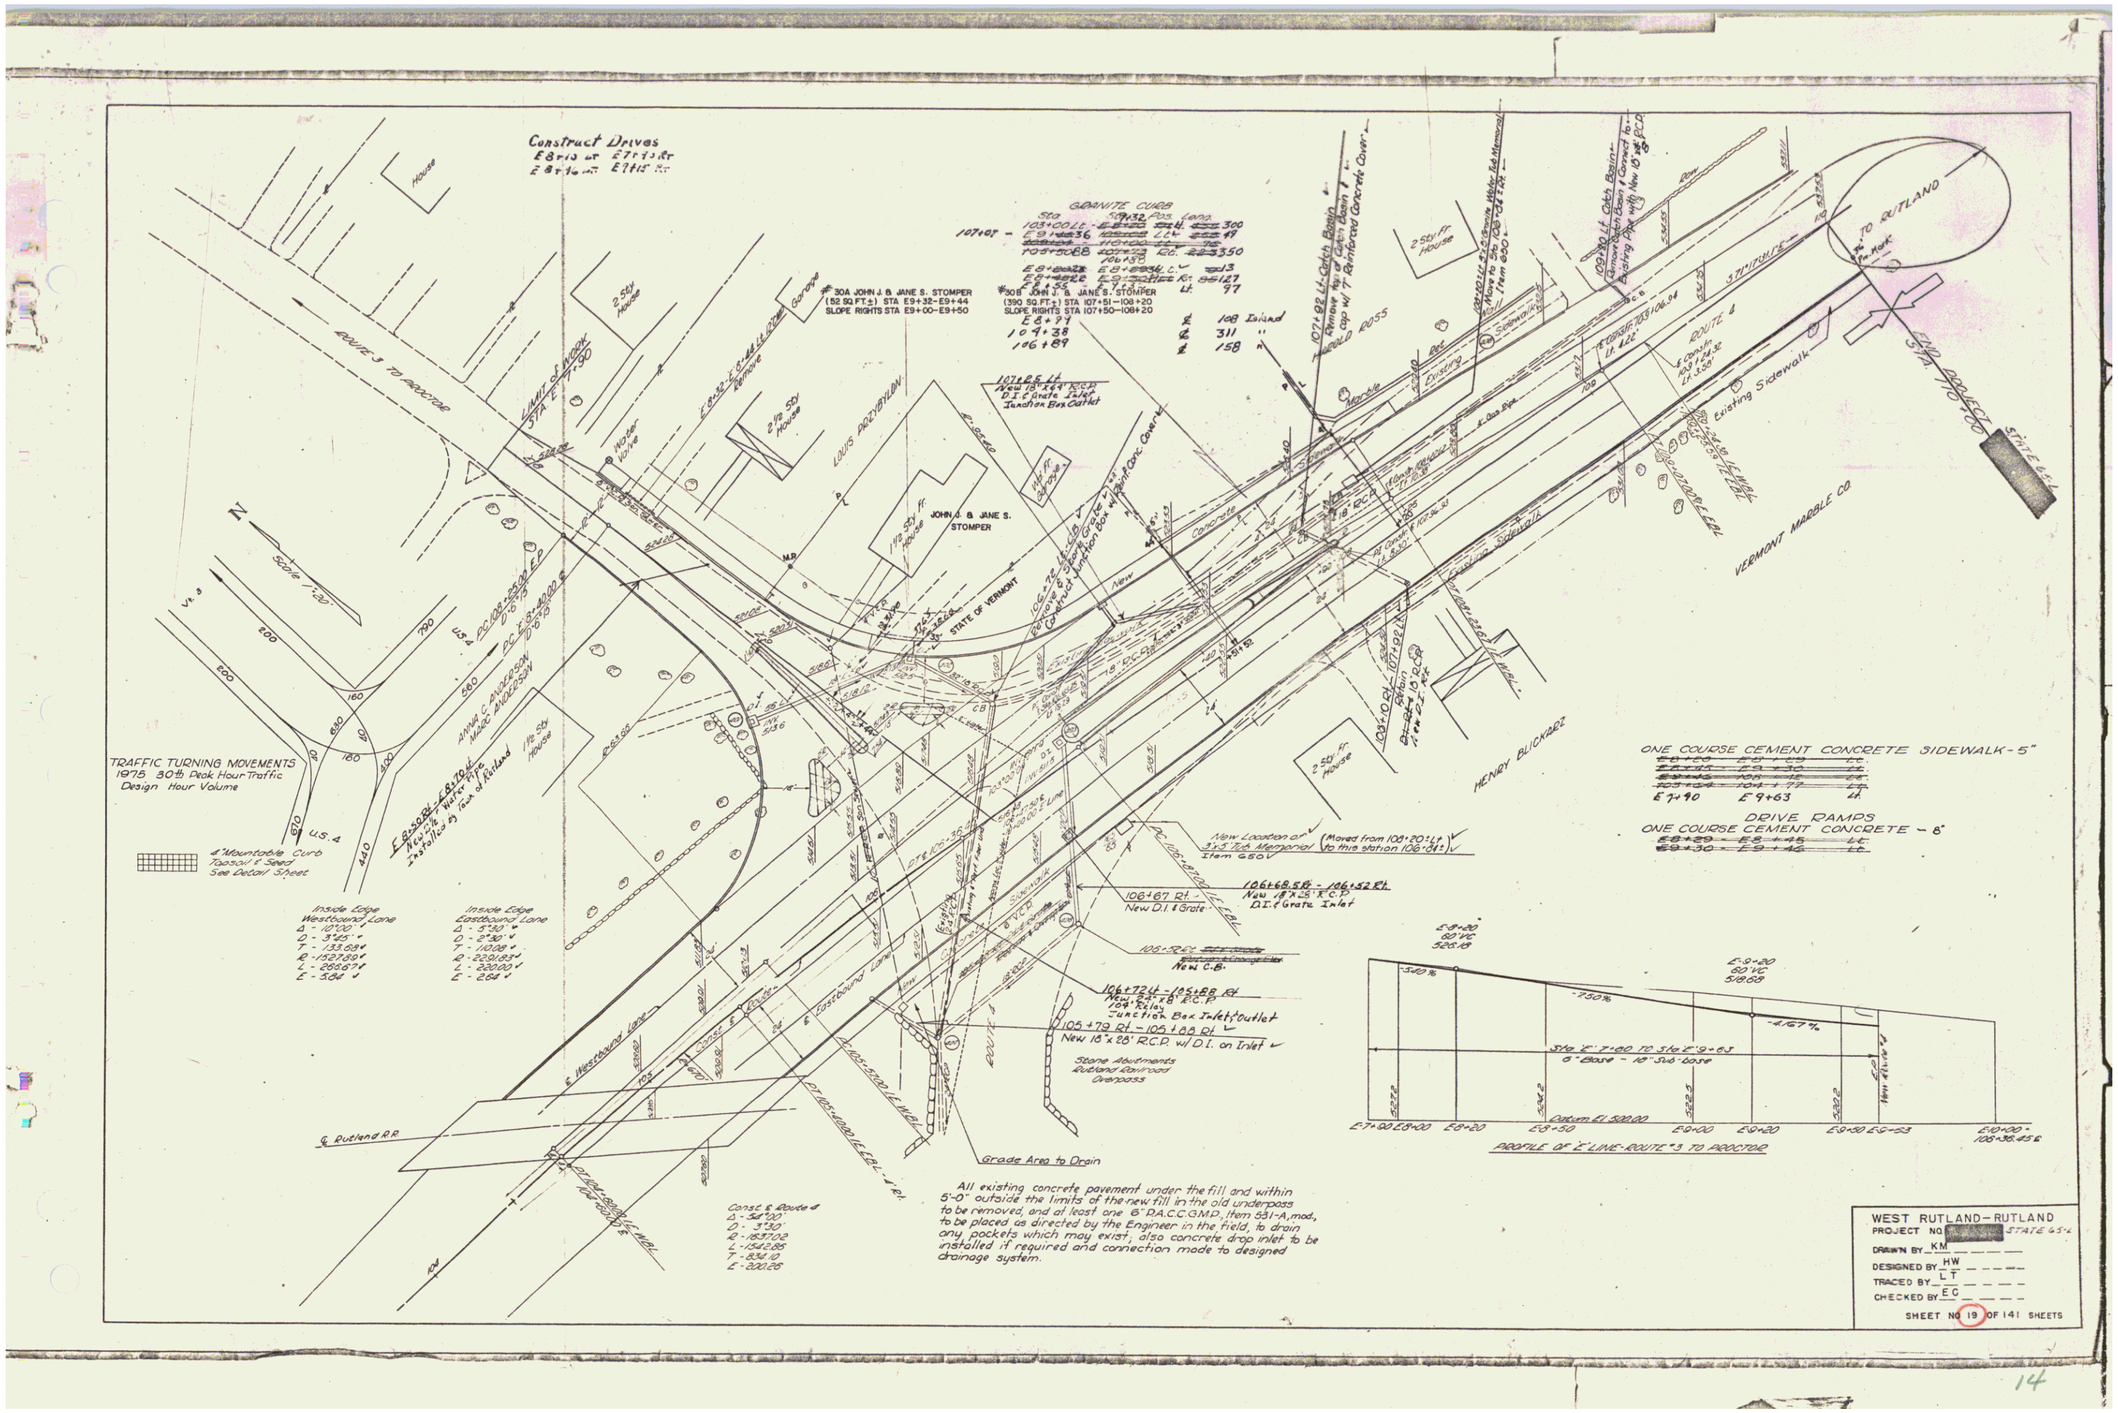
Construct Drives
GRANITE CURB
ROUTE 3 TO ROCTOR
JOHN J. & JANE S. STOMPER
STATE OF VERMONT
VERMONT MARBLE CO.
HENRY BLICKARZ
TO RUTLAND
ROUTE 4
Existing Sidewalk
TRAFFIC TURNING MOVEMENTS
1975 30th Peak Hour Traffic
Design Hour Volume
4" Mountable Curb
Topsoil & Seed
See Detail Sheet
Inside Edge Westbound Lane
Inside Edge Eastbound Lane
ONE COURSE CEMENT CONCRETE SIDEWALK-5"
DRIVE RAMPS
ONE COURSE CEMENT CONCRETE - 8"
PROFILE OF ℄ LINE-ROUTE #3 TO ROCTOR
Grade Area to Drain
All existing concrete pavement under the fill and within 5'-0" outside the limits of the new fill in the old underpass to be removed, and at least one 6" P.A.C.C.G.M.P., Item 531-A, mod., to be placed as directed by the Engineer in the field, to drain any pockets which may exist, also concrete drop inlet to be installed if required and connection made to designed drainage system.
WEST RUTLAND-RUTLAND
PROJECT NO [redacted] STATE 65-2
DRAWN BY KM
DESIGNED BY HW
TRACED BY LT
CHECKED BY EC
SHEET NO 19 OF 141 SHEETS