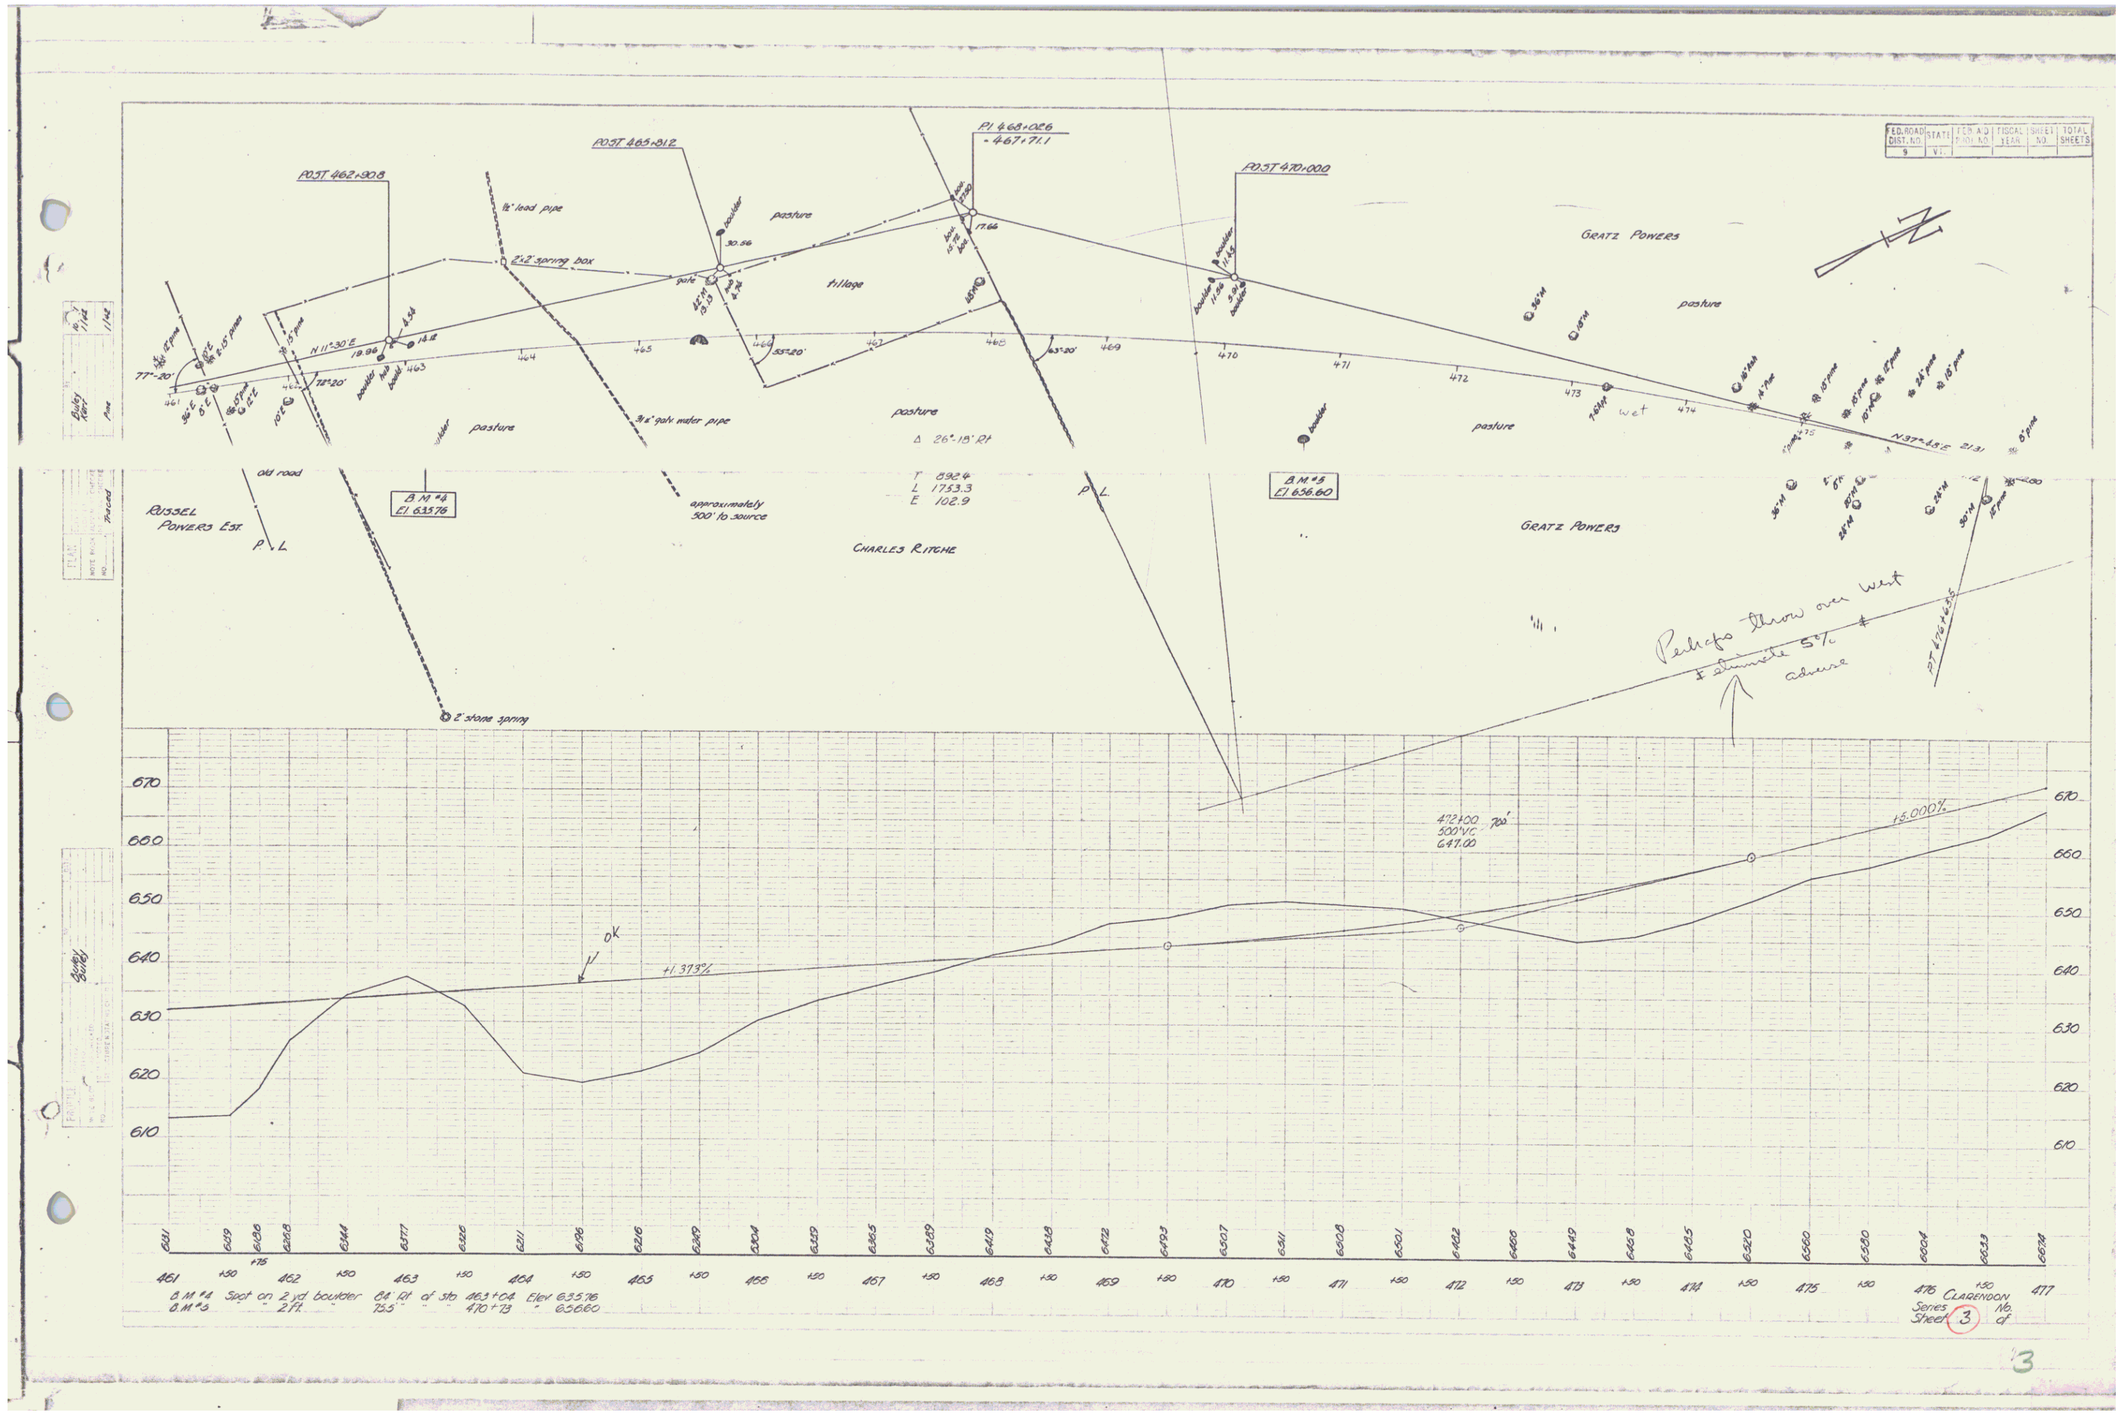
FED. ROAD DIST. NO. 9
STATE VT.
FED. AID PROJ. NO.
FISCAL YEAR
SHEET NO.
TOTAL SHEETS
POST 462+90.8
POST 465+81.2
PI 468+02.6 = 467+71.1
POST 470+00.0
12" lead pipe
2'x2' spring box
pasture
tillage
GRATZ POWERS
N 11°30' E
77°-20'
72°20'
55°20'
63°20'
Δ 26°-18'-Rt
T 392.4
L 1753.3
E 102.9
3½" galv. water pipe
old road
RUSSEL POWERS EST.
P.L.
B.M. #4 El. 633.76
B.M. #3 El. 656.60
approximately 500' to source
CHARLES RITCHE
wet
N 37°-45' E 213.1
2' stone spring
Perhaps throw over wet & eliminate 5% abuse
472+00 500' VC 647.00
+1.373%
+5.000%
OK
Spot on 2 yd boulder 84' Rt of sta 463+04 Elev 635.76
B.M. #4 B.M. #3 271' 73.5' 470+73 656.60
CLARENDON
Series 3 Sheet 3 No. of

3