TOWN OF CLARENDON

Project Cold River Bridge (1933)

Pin # 99R709

Route VT7B
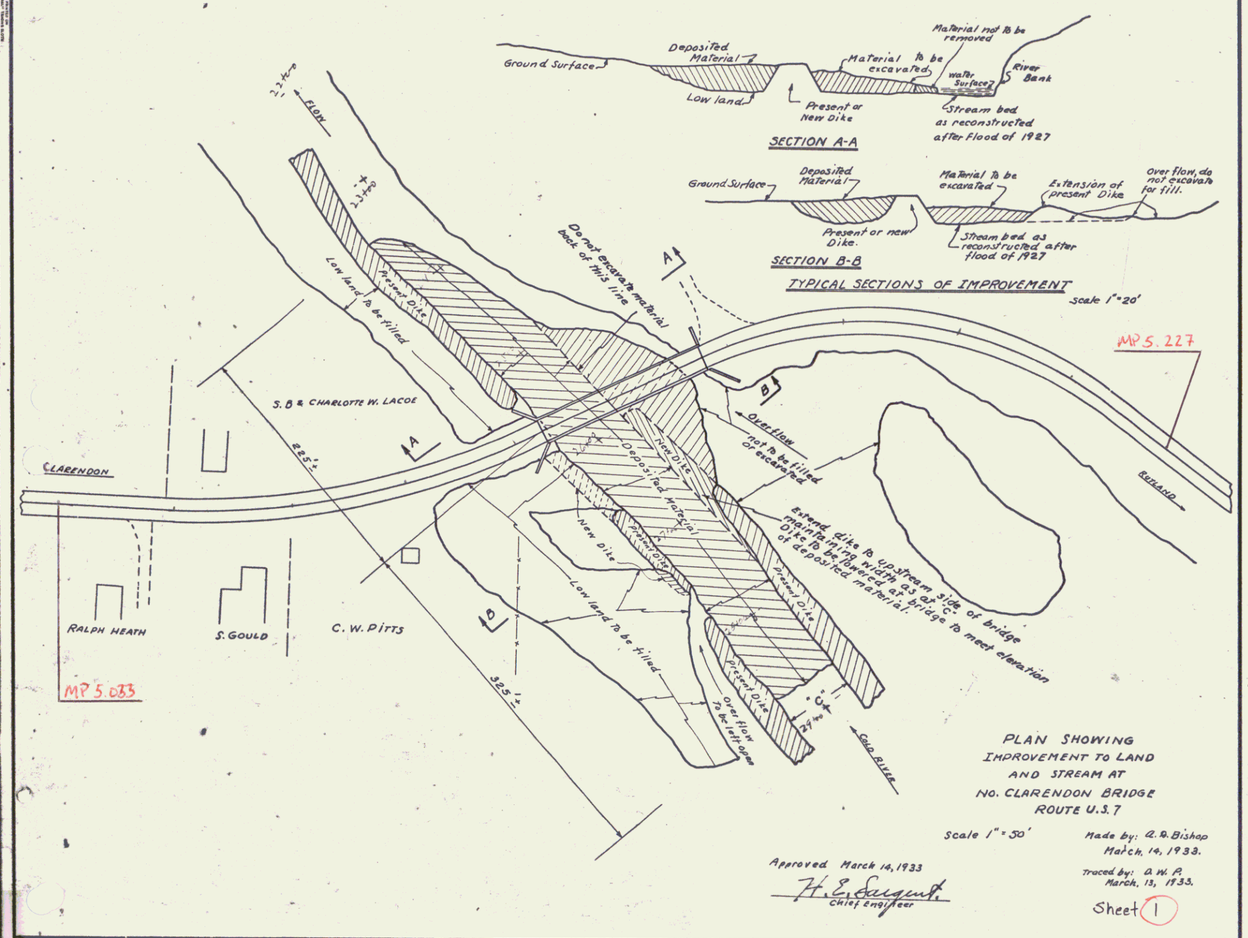
Date 1/1/1933