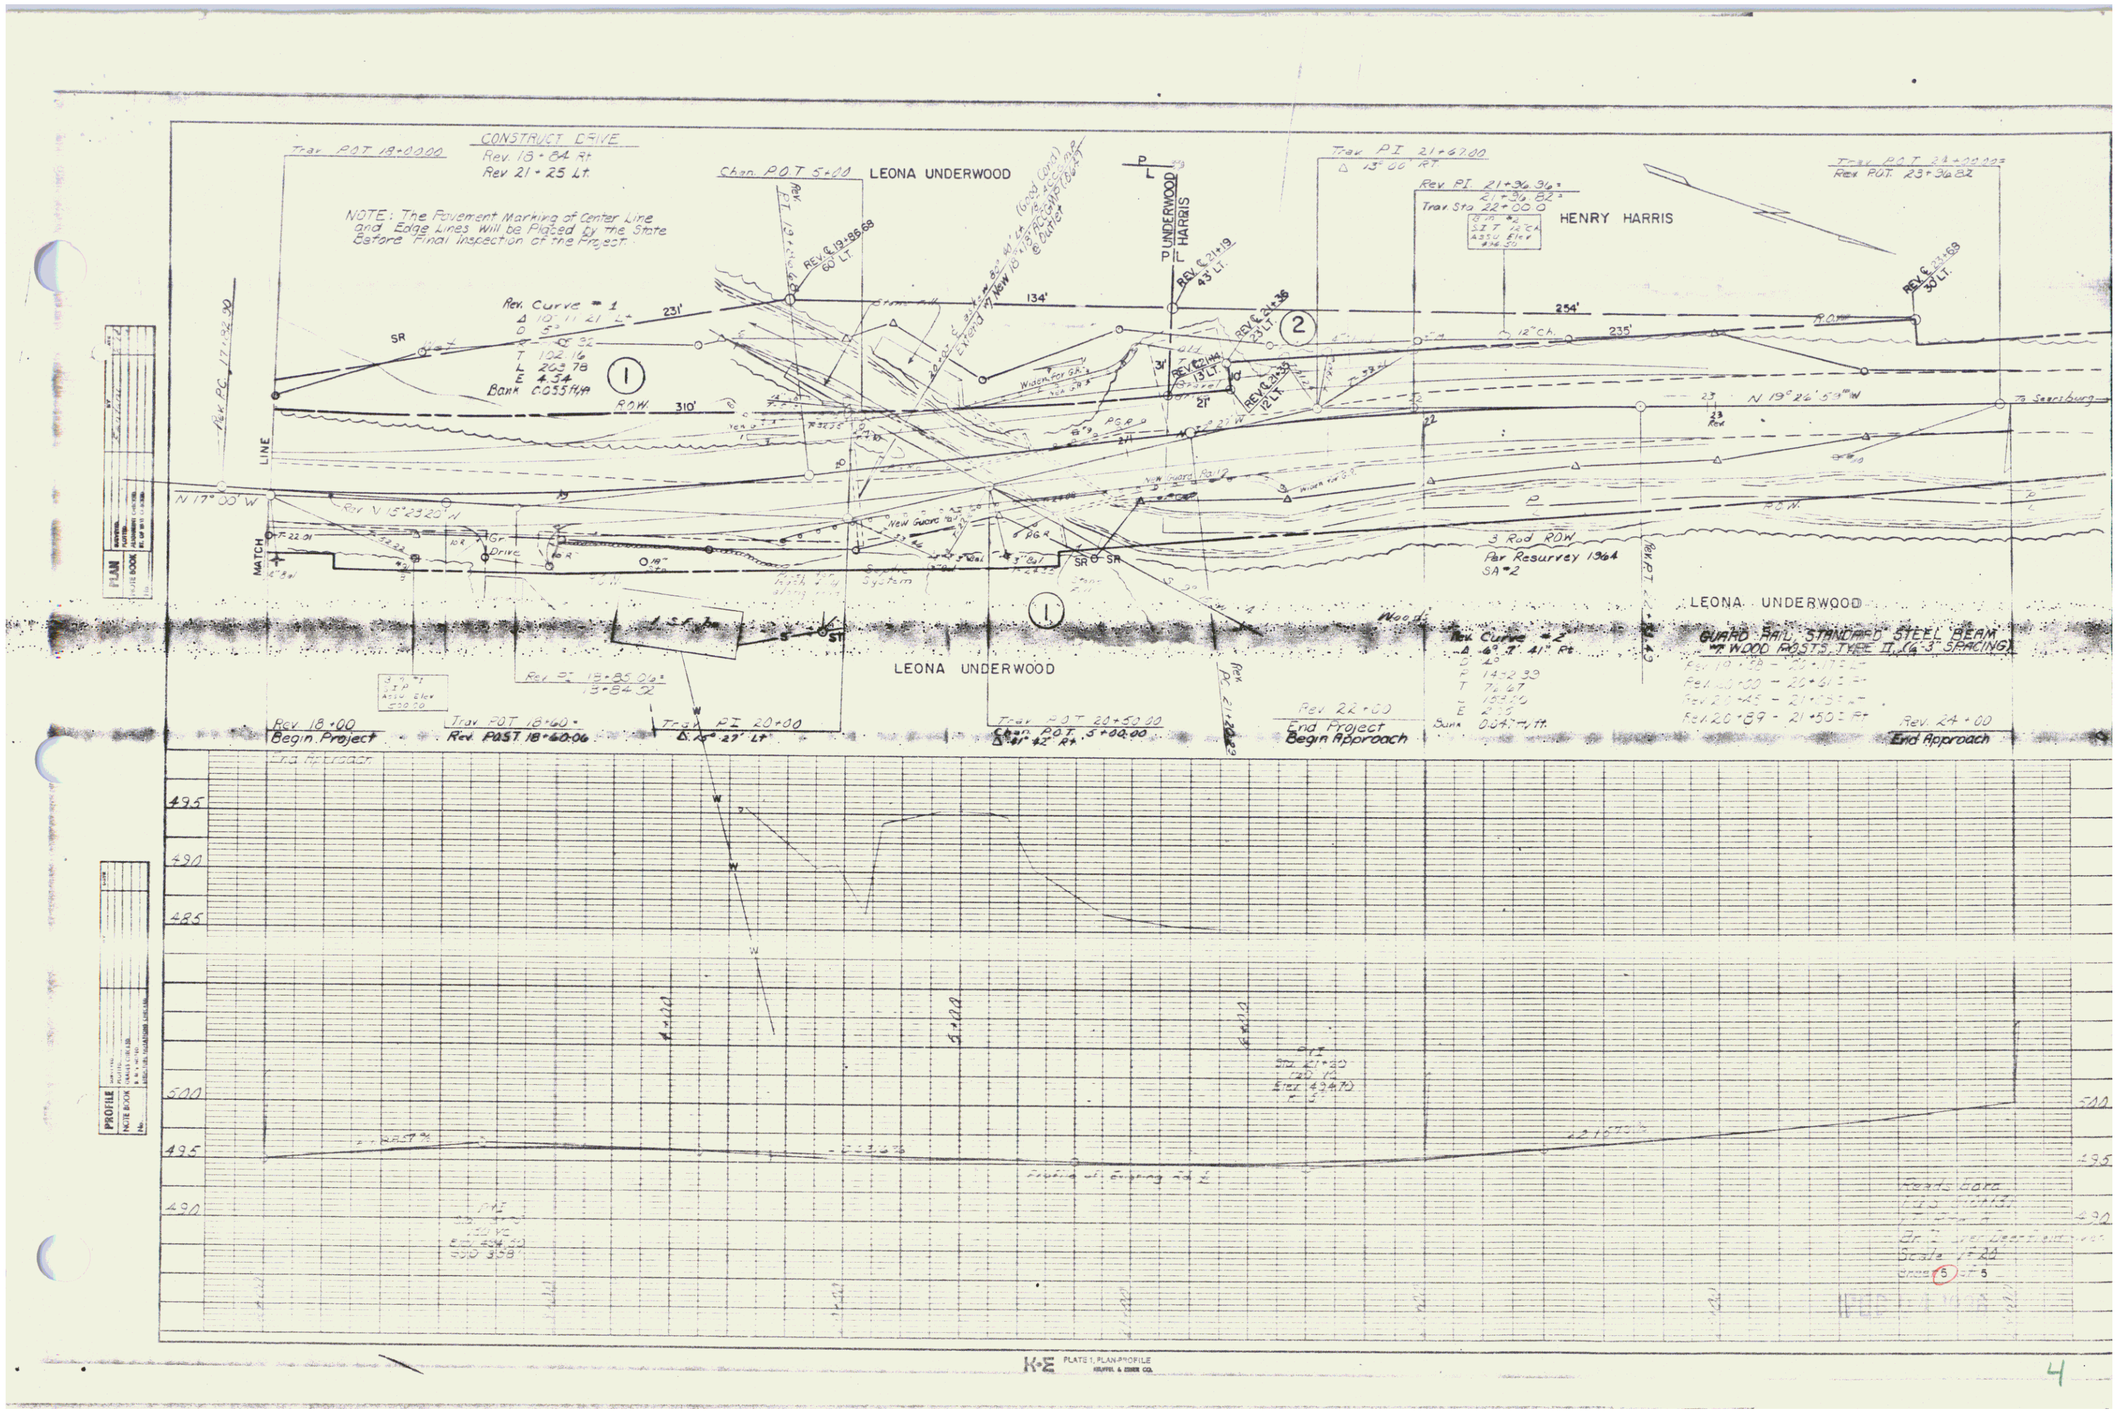
CONSTRUCT DRIVE
Rev. 18 + 84 Rt
Rev. 21 + 25 Lt.
NOTE: The Pavement Marking of Center Line and Edge Lines Will be Placed by the State Before Final Inspection of the Project
LEONA UNDERWOOD
HENRY HARRIS
Rev. Curve # 1
Bank 0.055 ft/ft
ROW
MATCH LINE
Rev. Curve # 2
Bank 0.047 ft/ft
3 Rod ROW
Per Resurvey 1964
SA # 2
GUARD RAIL STANDARD STEEL BEAM
W WOOD POSTS TYPE II (6'-3" SPACING)
Rev. 18 + 00
Begin Project
End Approach
Rev. 22 + 00
End Project
Begin Approach
Rev. 24 + 00
End Approach
495
490
485
500
495
490
PROFILE
NOTE BOOK
PLAN
NOTE BOOK