



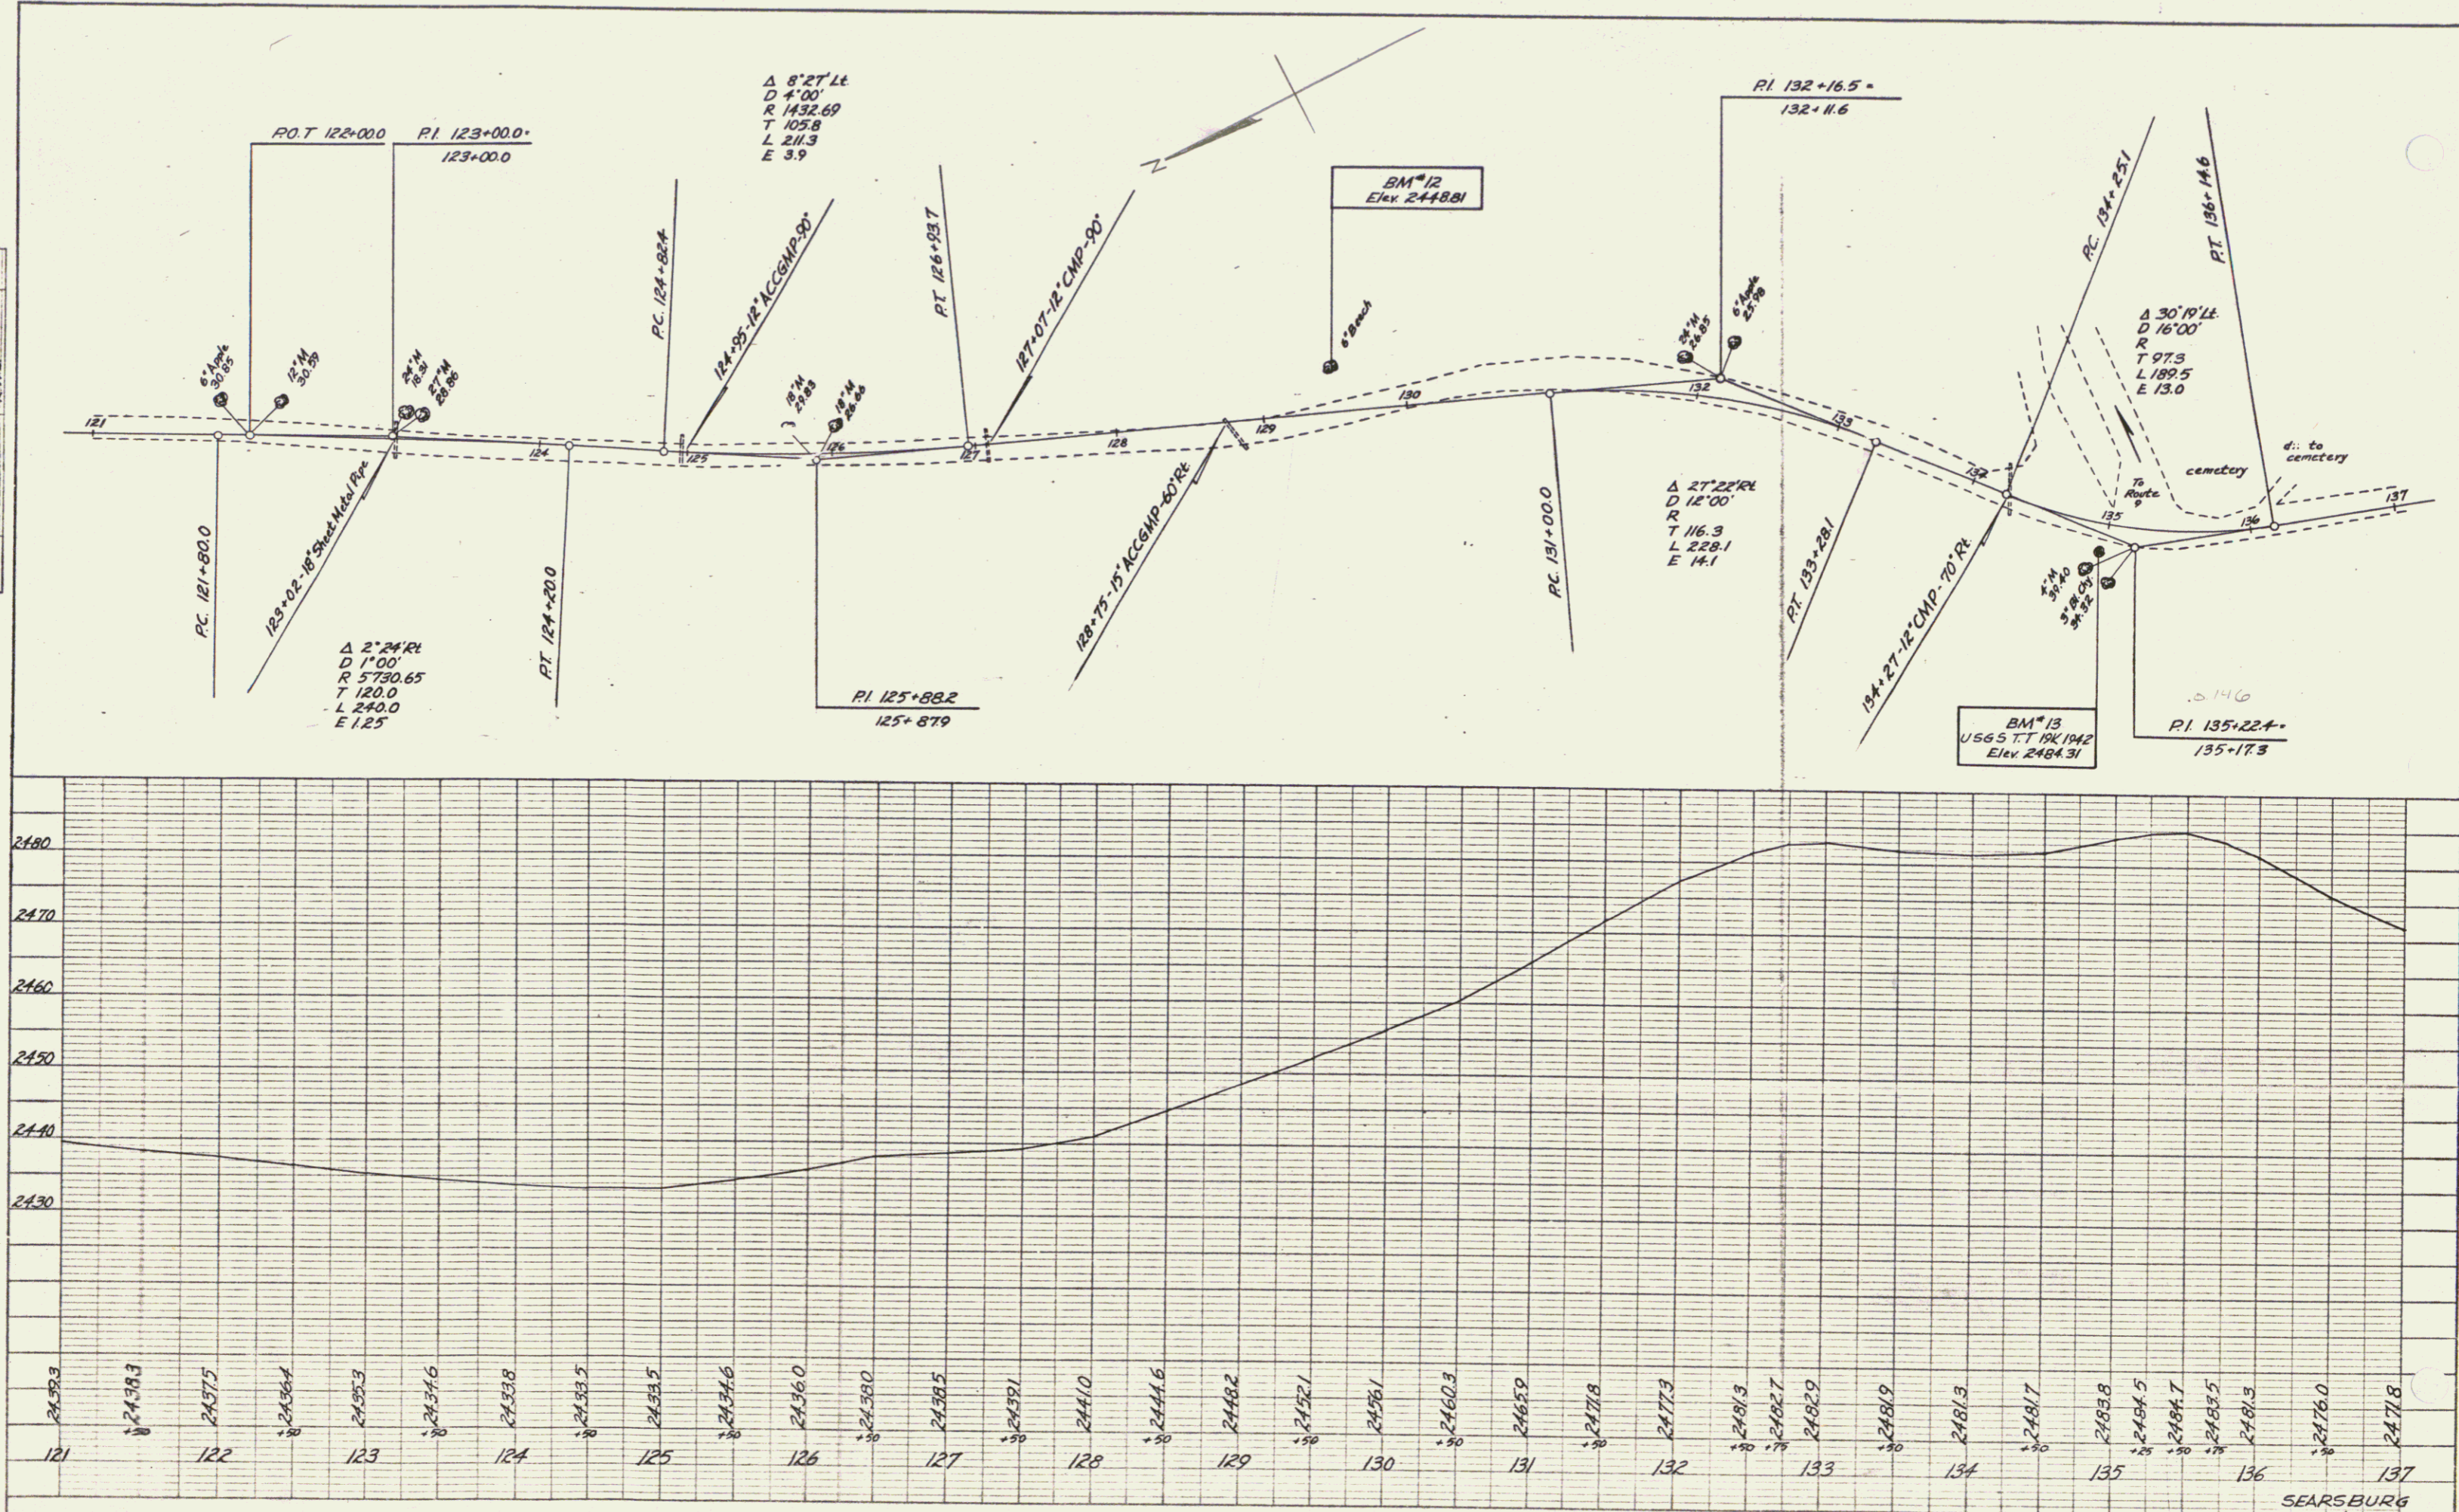


 K. & E. CO. No. 248-C

SEARSBURG
 State Aid
 Sheet 8 of 9
 8
 Sealers E