Parcel	Kind of Instrument	Date of Instrument	Grantor	Grantee	Recorded Essex Book	Page	Date	Remarks
A	W.D.	10-21-35	T&V. O'Connor	Staff rt.	41	39	10-26-35	
A'	"	10-24-35	Milton Crop Dairy Corp	" "	41	55	11-20-35	

NOTE: STA 25+50
CULVERT PLACED AND PAID FOR. NO EXCAVATION. CULVERT REMOVED AND USED AS RELAY PIPE ON W.P.S.S. 165-D 12' LEFT WITH W.W. WORKMAN, D.H.C.

W.P.G.M. 165C 1936 4 20

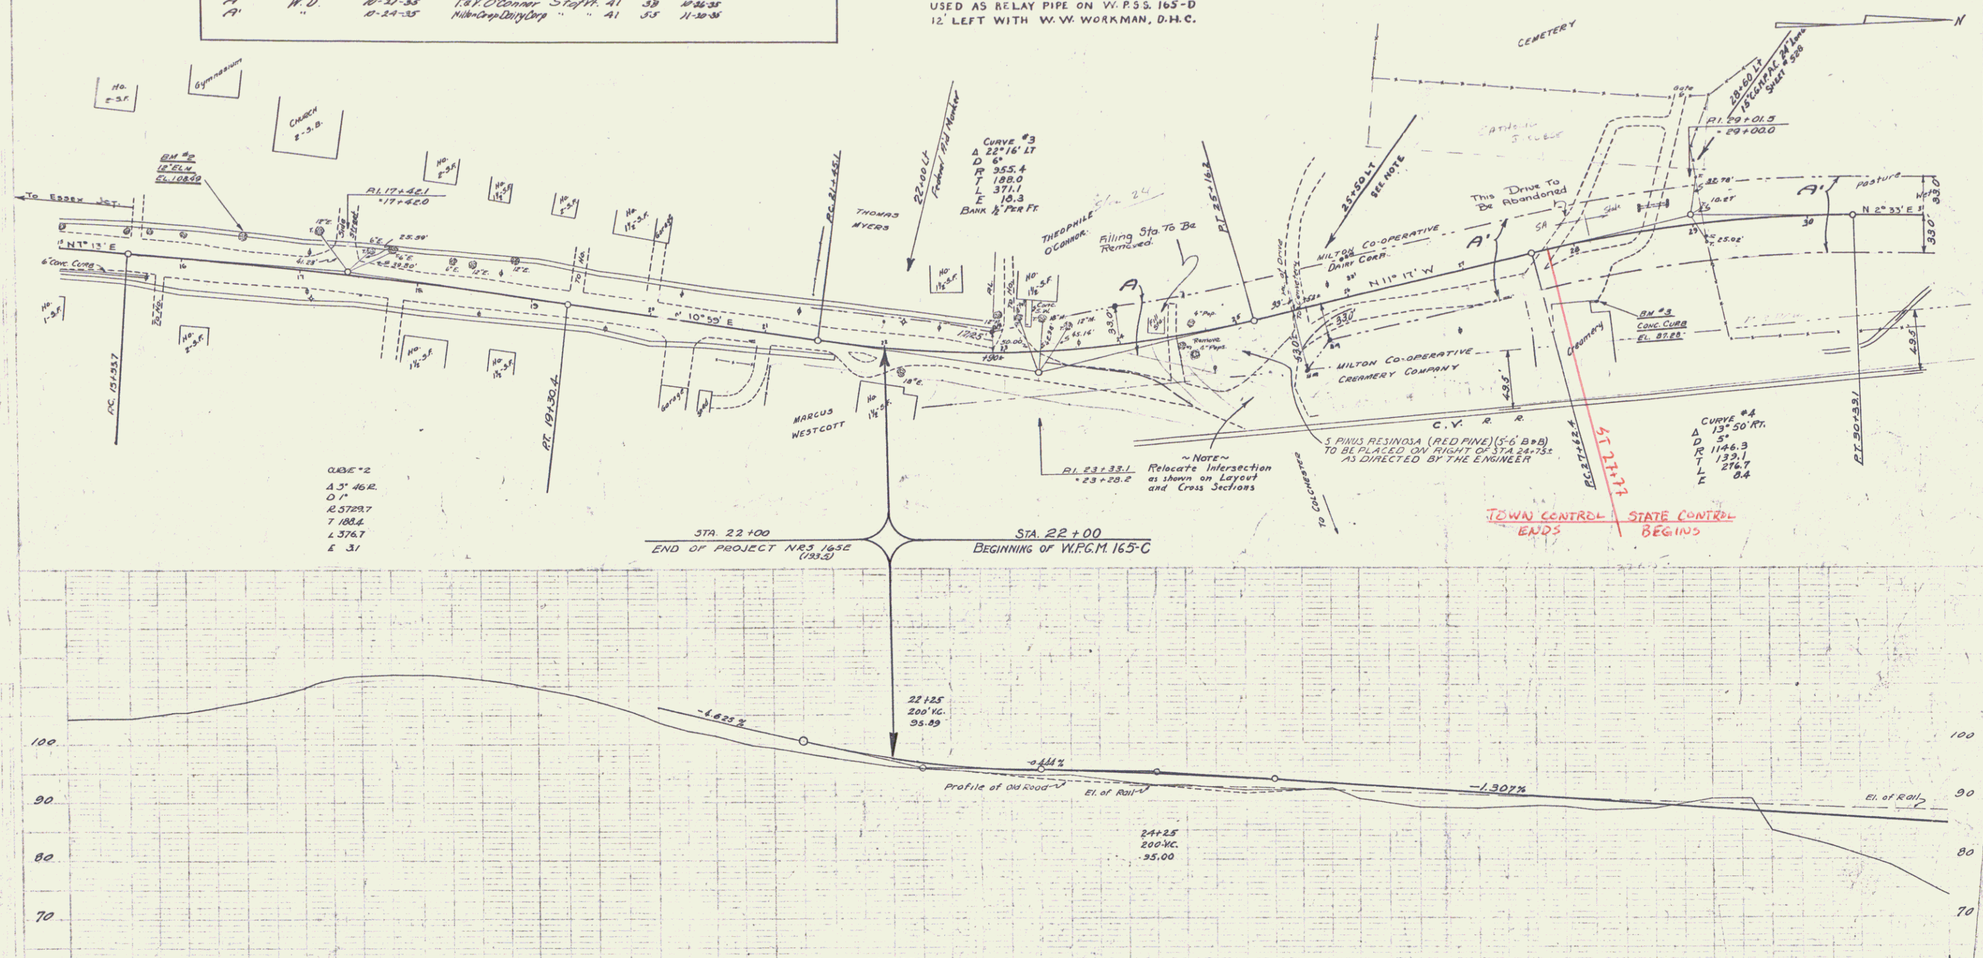

Series W.P.G.M. No 165C
Sheet 4 of 20

5