FED. ROAD DIV. NO.	STATE	N.P.S. PROJ. NO.	FISCAL YEAR	SHEET NO.
		165 (1939)	1933	10

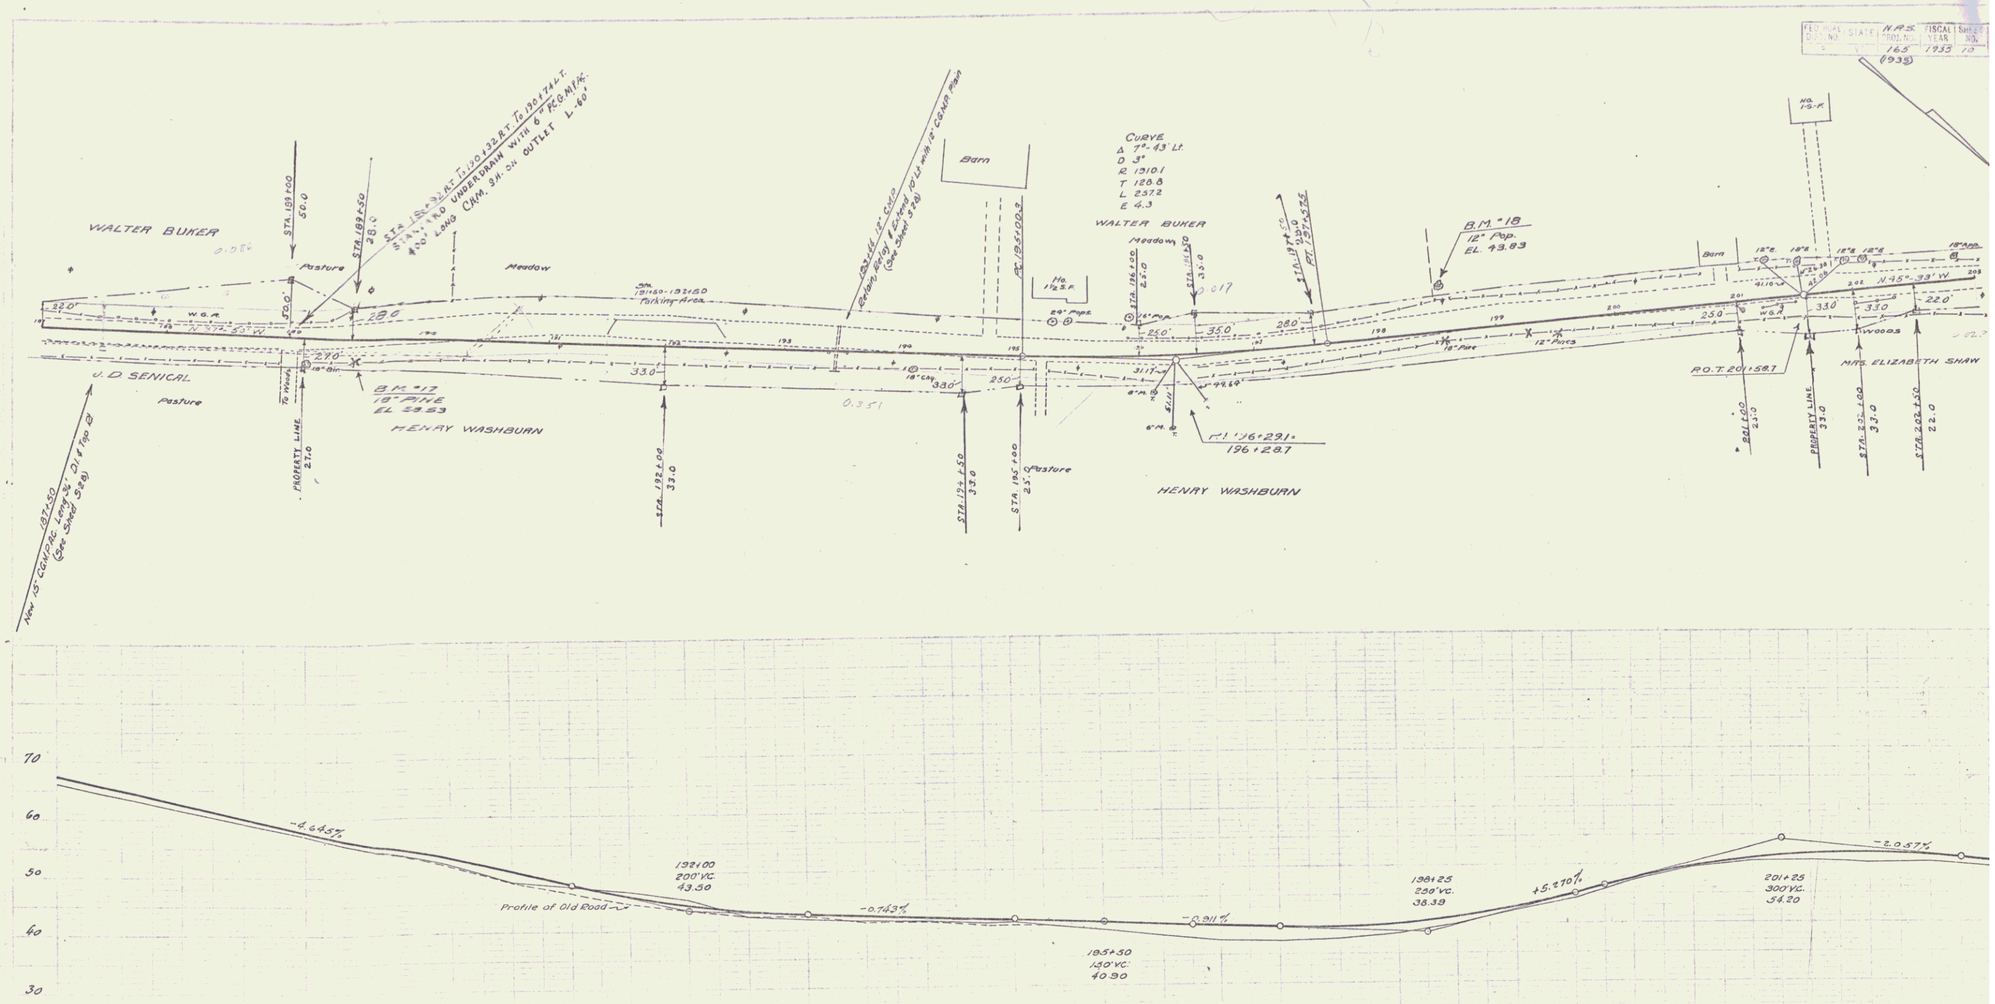

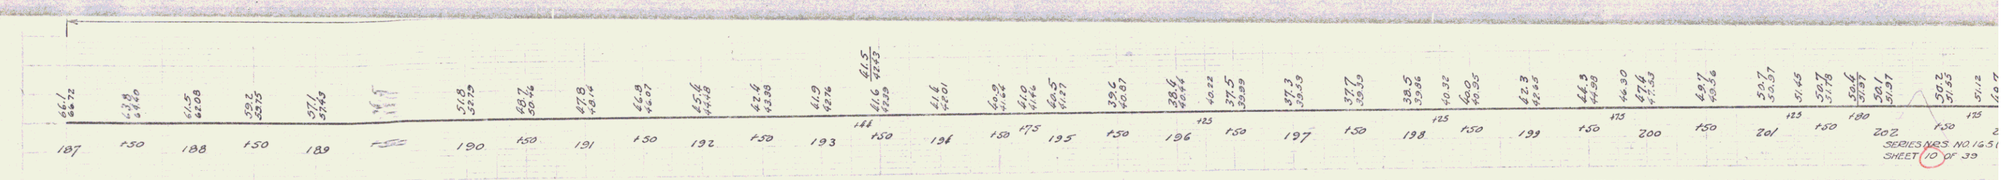

SERIES NPS NO. 165
SHEET 10 OF 39

9