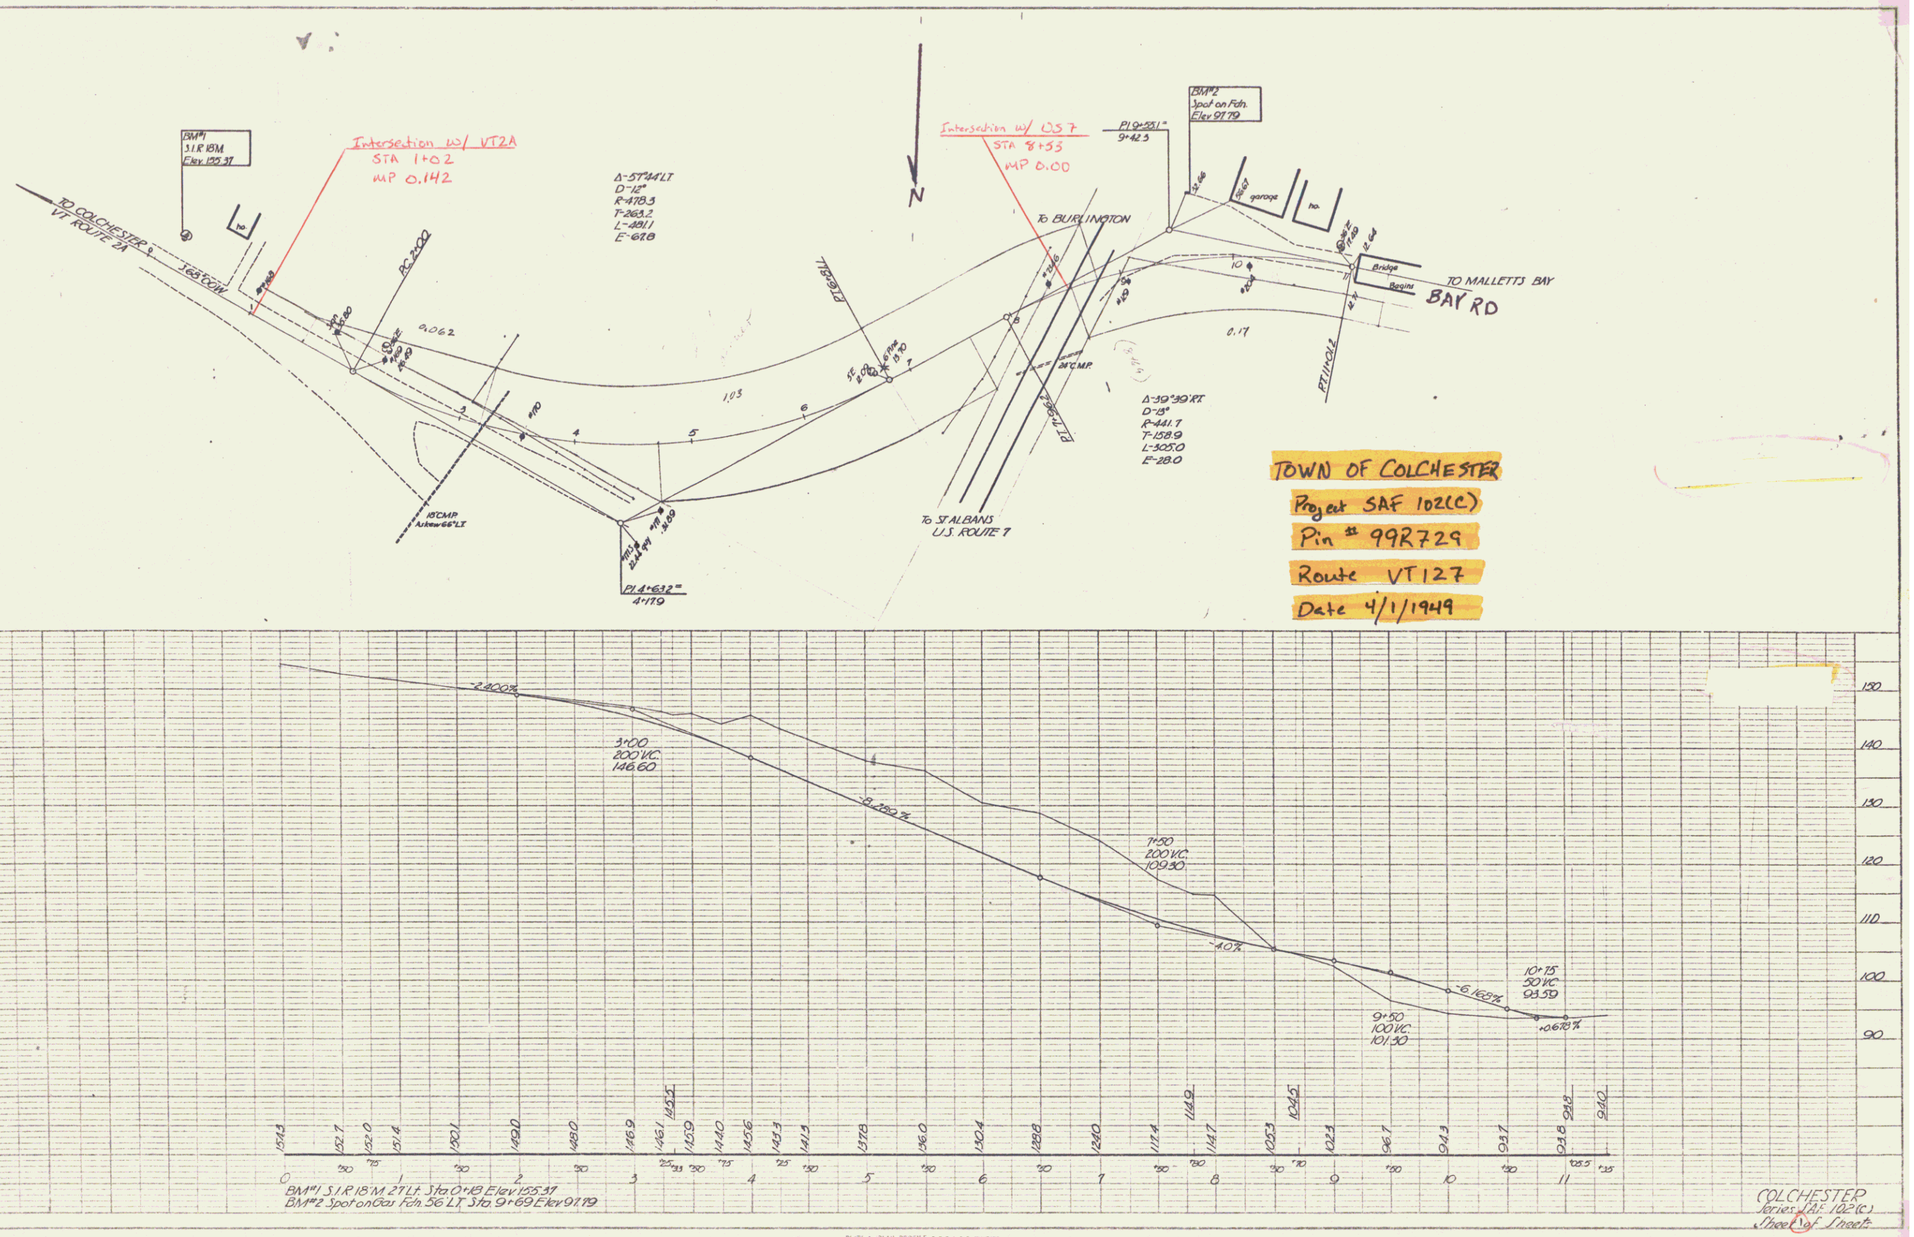

PLAN
NOTE BOOK
NO.
SURVEYED
PLOTTED
TRACED
CHECKED
R.C. BROWN CHECKED

PROFILE
NOTE BOOK
NO.
CROSS SECTIONS
CHECKED
IN NOTE
BOOK

PLATE 1-PLAN-PROFILE O.P.R.&R.E. STANDARD
KEUFFEL & ESSER CO. NEW YORK
K & E Co. No. 348-1C