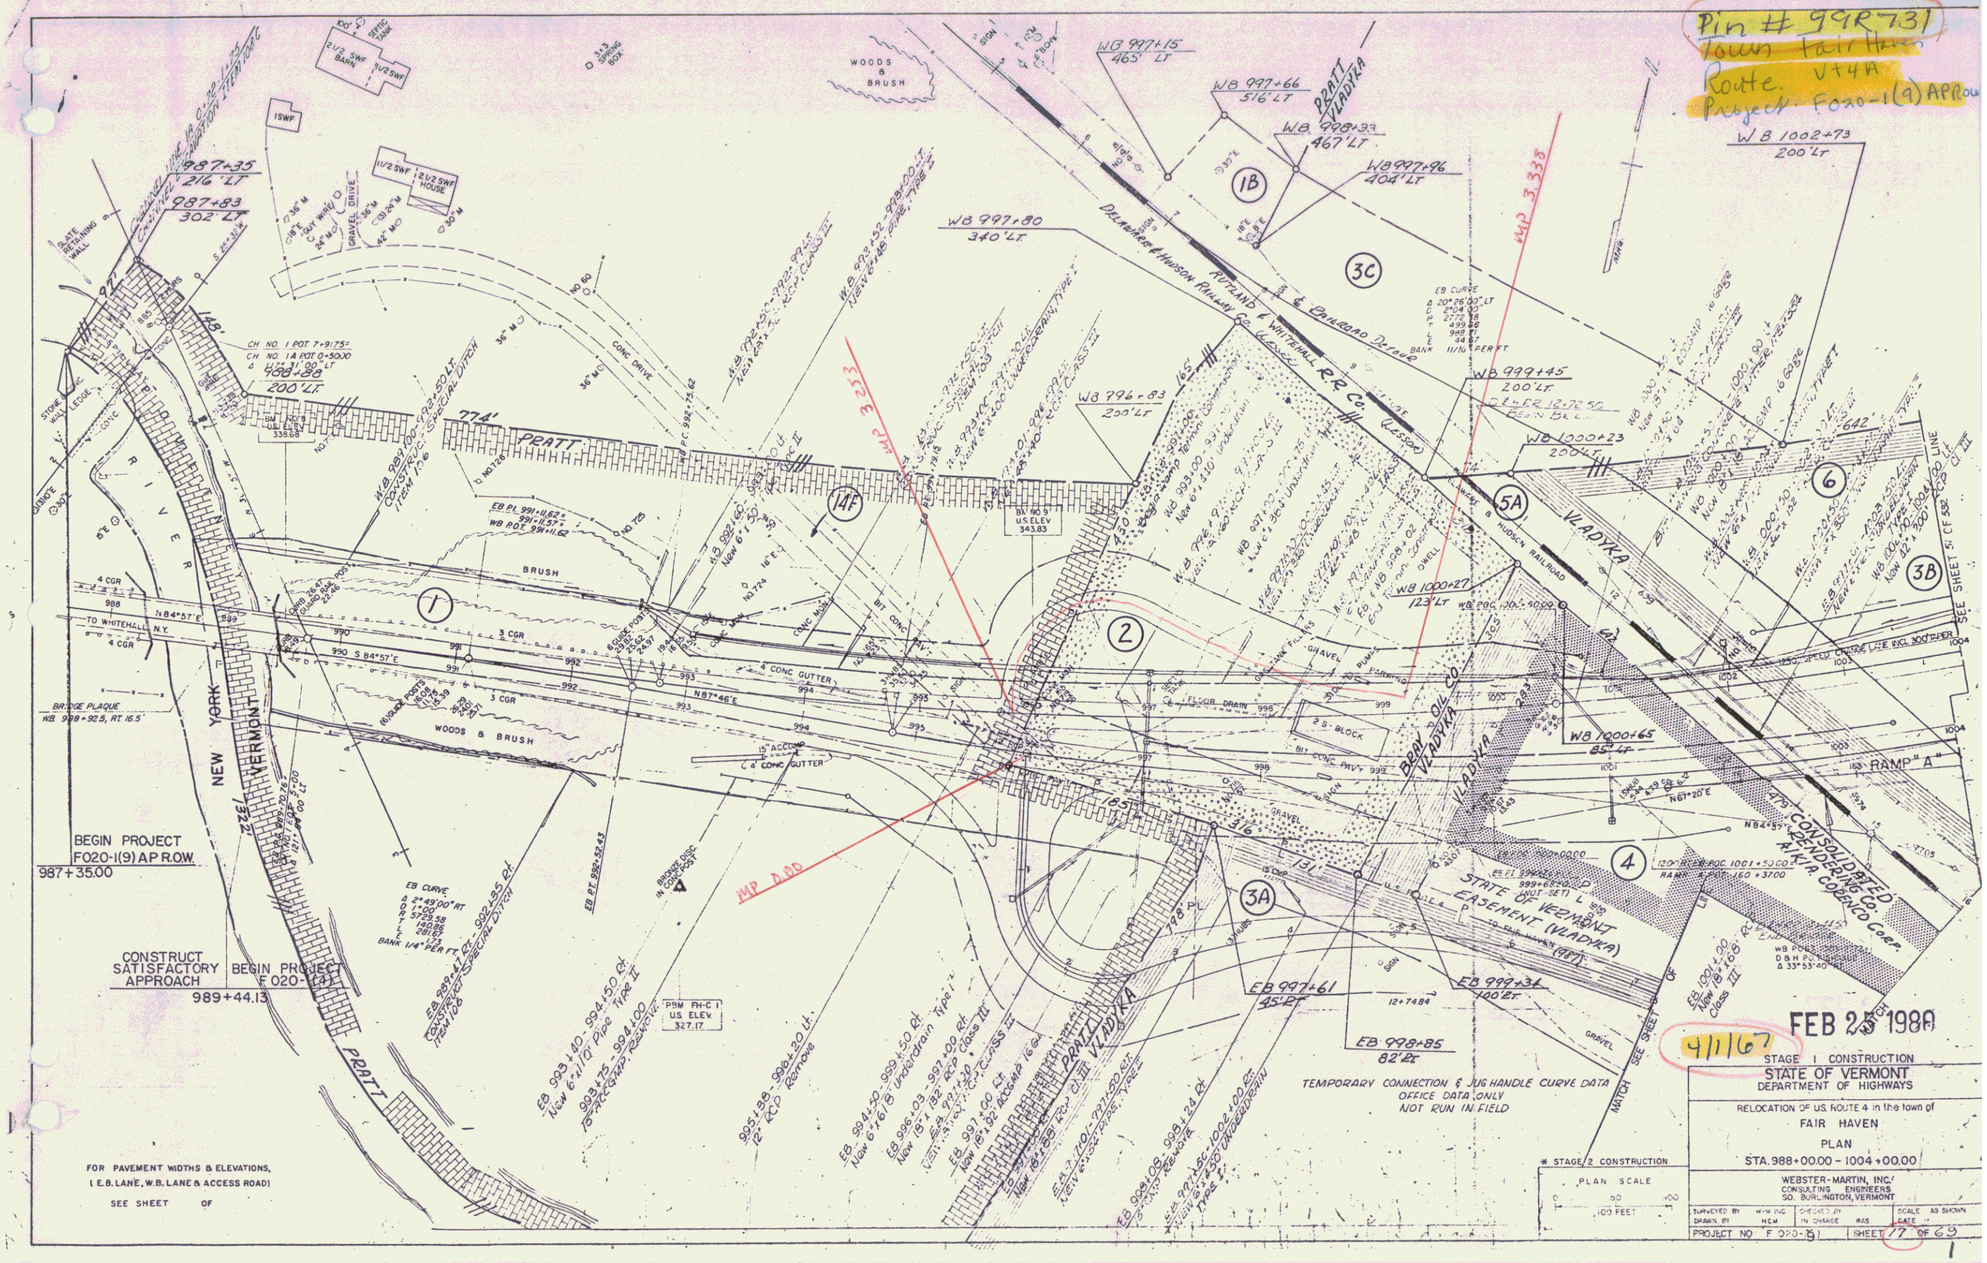Pin # 99R731
Town Fair Haven
Route V+4A
Project F020-1(9) APPROV