FED. ROAD DIST. NO.	STATE	FED. AID PROJ. NO.	FISCAL YEAR	SHEET NO.	TOTAL SHEETS
1	VT	BRZ	1924	6	19

Br 12

Guard Rail Required
On Right
Sta. 4+87 to Bridge 24'
Bridge to Sta. 5+82 24'

On Left
Sta. 4+99 to Bridge 24'
Bridge to Sta. 5+94 24'
Total on sheet 96'

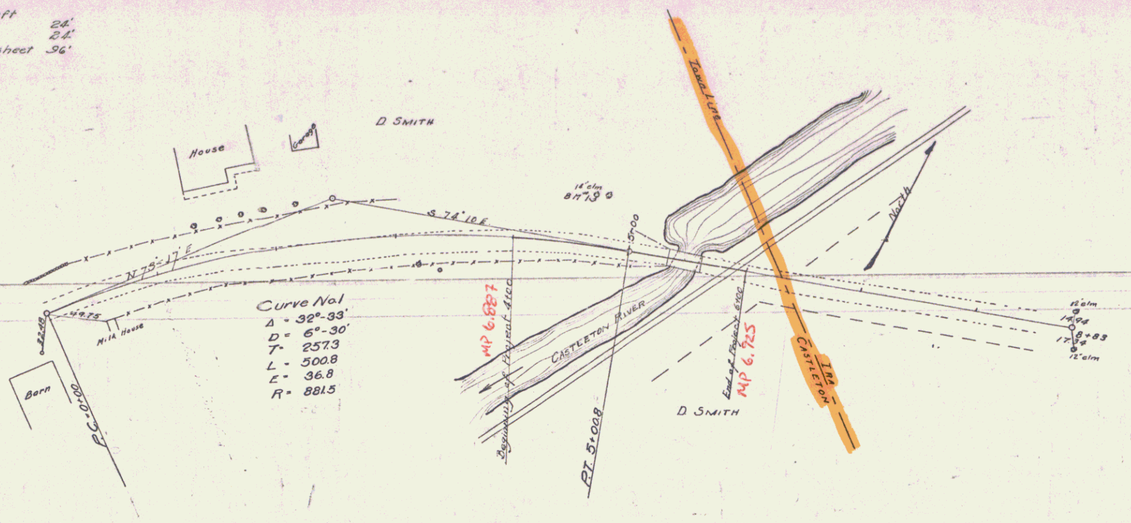

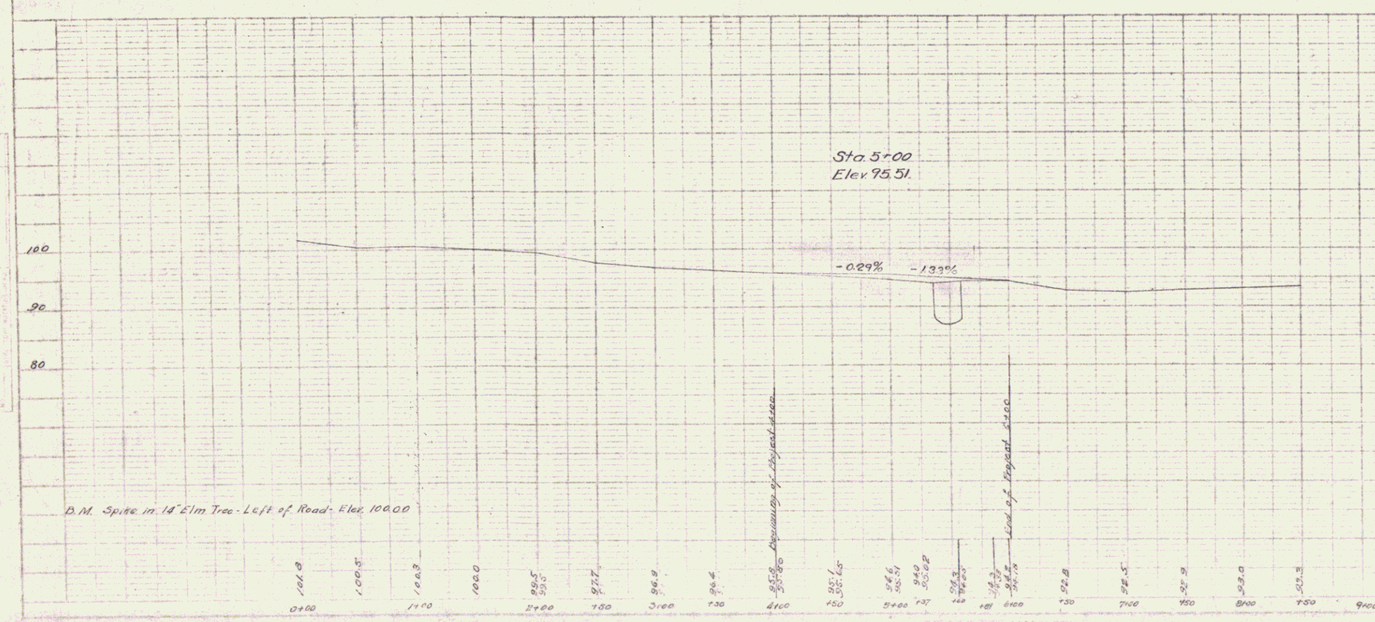

Bridge No. 4

Lines by E. R. Welch
Plotted by E. R. Welch 4/7/24
Checked by H. F. Rodigan 4/10/24
Estimated by H. W. M.
Series # 6 of 19

5