


DATE	BY	NO.	REVISION

DATE	BY	NO.	REVISION

Ernest E. Egan
 Ernest E. Egan
 Ernest E. Egan

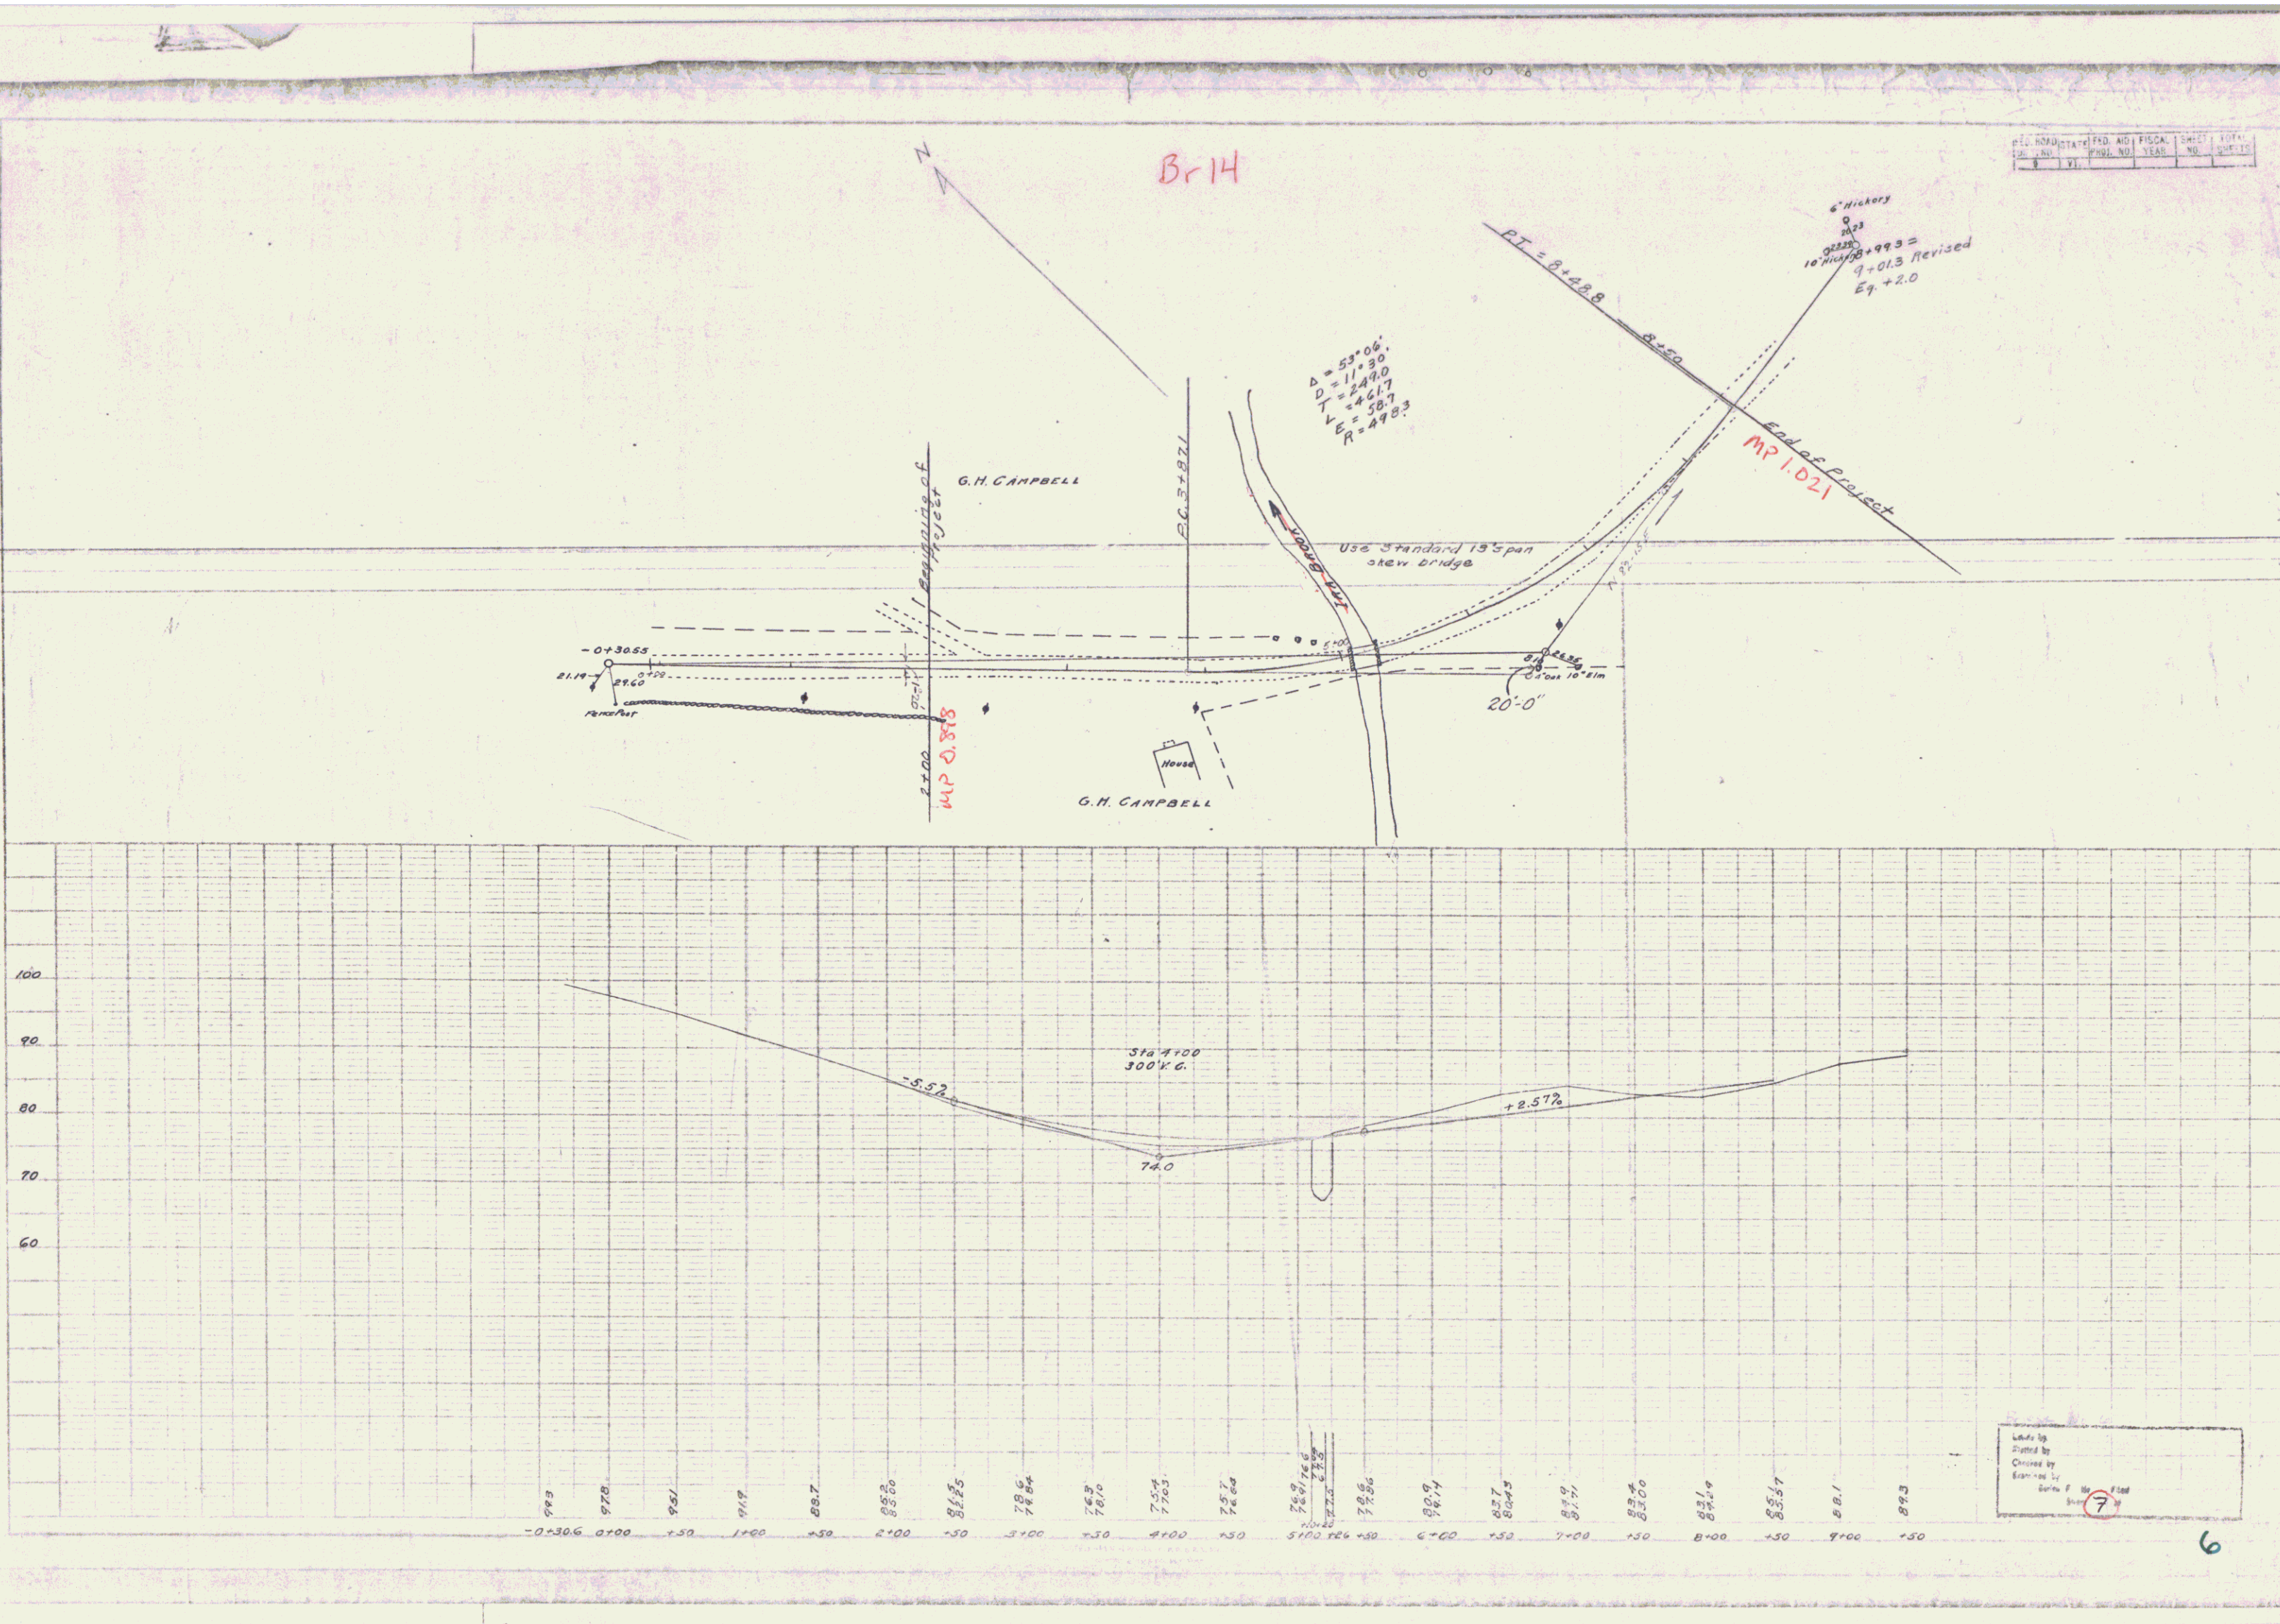

Checked by
 Drawn by
 Entered by
 Date of file
 7