FED. ROAD DIST. NO.	STATE	FED. AID PROJ. NO.	FISCAL YEAR	SHEET NO.	TOTAL SHEETS
9	VT.	50	1922	5	11

GUARD RAIL REQUIRED.

ON LEFT

Sta. 43+62 to 43+86 Length 24 Ft.

ON RIGHT

Sta. 43+62 to 43+86 Length 24 Ft.

TOTAL THIS SHEET. 48 Ft.

NEW CULVERTS REQUIRED.

Sta. 43+74 New 15" Concrete Pipe 28 Ft.
1-2:3:5 Concrete 2.0 Cu Yds.

SUB BASE REQUIRED.

Sta. 30+00 to 35+00 Length 500 Ft.

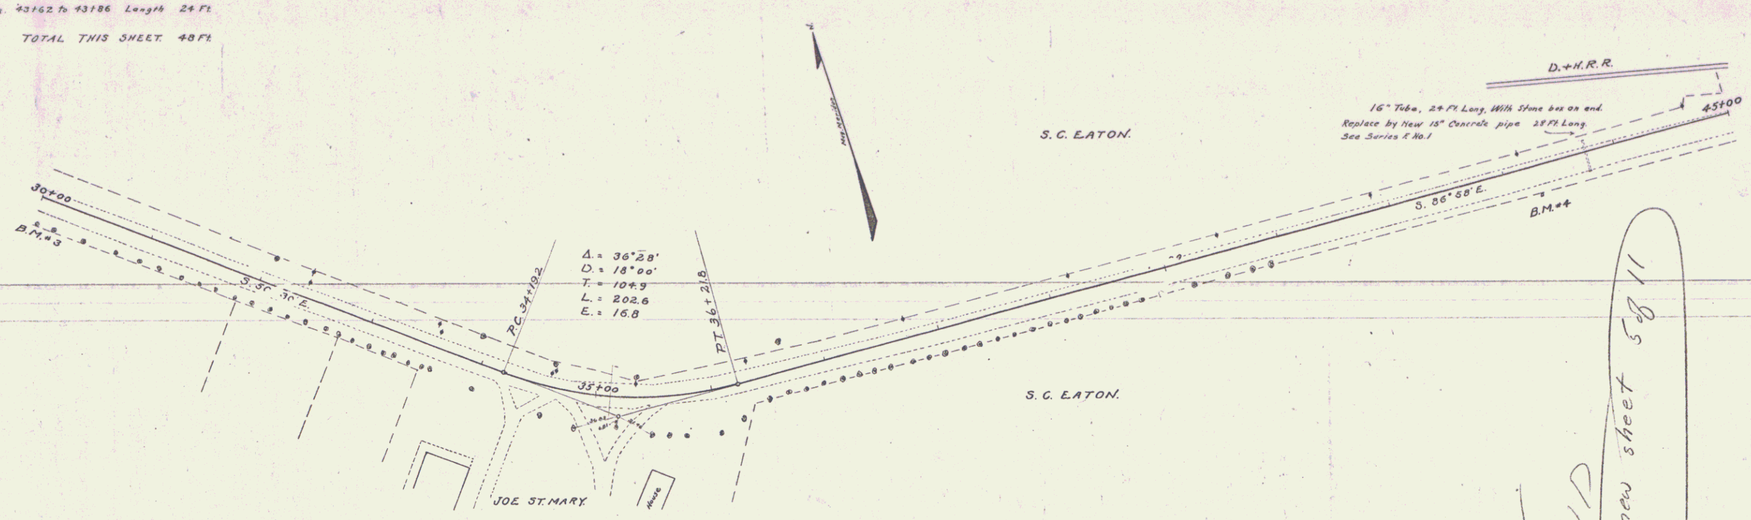

OLD
See new sheet 5 of 11

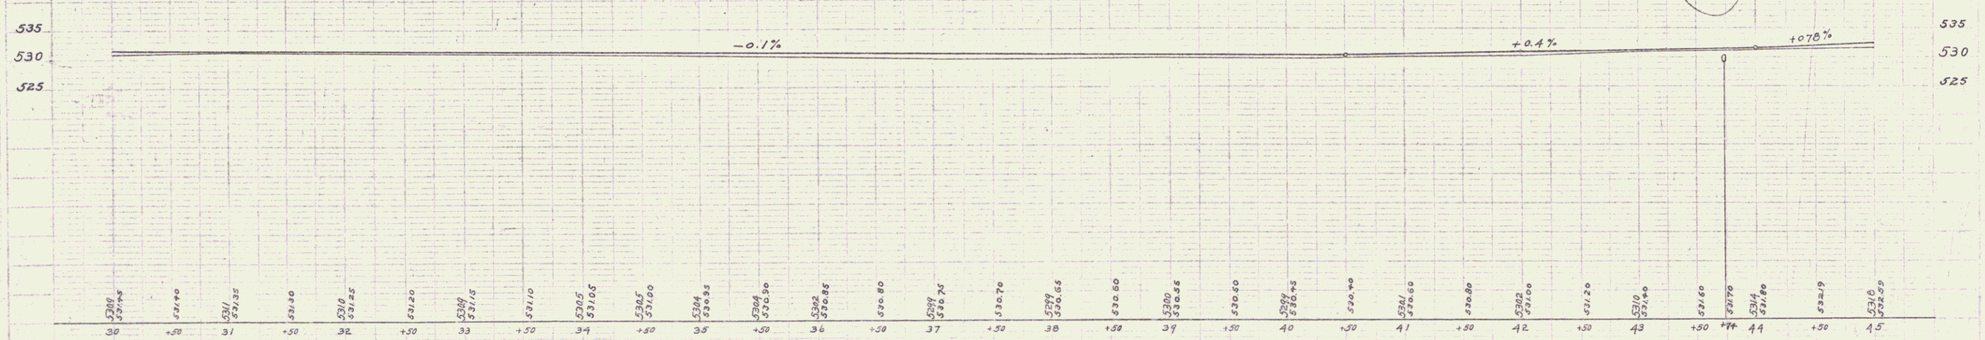

B.M.#3. Spike in Elm Tree South Side of Road. Sta. 30+00. Elev. 531.83
B.M.#4 Top of Stone in Fence Line, South of Road Sta. 43+29 Elev. 532.11

Series E No. Filed.
Sheet 3 of 11

4