FED. ROAD DIST. NO.	STATE	FED. AID PROJ. NO.	FISCAL YEAR	SHEET NO.	TOTAL SHEETS
1	VT.	6170	1962	17	72

WOOD GUARD RAIL REQUIRED
ON LEFT

STA. 213+30 TO STA. 213+58	LENGTH	~~24'~~	8'
" 213+72 TO " 213+80	"	~~24'~~	8'
TOTAL FOR SHEET			16'

On Right

213+50 - 213+58	8'
213+72 - 213+80	8'
	32'

NEW CATCH BASIN COVER REQUIRED
STA 221+50
CONCRETE CLASS A (1-2-4) ~~1.0~~ CU.YD. 0.3
REINFORCING STEEL ~~250~~ 228

— STA 221+50 : 1 DROP INLET GRATE —
THE SIZE OF THE NEW DROP INLET GRATE AT STA 221+50 TO BE SUCH THAT IT WILL SATISFACTORILY FIT THE EXISTING CATCH BASIN.

DRIVE CULVERTS
Sta 211+75 16" Corr Galv Met Pipe 28'
Conc. Cl. B (1-2½-5) 1.0 cy
Sta 213+35 16" Corr Galv Met Pipe 1.0 cy
Conc. Cl.

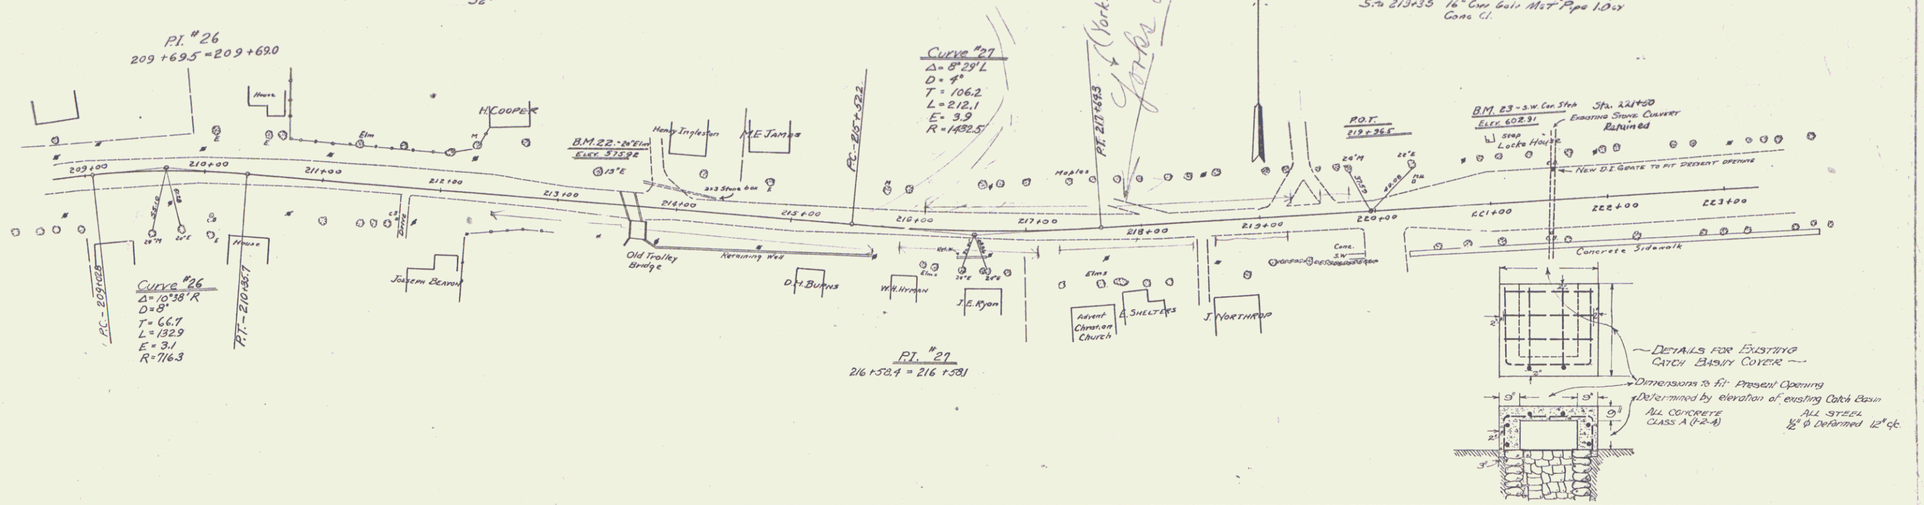

— DETAILS FOR EXISTING CATCH BASIN COVER —

NOTE: BRIDGE AT STA 213+70± TO BE REBUILT. PLANS FOR THIS BRIDGE ARE NOT INCLUDED IN THIS PROJECT BUT APPROACH SLAB DESIGN IS SHOWN ON SHEET NO. 21.

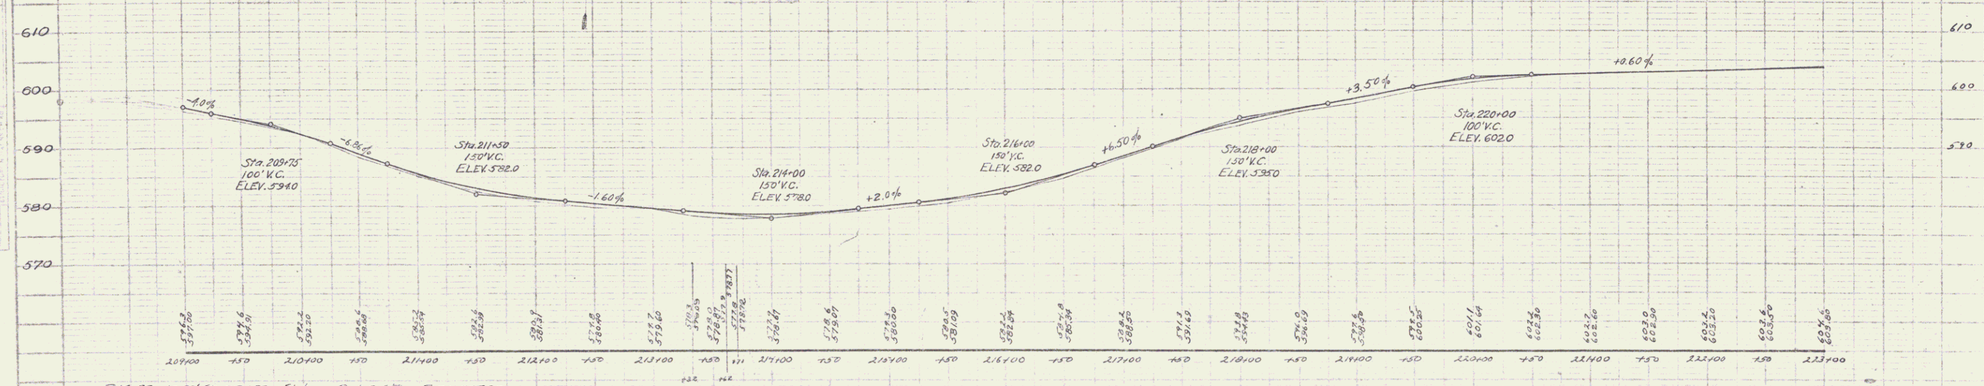

B.M. 22 Lt. 23' Sta 213+32 Spike in Root 20" Elm. ELEV. 575.92
B.M. 23 Lt. 52' Sta 221+00 S.W. Con. Conc. door step ELEV. 602.91

SERIES F NO. 650
SHEET 17 OF 72

16