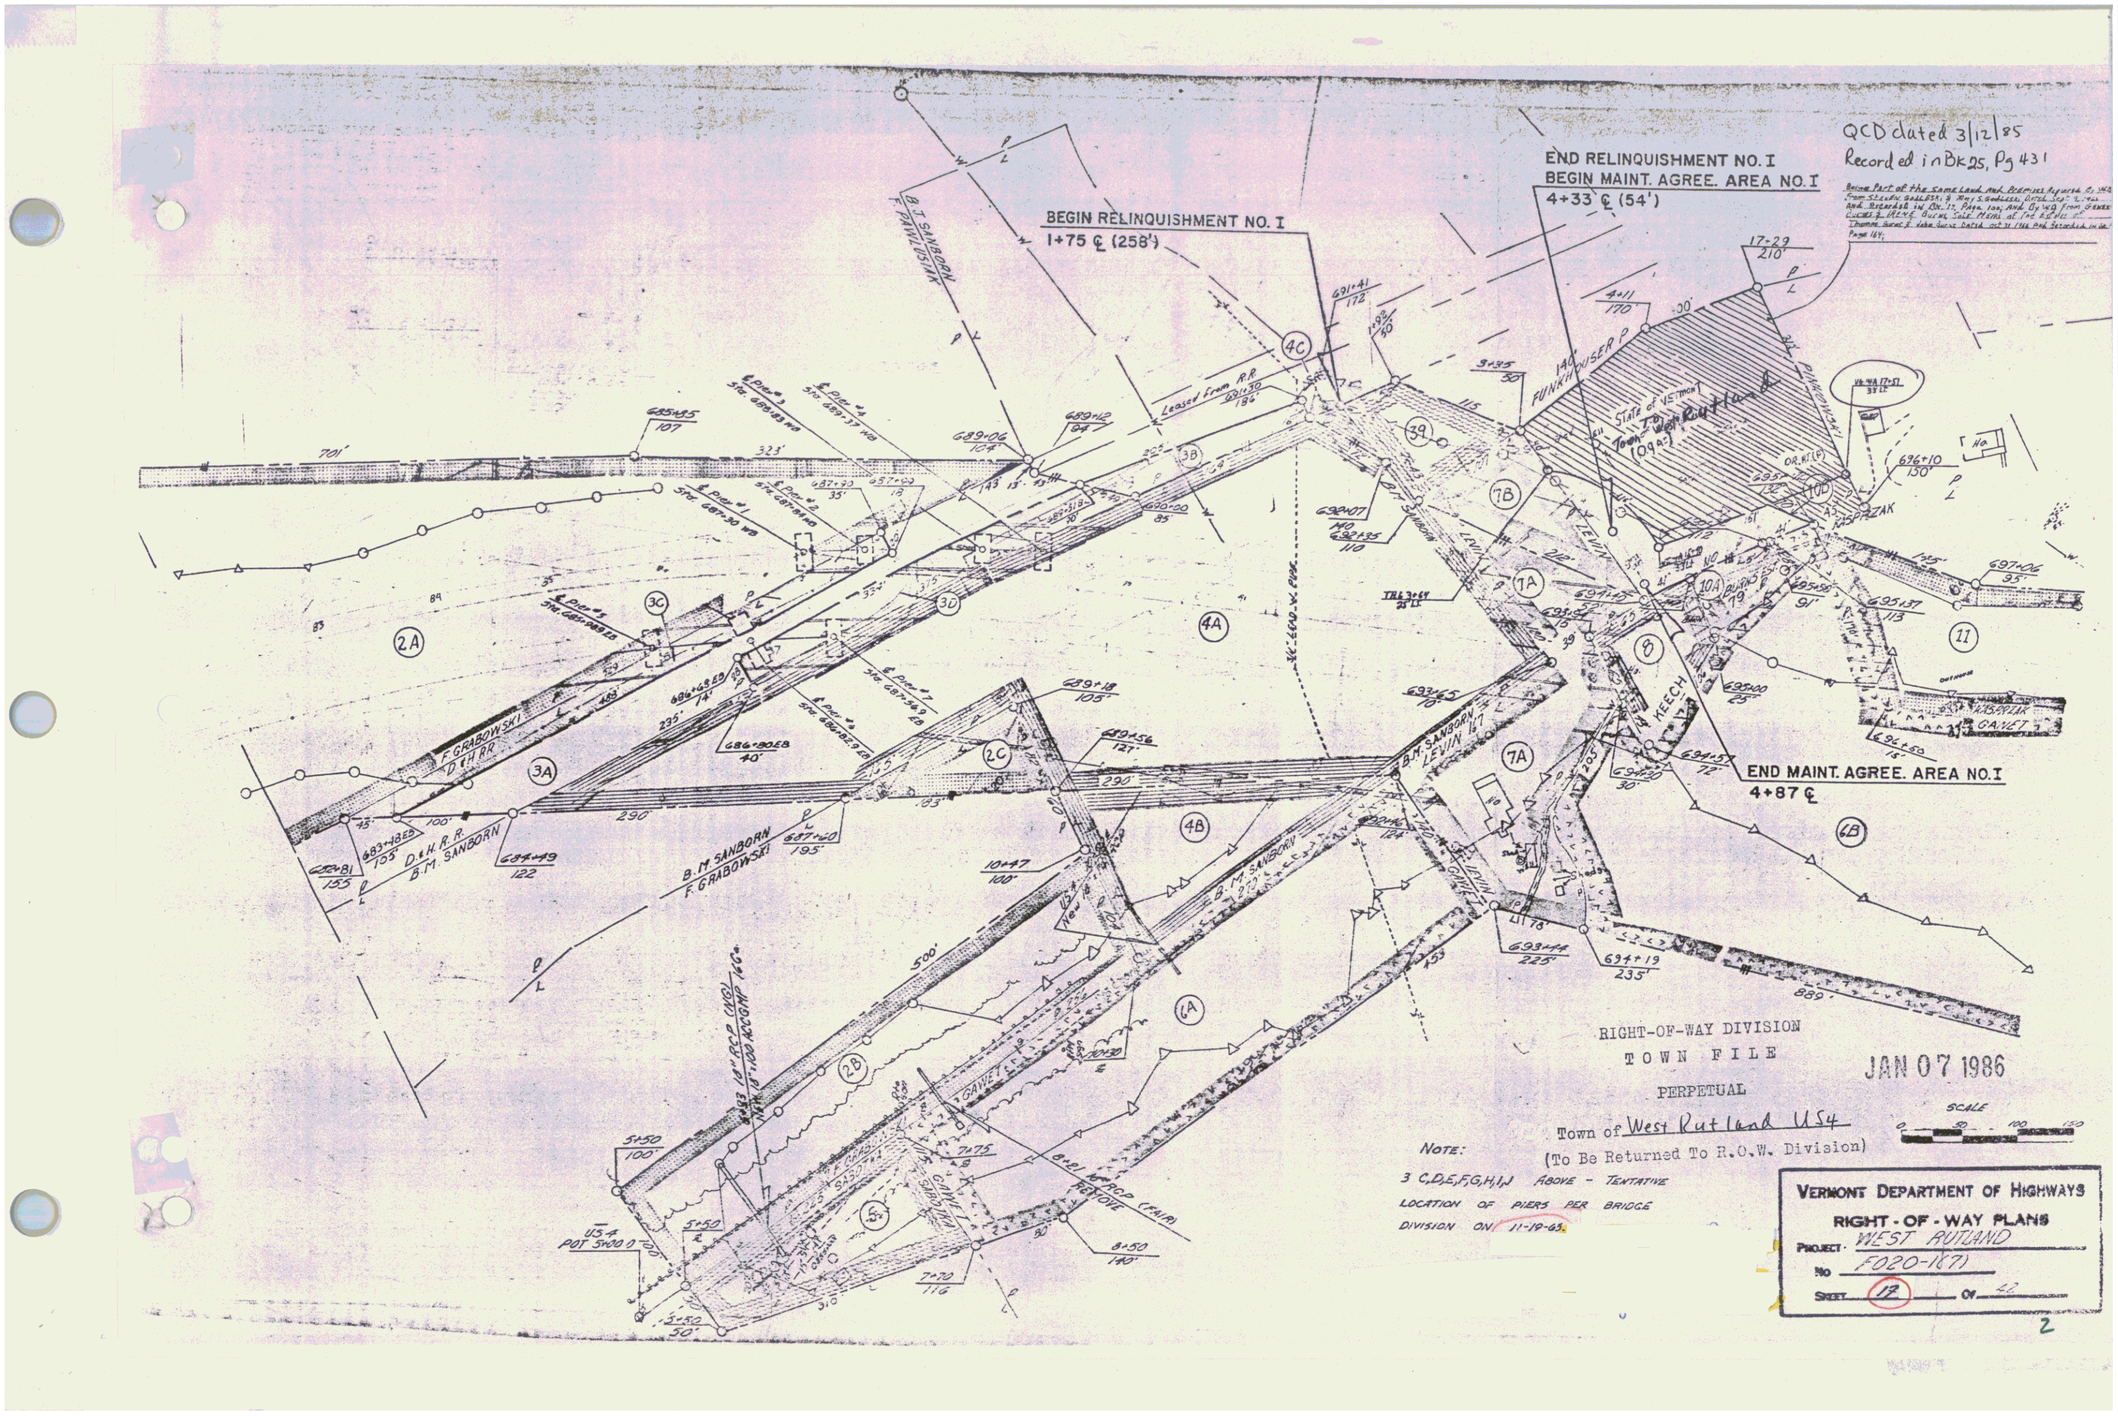
QCD dated 3/12/85
Recorded in Bk 25, Pg 431
BEGIN RELINQUISHMENT NO. I
1+75 ℄ (258')
END RELINQUISHMENT NO. I
BEGIN MAINT. AGREE. AREA NO. I
4+33 ℄ (54')
END MAINT. AGREE. AREA NO. I
4+87 ℄
B. J. SANBORN
F. PAWLESAK
FUNKHOUSER
STATE OF VERMONT
Town of West Rutland
(0.94 ac)
Leased from RR
F. GRABOWSKI
D & H. RR
B. M. SANBORN
LEVIN
KEECH
GANEY
RIGHT-OF-WAY DIVISION
TOWN FILE
PERPETUAL
JAN 07 1986
Town of West Rutland US4
(To Be Returned To R.O.W. Division)
NOTE:
3 C,D,E,F,G,H,I,J ABOVE - TENTATIVE
LOCATION OF PIERS PER BRIDGE
DIVISION ON 11-19-65.
SCALE
VERMONT DEPARTMENT OF HIGHWAYS
RIGHT - OF - WAY PLANS
PROJECT WEST RUTLAND
NO F020-1(7)
SHEET 12 OF 42