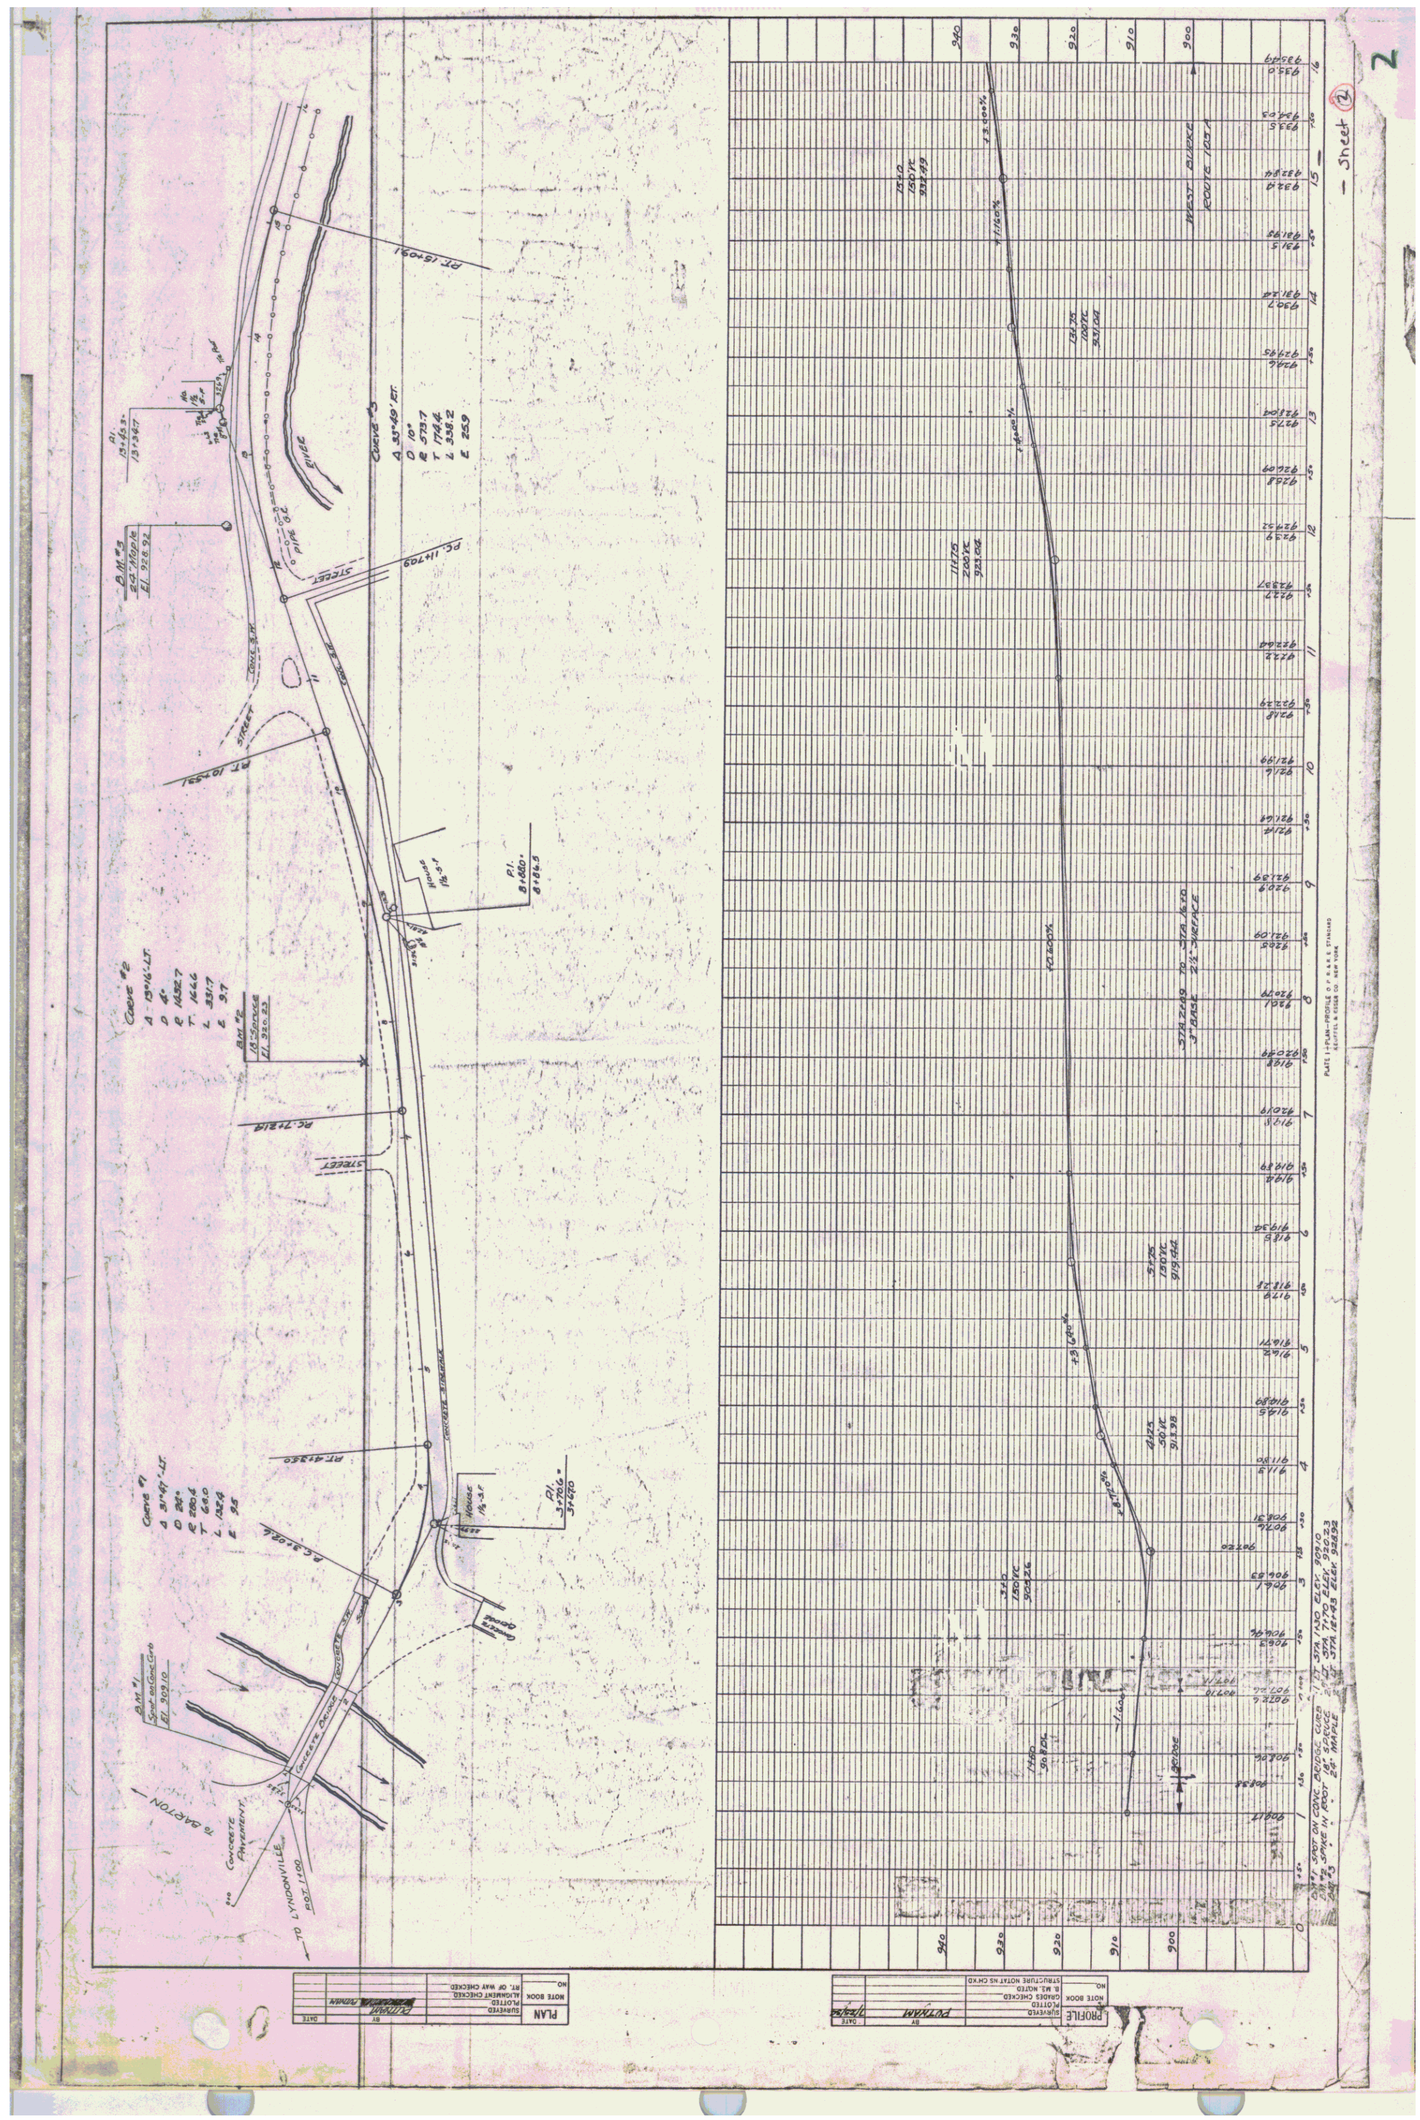
PLAN
PROFILE
STREET
CONCRETE SIDEWALK
CONCRETE CROSSWALK
CONCRETE PAVEMENT
TO BARTON
TO LYNDONVILLE
WEST BLOCK
ROUTE 100A
STA. 22+00 TO STA. 16+00
3" BASE 2½" SURFACE
Sheet 2