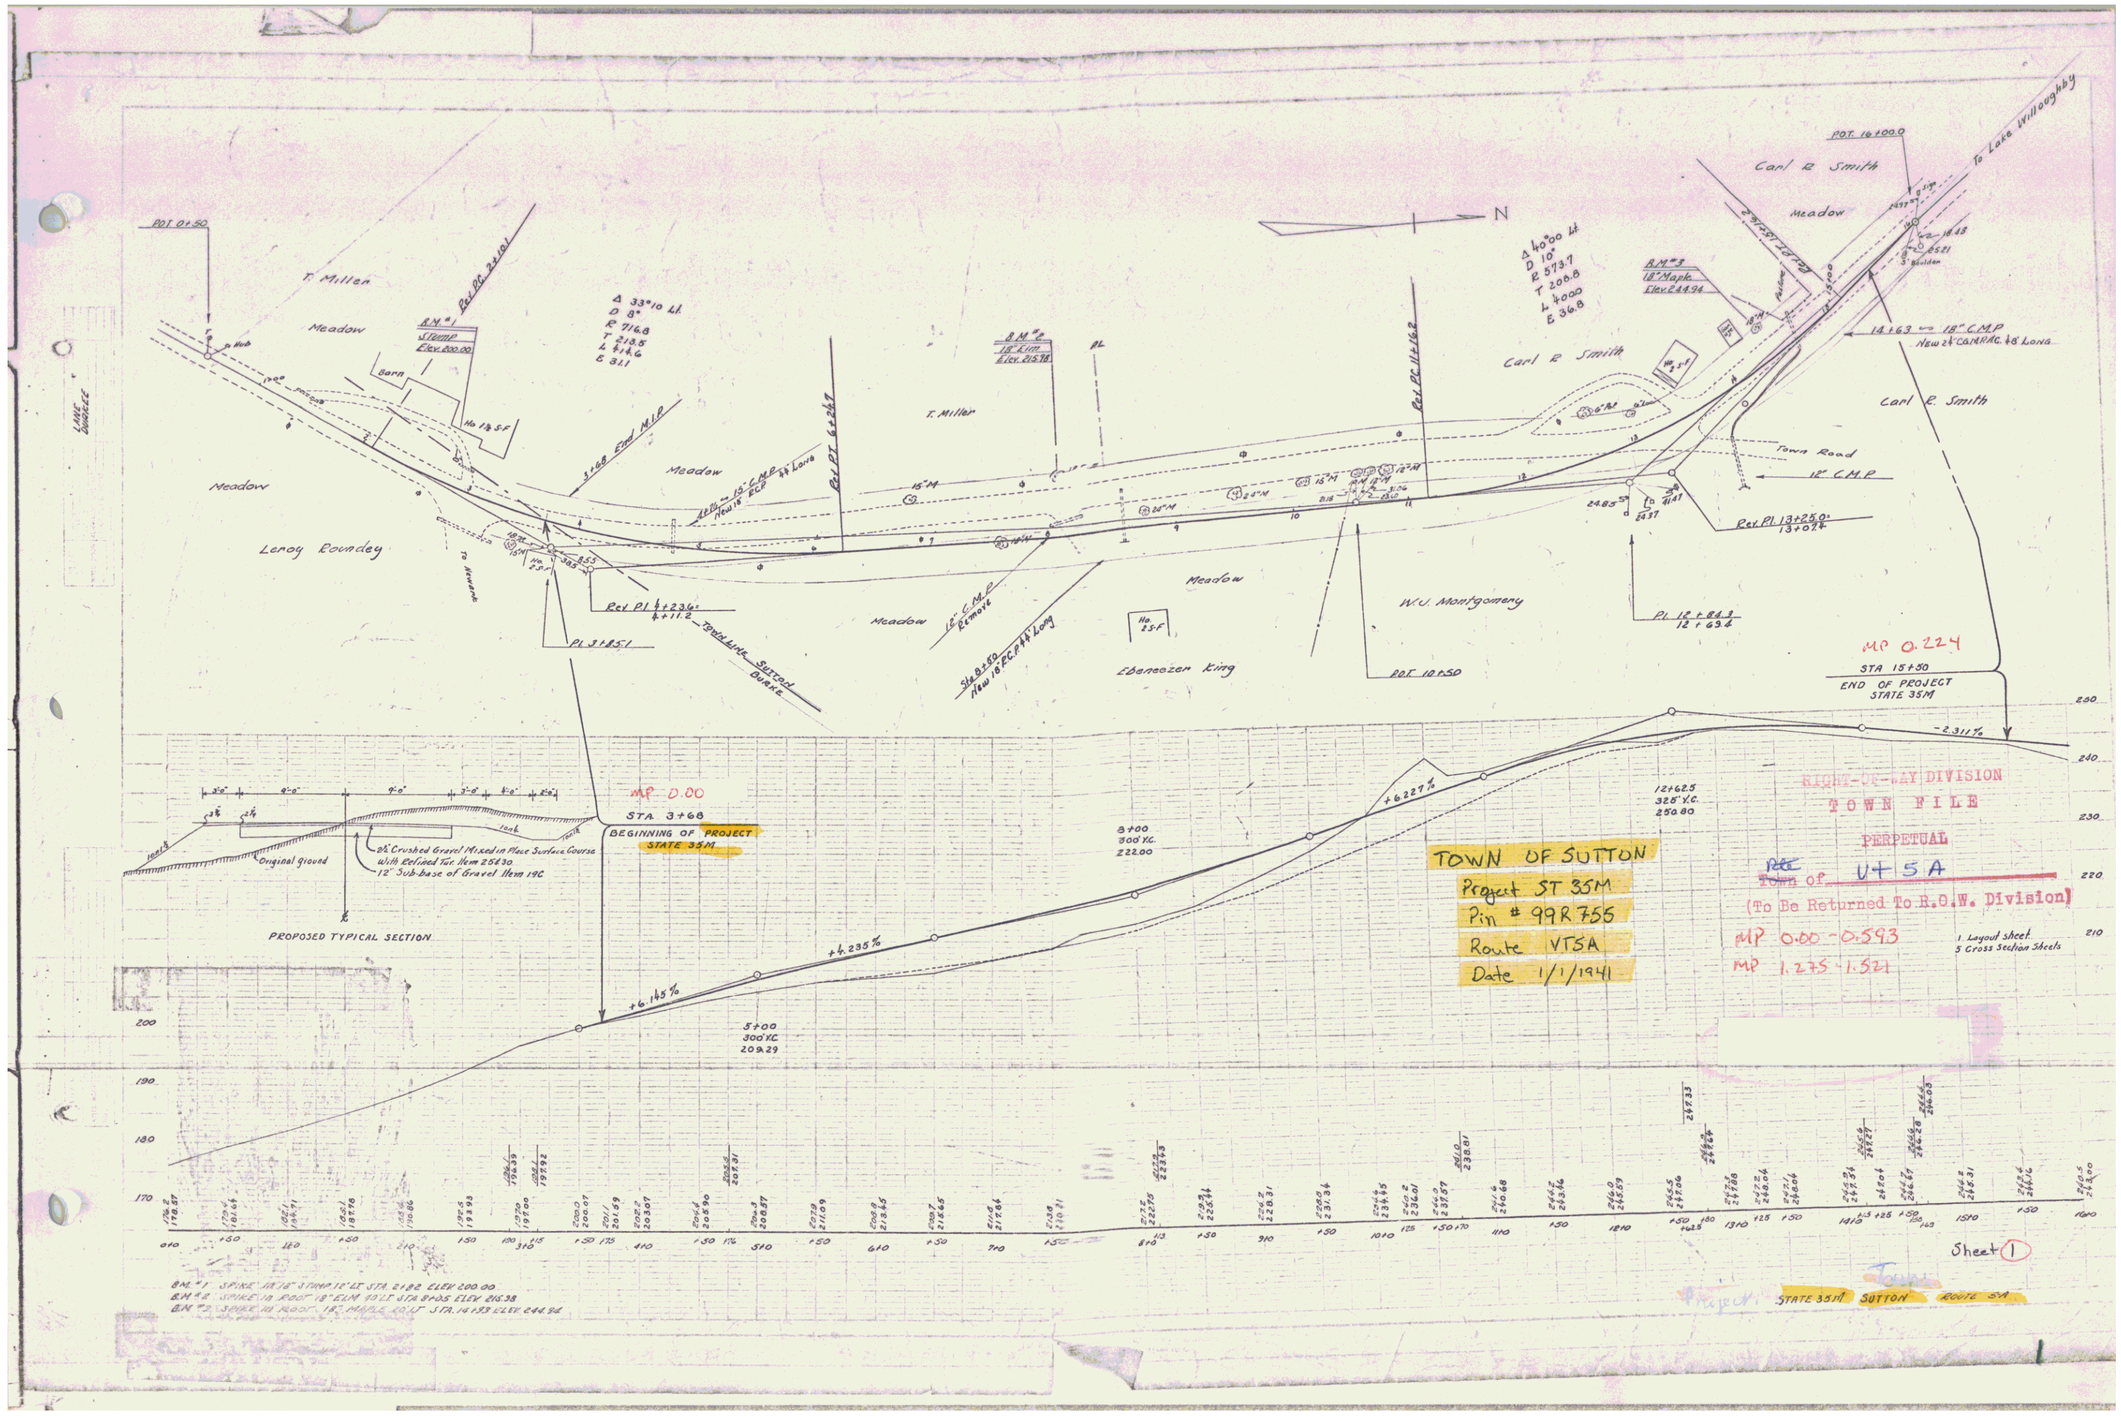
POT 01+50
T. Miller
Meadow
R.M. #1
Stump
Elev. 200.00
Barn
Ho 1½ S.F.
Meadow
Leroy Boundey
Pl 3+85.1
Meadow
T. Miller
R.M. #2
18" Elm
Elev. 215.98
Meadow
Meadow
Ebenezer King
W.J. Montgomery
POT 10+50
Carl R Smith
Meadow
R.M. #3
18" Maple
Elev. 244.94
Carl R Smith
Carl R. Smith
Town Road
12" C.M.P.
Pl 12+63.3
12+63.4
POT 16+00.0
To Lake Willoughby
14+63 — 18" C.M.P.
New 24" CONTRAC. 48' Long
MP 0.224
STA 15+50
END OF PROJECT
STATE 35M
MP 0.00
STA 3+68
BEGINNING OF PROJECT
STATE 35M
Original Ground
2" Crushed Gravel Mixed in Place Surface Course
with Refined Tar Item 25830
12" Sub-base of Gravel Item 19C
PROPOSED TYPICAL SECTION
+6.145%
+6.227%
-2.311%
5+00
300' V.C.
209.29
8+00
300' V.C.
222.00
12+62.5
325' V.C.
250.80
TOWN OF SUTTON
Project ST 35M
Pin # 99R755
Route VT5A
Date 1/1/1941
RIGHT-OF-WAY DIVISION
TOWN FILE
PERPETUAL
Town of VT 5A
(To Be Returned To R.O.W. Division)
MP 0.00 - 0.593
MP 1.275 - 1.521
1 Layout sheet
5 Cross Section Sheets
Sheet 1
Project STATE 35M SUTTON ROUTE 5A