PARCEL	INSTRUMENT	DATE	GRANTOR	GRANTEE	RECORDED	BOOK	PAGE	DATE	REMARKS
2	Co. Judgement Order	3-14-55	Louis D. & Howard G. Shonyo	St. of Vt.	Orleans Co. Court			3-14-54	See Hearing Report
1	Cond.	7-23-54	Clayton E. & Alberta C. Fisher	St. of Vt.	Westmore	20	169-170	7-24-54	
2A	WDOE	12-20-55	Ellsworth H. Lewis & Norman L. Scott	St. of Vt.		20	291-292	1-28-56	

THREE CABLE GUARD RAIL WITH STEEL POSTS Sta. 4+50 Lt to Sta. 16+00 Lt

REMOVAL AND DISPOSAL OF PRESENT GUARD RAIL 4+50 Lt - 13+44 Lt; 14+56 Lt - 16+00 Lt

See also sheets 10, 11

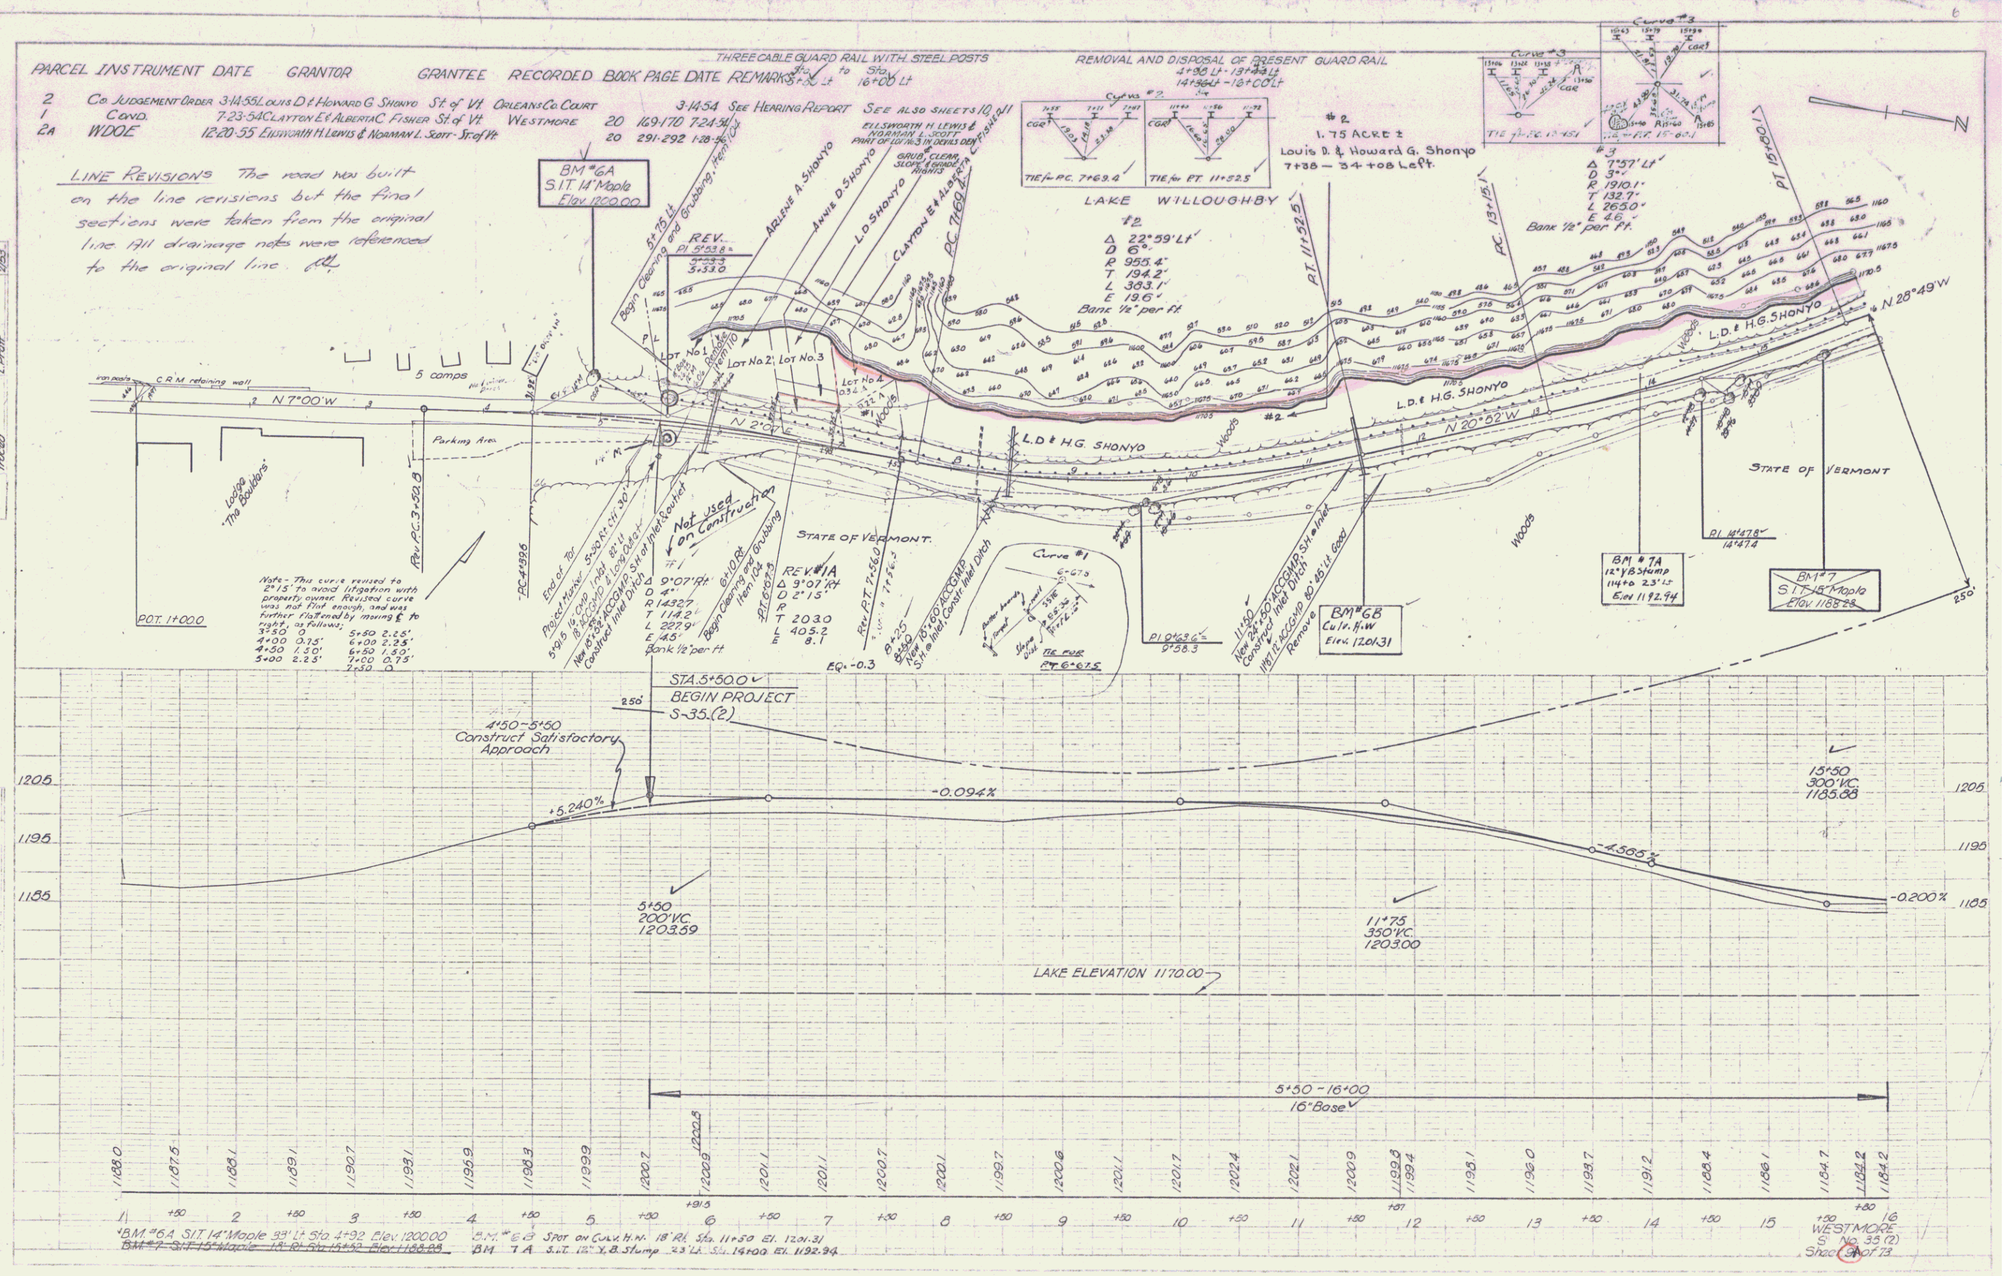

3