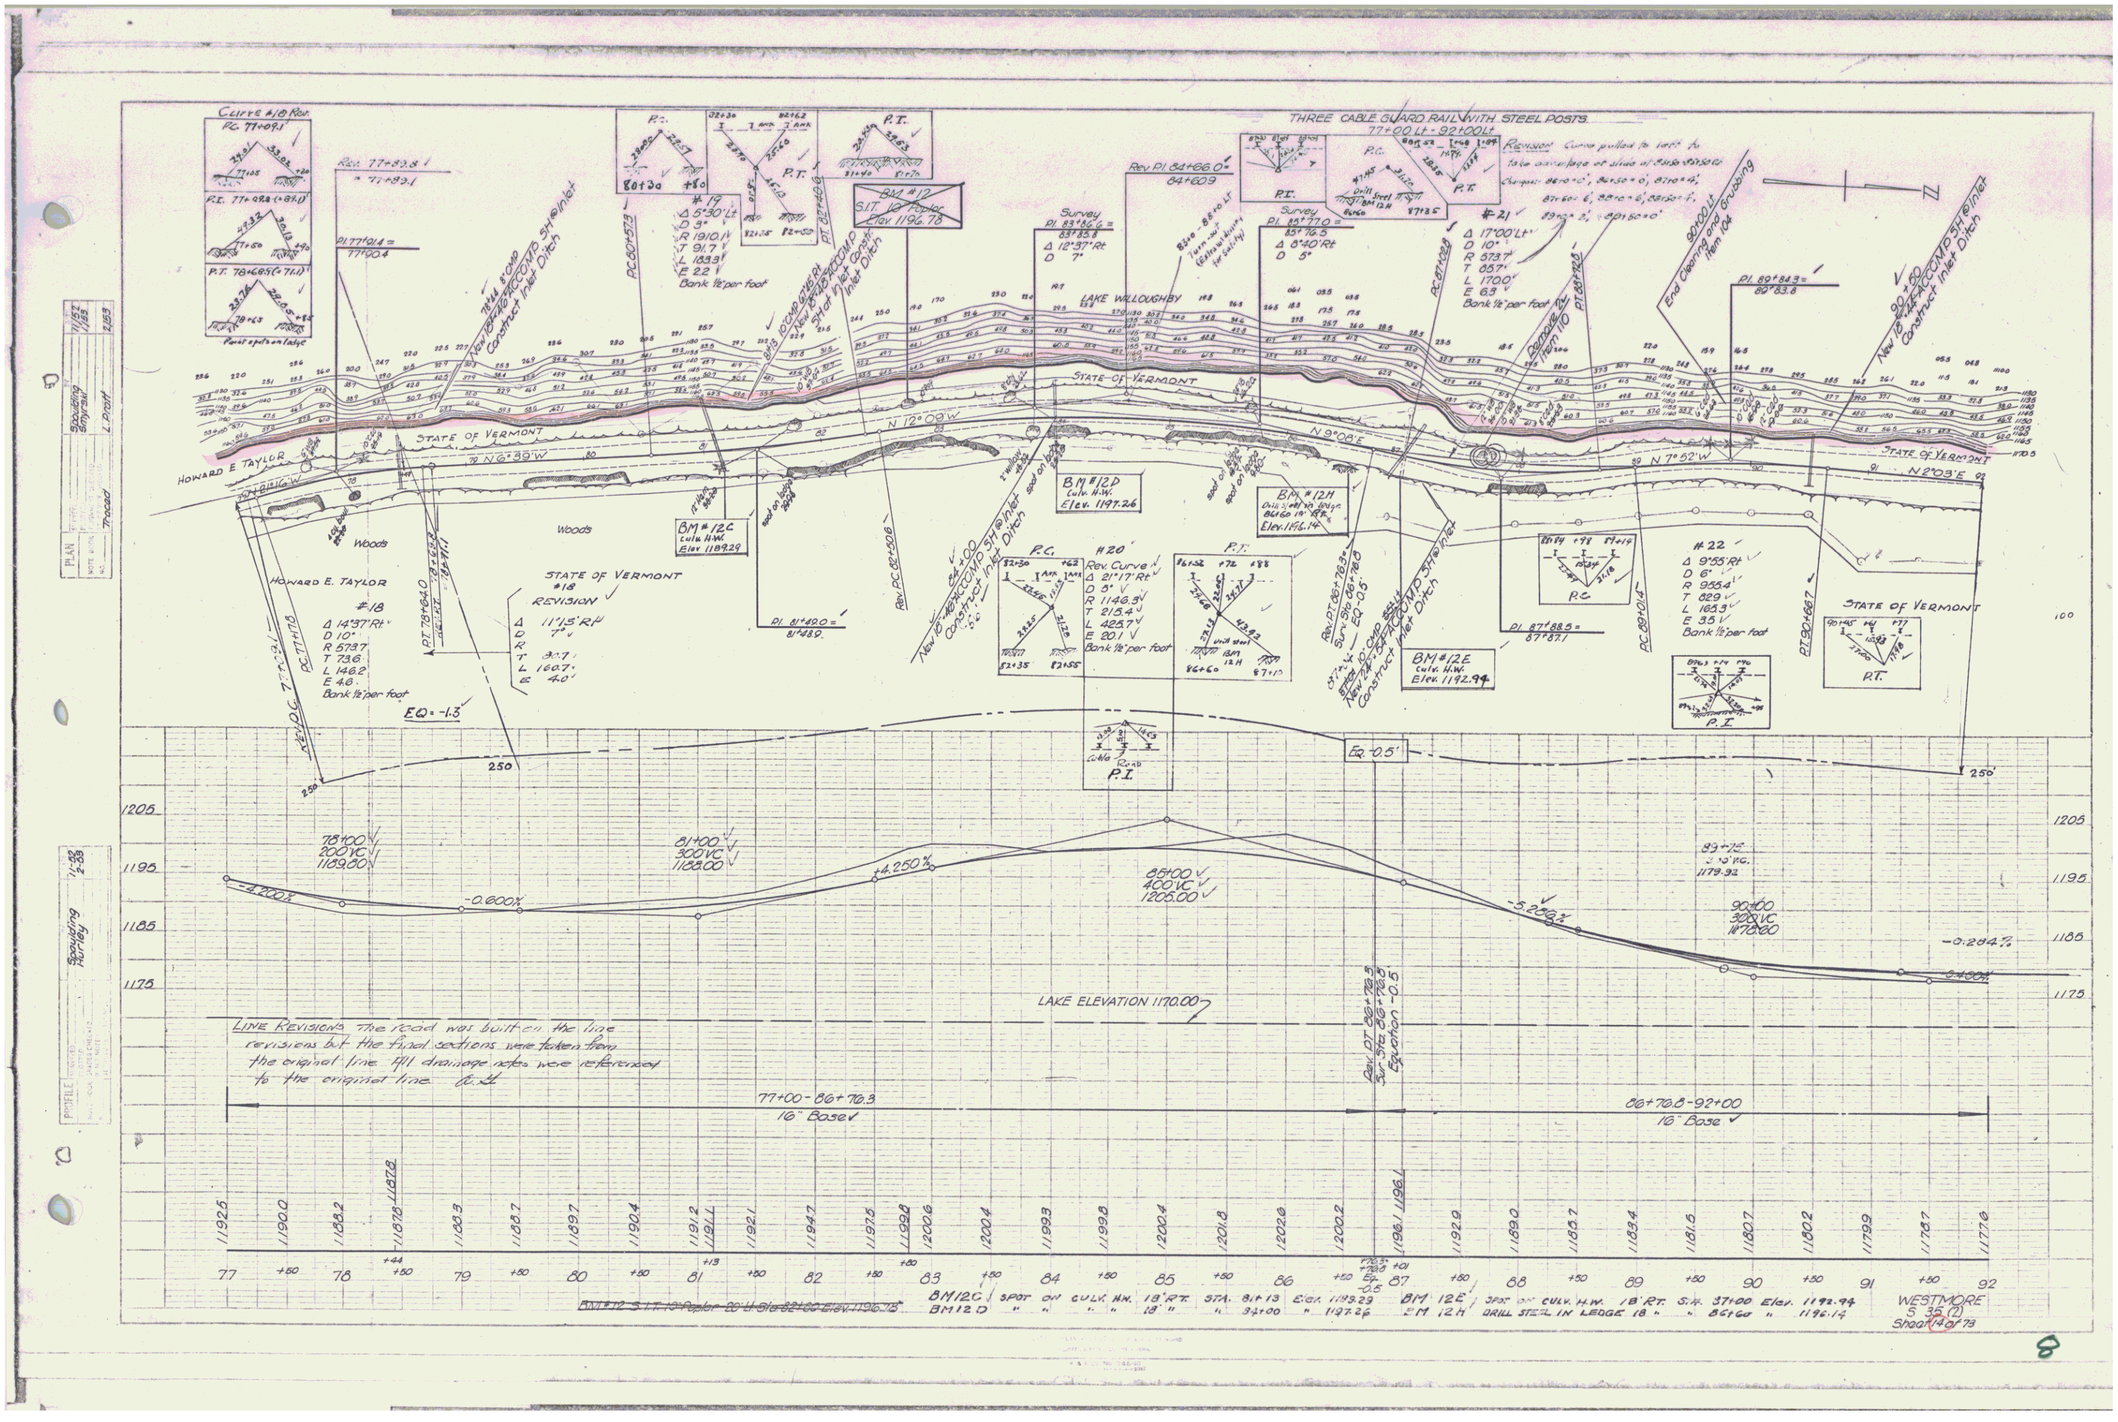
THREE CABLE GUARD RAIL WITH STEEL POSTS
77+00 Lt - 92+00 Lt
LAKE WILLOUGHBY
STATE OF VERMONT
HOWARD E. TAYLOR
Woods
#18
#19
#20
#21
#22
BM #12 S.I.T. 10" Poplar Elev. 1196.78
BM #12C Culv. H.W. Elev. 1189.29
BM #12D Culv. H.W. Elev. 1197.26
BM #12E Culv. H.W. Elev. 1192.94
BM #12H Drill steel in ledge 18" Rt. Elev. 1196.14
New 18" ACCOMP. Stone Inlet Construct Inlet Ditch
End Cleaning and Grubbing Item 104
LINE REVISION: The road was built on the line revisions but the final sections were taken from the original line. Fill drainage notes were referenced to the original line. J.E.H.
77+00 - 86+70.3 16" Base
86+70.3 - 92+00 16" Base
LAKE ELEVATION 1170.00
WESTMORE S 38 (2) Sheet 14 of 73