NON-GOVERNMENT PARTICIPATION
184+48' Install sleeve for water pipe across roadway from 123' Rt. Sleeve to be furnished by prop. owner.

THREE CABLE GUARD RAIL WITH STEEL POSTS
185+[illegible] - 185+[illegible] Lt 185+[illegible] - 185+[illegible] Rt
09 31 21 71

CONSTRUCT APPROACH
184+00 - 185+[illegible] Rt.
23

STEEL GUIDE POSTS
181+28 - 183+53 Lt. 15

CONSTRUCT DRIVES
183+00 Lt. 182+35 Rt.
25
184+12 - 184+23 Lt.

CONSTRUCT TURNOUT
179+00 - 181+50 Lt.

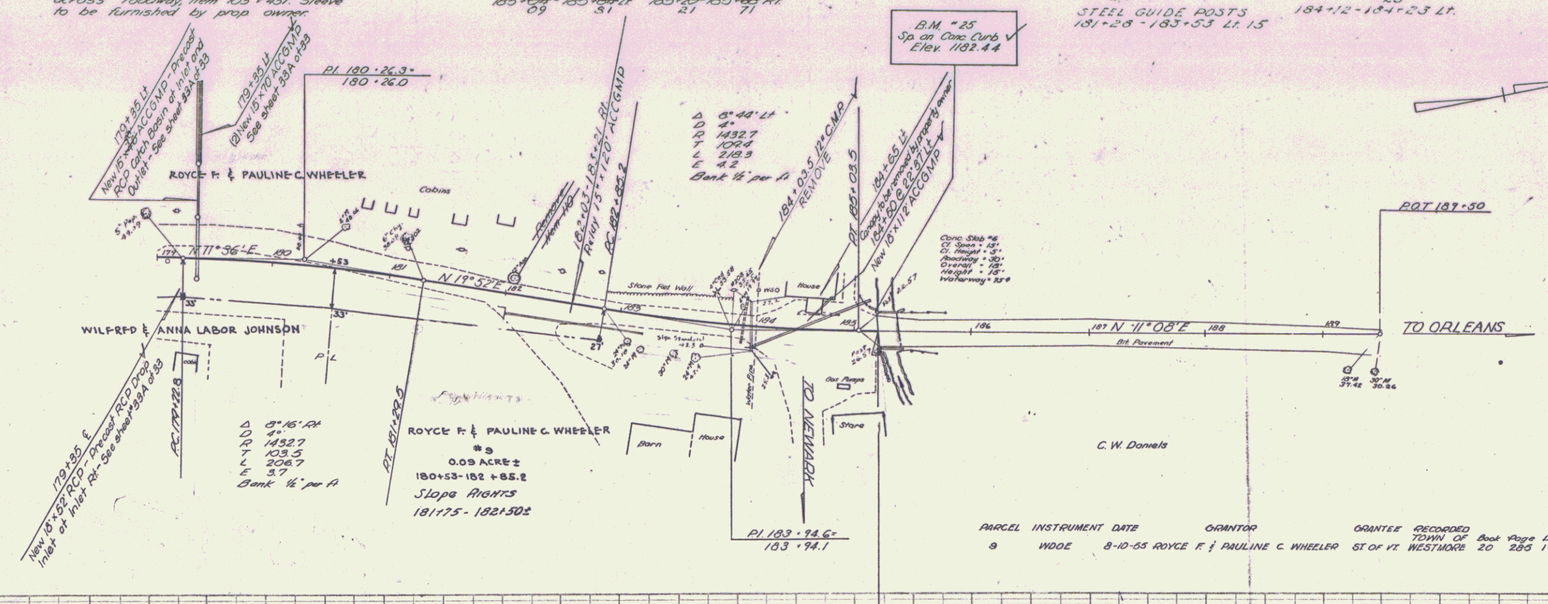

PARCEL	INSTRUMENT	DATE	GRANTOR	GRANTEE	RECORDED TOWN OF	Book	Page	Date	REMARKS
9	WDOE	8-10-65	ROYCE F. & PAULINE C. WHEELER	ST OF VT.	WESTMORE	20	285	1-6-66	Also culvert rights & ROW to Willoughby Lake.

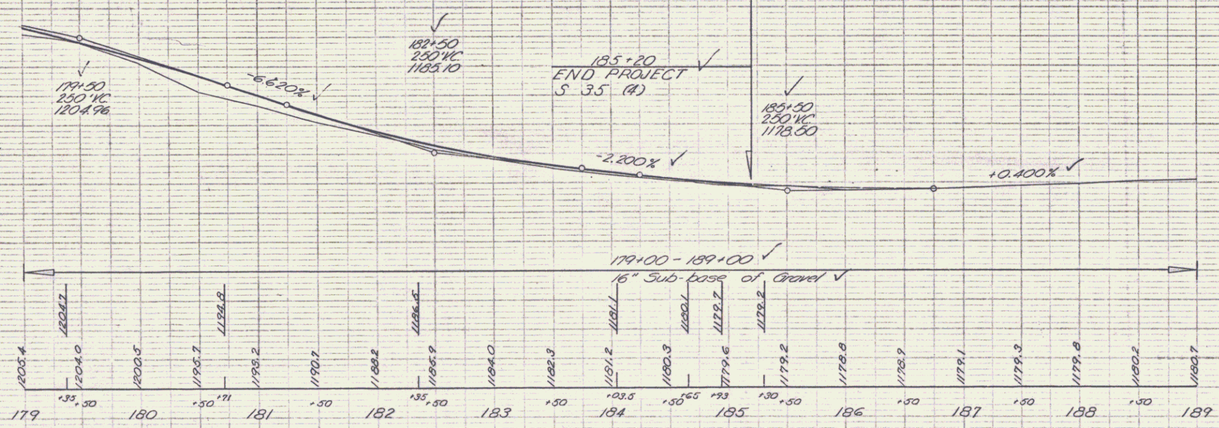

B.M. #25 Sp. on conc. curb 17' Lt Sta. 185+19 Elev. 1182.44

WESTMORE
S 35 (A)
Sheet 17 of 33

6