FED. ROAD DIST. NO.	STATE	FED. AID PROJ. NO.	FISCAL YEAR	SHEET NO.	TOTAL SHEETS
8	VT.	124-A	1938	18	128

WOOD GUARD RAIL REQUIRED

CULVERT STATION	LEFT	RIGHT
549+81	24'	24'
554+15	24'	24'

DRIVEWAY PIPE CULVERTS REQ'D

Sta.	Pipe	Dia.	Rel'ng	L.Rm.
552±	RY	10" CMP	24'	2 cy

NEW CONC. CONCRETE PIPE CULVERTS REQUIRED

Station	Diam.	Leng.	Conc. A.	Conc.	Bar Steel
549+18	36"	44'	4.4 cy	5.0	63 lbs.

GROUTED COBBLE GUTTER REQUIRED

Station	L or R	Width	Area
~~547+00~~	~~Left~~	~~3'~~	~~1 sq. yd.~~

NEW REINF. CONC. BOX CULV. REQ'D

Sta.	Size	Conc. "A"	Reinf. Steel
554+13	4'-5"	24.5 cy	2226#

INTEGRAL CURB USED

Sta.	Ht.	Length
545+90-546+60 Lt.	2"	150'
548+00-551+50 Lt.	2"	350'
545+30-545+25 Lt.	2"	25'

METAL DROP INLETS USED
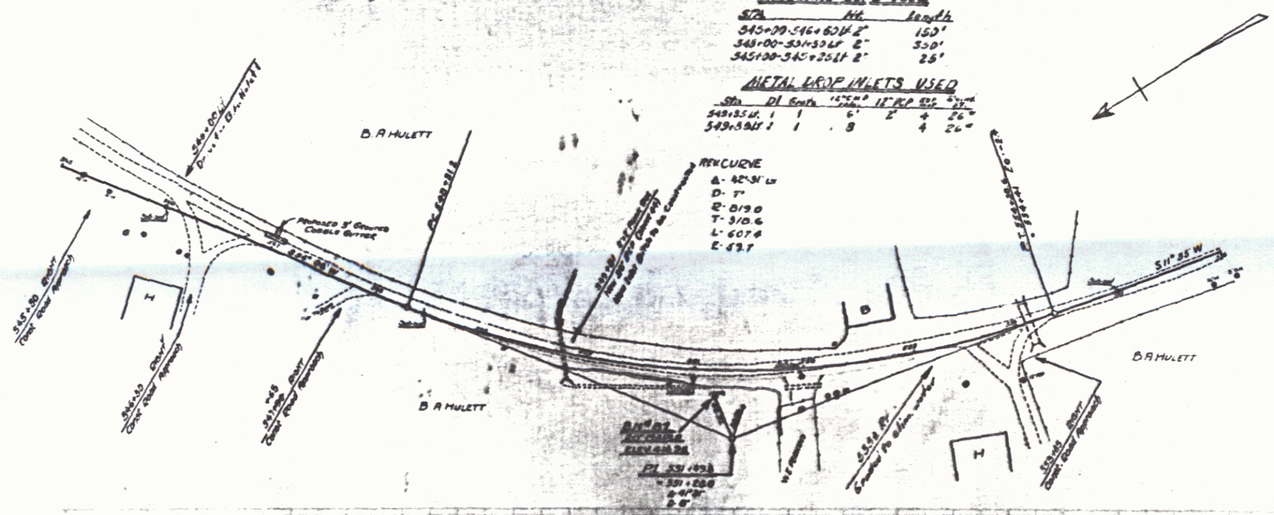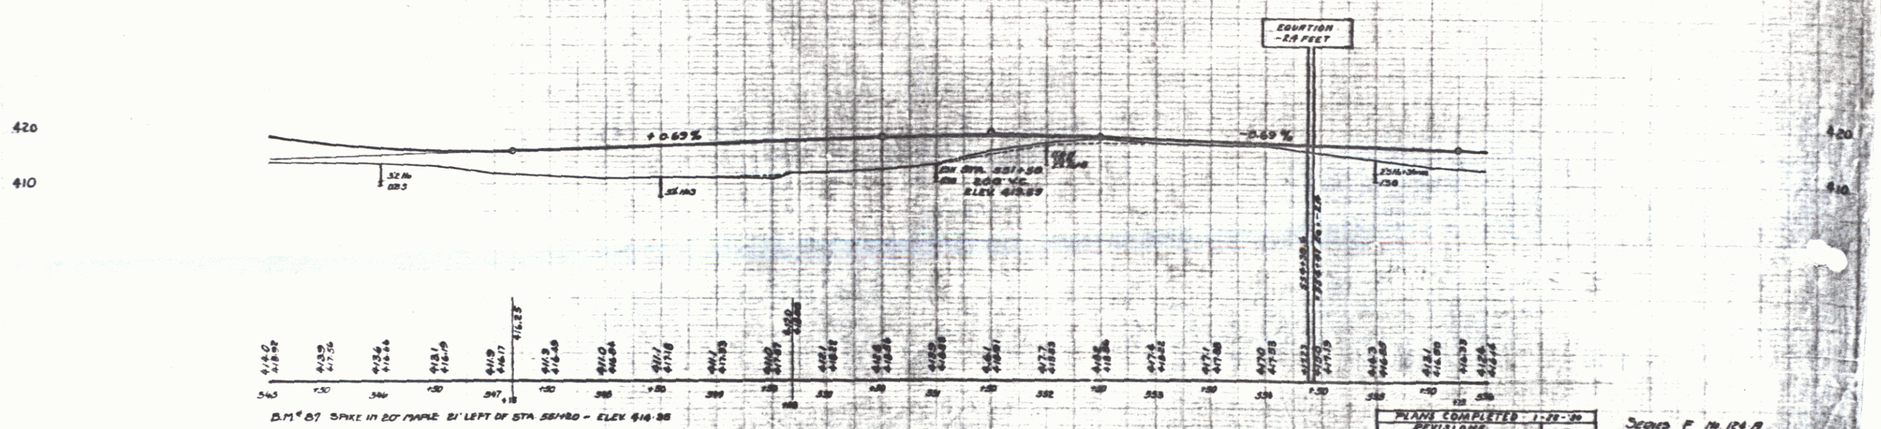
Sta.	DI	Grate	15" C.M.P. Inlet	12" R.C.P. Out	Grate
549+35 Lt.	1	6'	2	4	26"
549+50 Lt.	1	8	4	4	26"