CABLE GUARD RAIL REQUIRED

STATIONS	LEFT	RIGHT
860+60-860+90	24'	24'
861+67-861+81	24'	24'
3 at 32'	64'	64'

Includes 14' on br. fgs

CABLE RAIL TO BE CONSTRUCTED ACROSS BRIDGE

RIP-RAP FOR BANK PROTECTION

STATION	LINE	LENG.
868+75-868+85	Br.	20 L.F.
853+93-854+46	Rt.	55 - 8 -

DRIVEWAY PIPE CULVERTS REQUIRED

Station	Pos.	Dia.	Length	C.R.M.
854+35	Lt.	12"	28'	2.3 c.y. (C.M.P. 26.0)
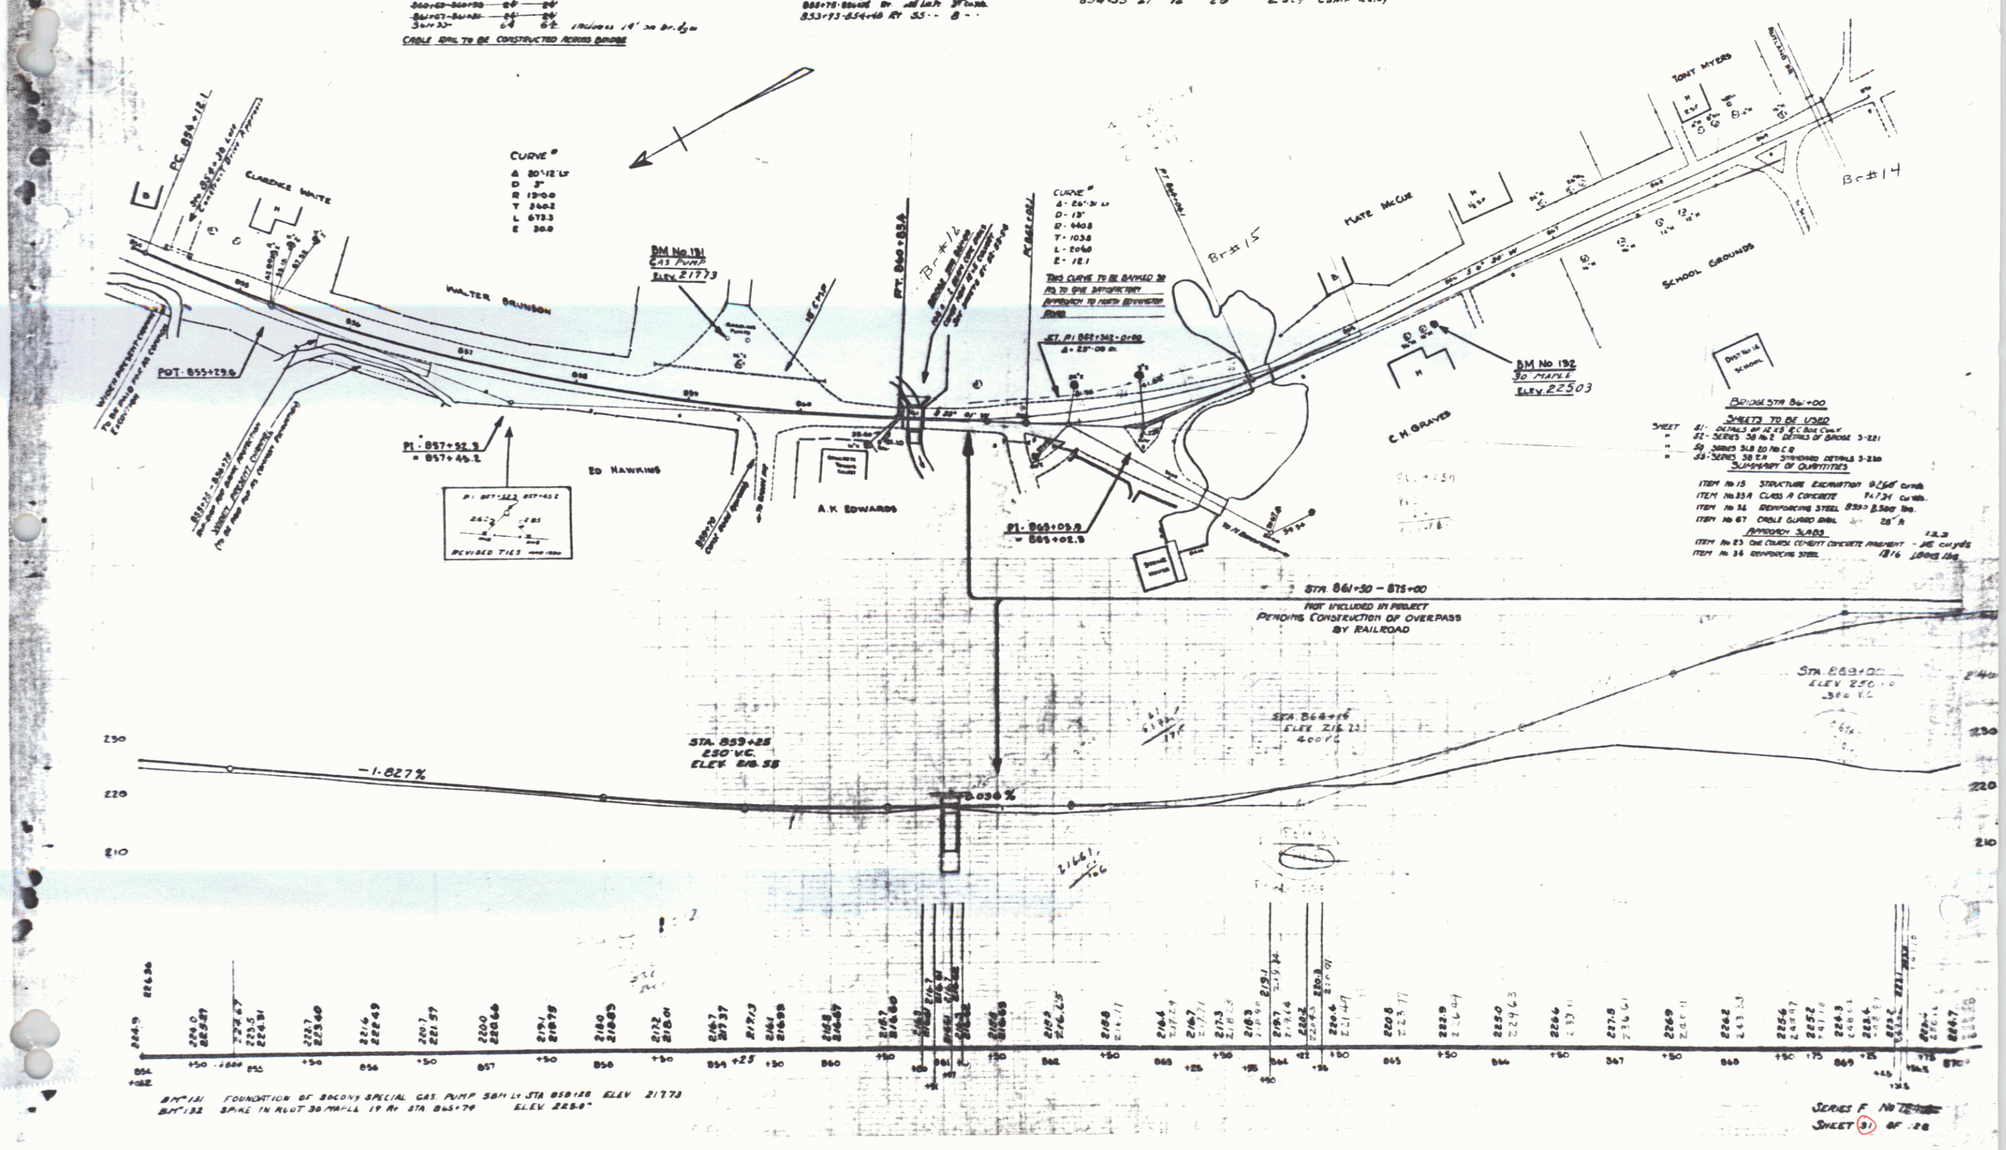
124 A 1930 36