Wood Guide Posts Req'd

Station	Lt	Rt
913+45		1

Concrete Steps Req'd.

Station	Pos	Conc "A"	Reinf. St.
9[illegible]+65	Rt	0.8	34#

Cement Rubble Masonry Wall

Station	Pos.	Length	CRM
908+77	R	12'	1.1 c.y.

Cable Guard Rail Required

Station to Station	Left	Right
908+45 — 910+67	152'	
908+08 — 911+00		192'
909+00 — 911+00		200'
909+15 — 912+11	296'	

New Reinf Concrete Pipe Culverts Required

Station	Diam	Leng	Conc A	Conc C	Reinf Steel
909+60	30"	66'	17/27 c.y.	–	38/66 lbs

Integral Curb Used

Stations	Ht	Length
908+15 - 912+20	2	405'

Driveway Pipe Culverts Required
(Corr Galv Metal Pipe)

Station	Lt or Rt	Diam	Leng	Cement Rubble Masonry
907+75	Lt	12"	20'	1/4 c.y.

Standard Underdrain With Vitrified Clay Pipe

Stations	Pos.	Length	CRM
913+54 - 915+00	L	146'	0.3 c.y.

124 A 1930 34

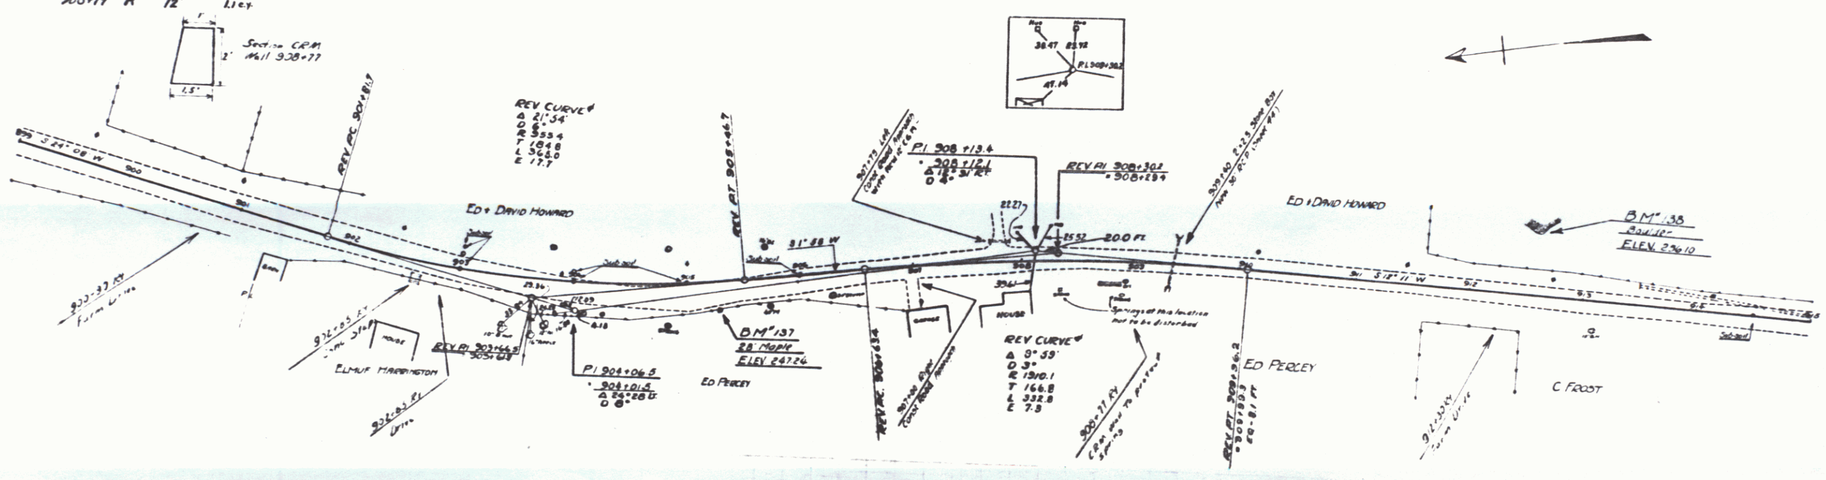

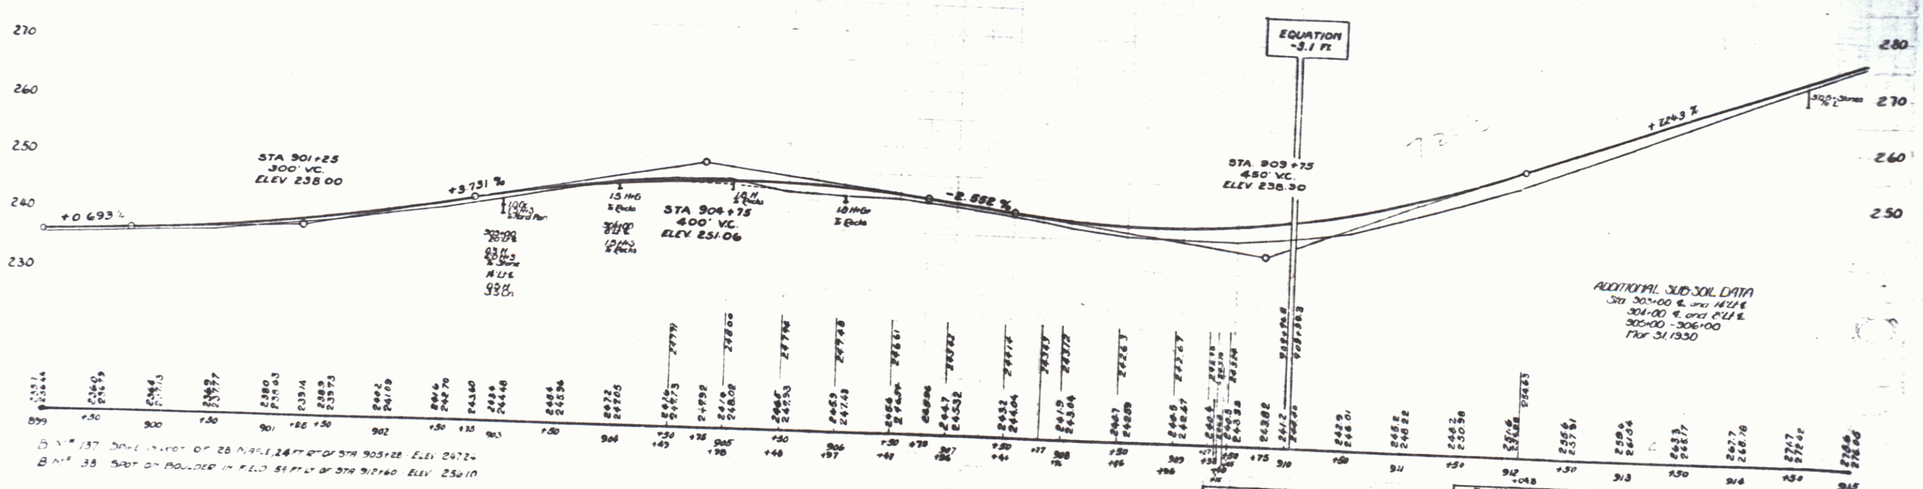

Revisions	Date
Pl 908+13 changed to 908+14.6 Crv revised Pvt At.	4-3-30

Plans Completed	
Revisions	Date
Pl 908+14.6 Tied back	4-3-30
Curve changed from 908+30 to 908+34	4-3-30

Series F No. 124-A
Sheet 34 of 128