Wood Guard Rail Required		
Culvert Station	Left	Right
1002 + 72	—	26'

Wood Guide Posts Required		
Culvert Station	Left	Right
1002 + 72	1	—

New 18" Concrete Pipe Culverts Required

Station	Diam	Leng	Class A Conc	Diam Steel	D.I.	Precast Tap
1002+72	18"	60'	[illegible]	—	1	1

Driveway Culverts Required (Cond. Galv. Metal Pipe)

Station	Lmr	Diam	Leng	Orient Rural Mailbox
1000+63	Lt.	18"	16'	[illegible]

Grouted Cobble Gutter Required

Station	Lmr	Width	Leng	Area
~~1000+50–1000+00~~	~~Lt.~~	~~8.4~~	~~500'~~	~~4,200 sq.yds.~~
~~1006+00–1000+00~~	~~Rt.~~	~~8.4~~	~~600~~	~~5,040 sq.yds.~~
1002+64–1006+01	Lt.	Avg.	532'	383 sq.yds.
1005+16–1005+76	Rt.	5'	76'	42 sq.yds.
1005+16–1006+03	Rt.	Avg.	226'	126 sq.yds.

Stamping Underdrain - Vit. Centering

Sta.	Lmr	Length
1001+50–1003+50	L.	50

124 A 1930 40

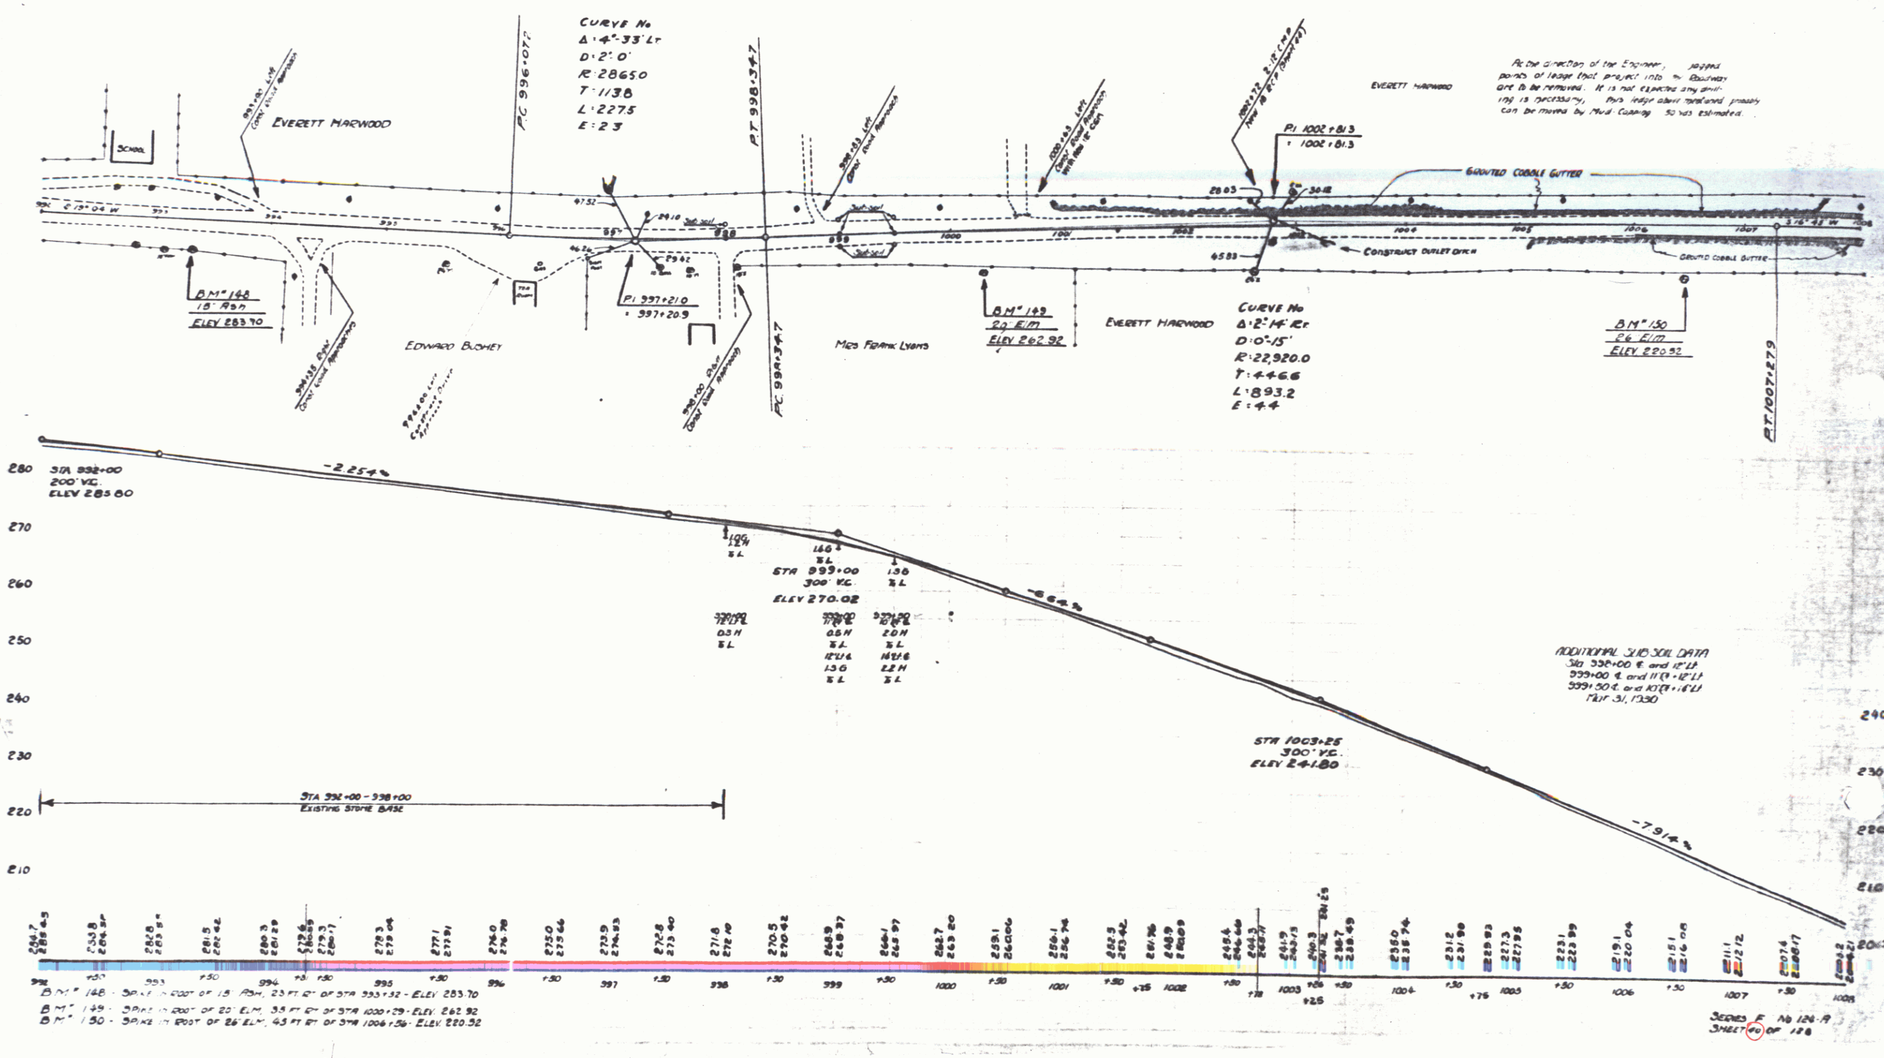

B.M. #148 - Spike in root of 18" Ash, 23 ft. Rt. of Sta 993+32 - Elev. 283.70
B.M. #149 - Spike in root of 20" Elm, 35 ft. Rt. of Sta 1000+29 - Elev. 262.92
B.M. #150 - Spike in root of 26" Elm, 43 ft. Rt. of Sta 1006+56 - Elev. 220.92