FED. R. DIST. NO.	STATE	FED. AID PROJ. NO.	FISCAL YEAR	SHEET NO.	TOTAL SHEETS
5		124-A	1937	5	27

(LANDSCAPING)

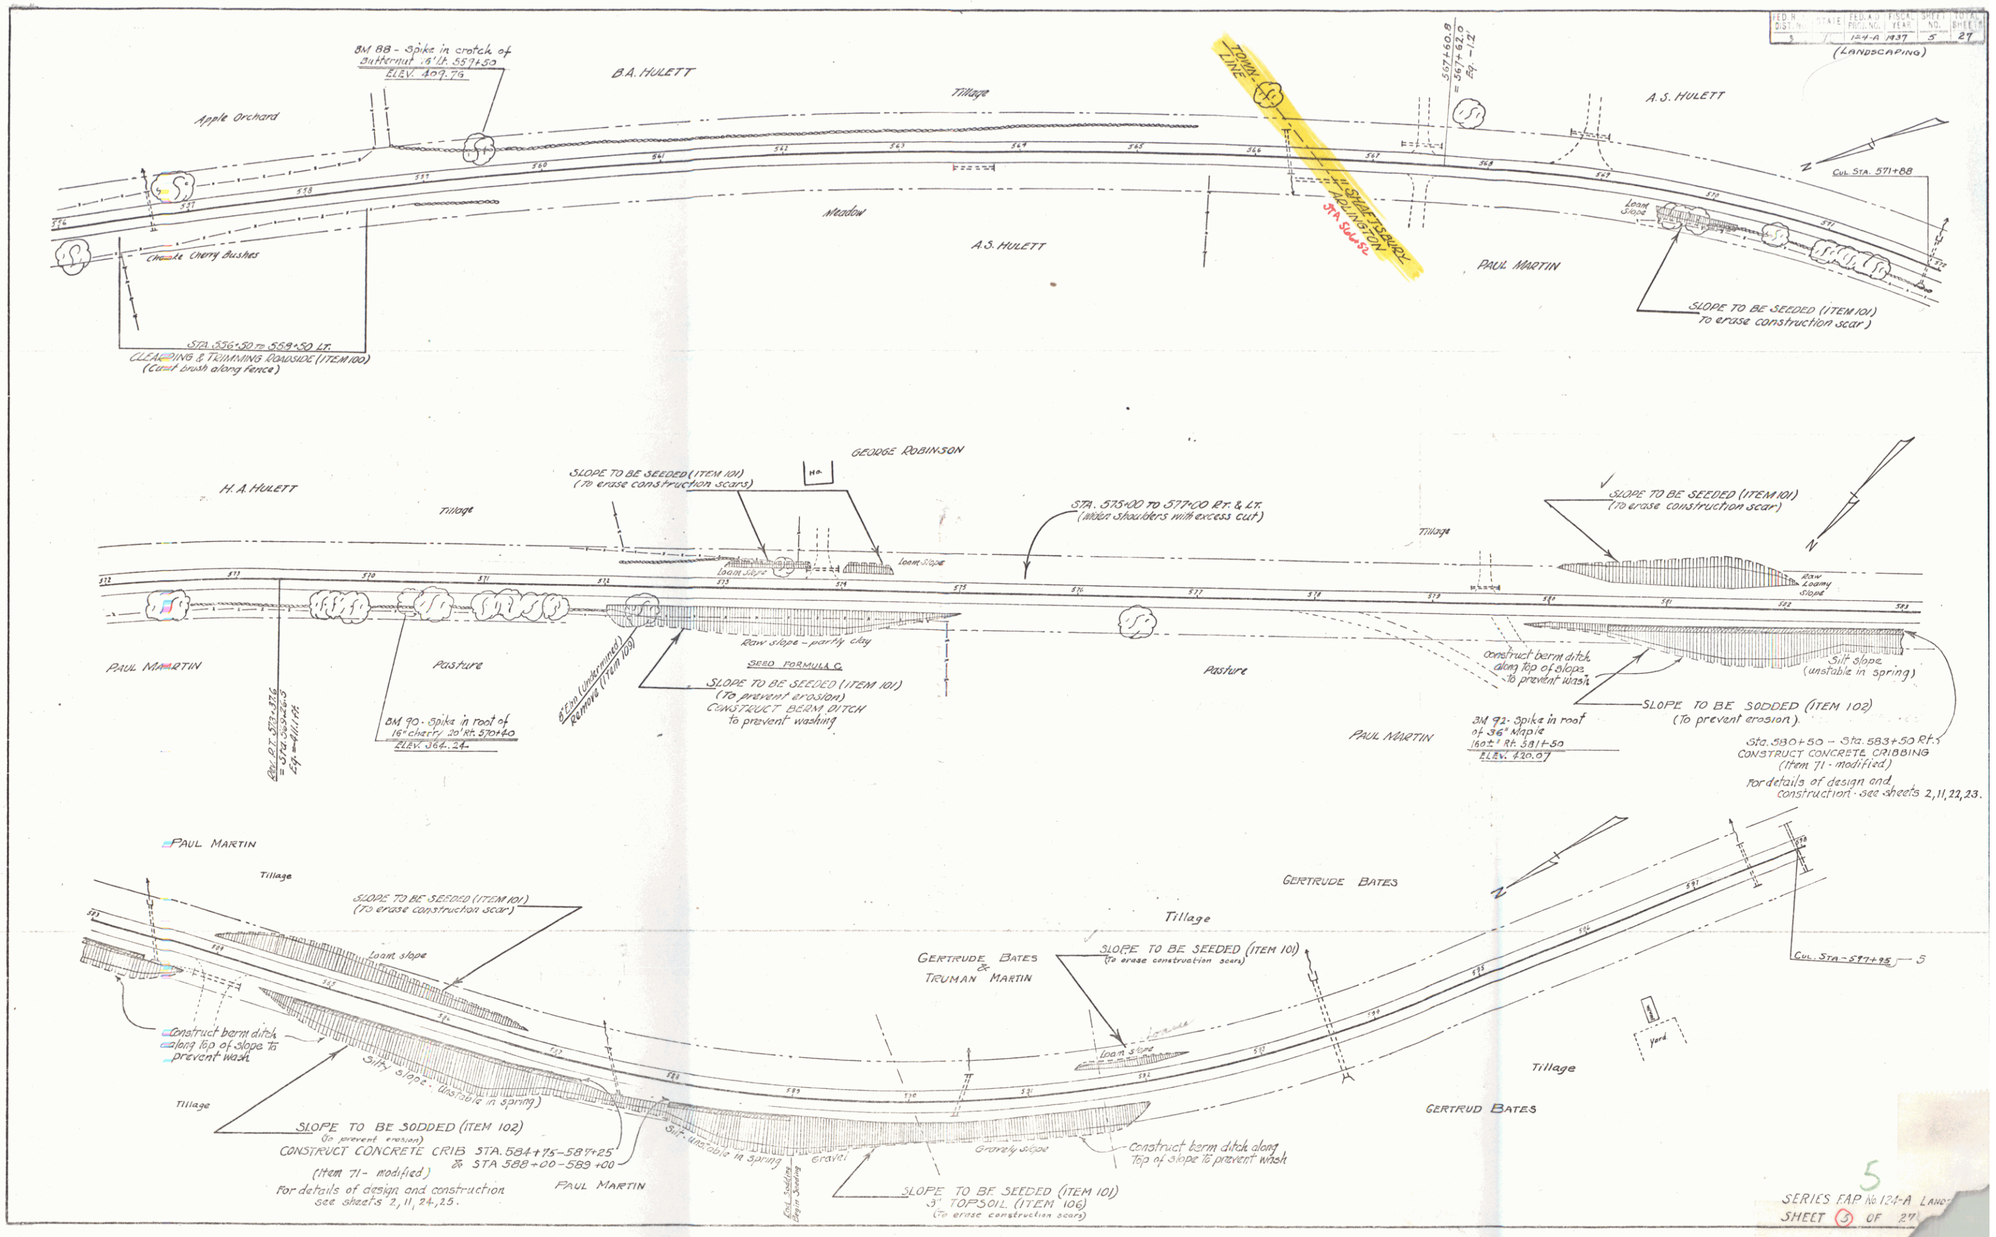

SERIES FAP No 124-A LANDSCAPING
SHEET 5 OF 27