CABLE GUARD RAIL REQUIRED

Stations	Left	Right
~~44+63 - 45+03~~	~~40~~	
~~44+30 - 45+00~~	~~70 ft.~~	-
~~44+57 - 45+00~~	-	~~43 ft.~~
44+73 - 44+97		24

NEW ARMC CORG. PIPE CULVERTS REQUIRED

Station	Diam.	Leng.	Corg. M.	Steel
44+81	18"	~~44 ft.~~ 44	~~4.6 cy~~ 3.5	~~35 ft.~~ 35 ft.

NEW DRIVEWAY PIPE CULVERTS REQUIRED

SERRUG. GALV. METAL PIPE

Station	Left or Right	Diam.	Leng.	Cement Rubb. Masonry
39+50	Rt.	18"	~~24 ft.~~ 40	~~1.6 cy~~ 2.5

104A 1929 6 98

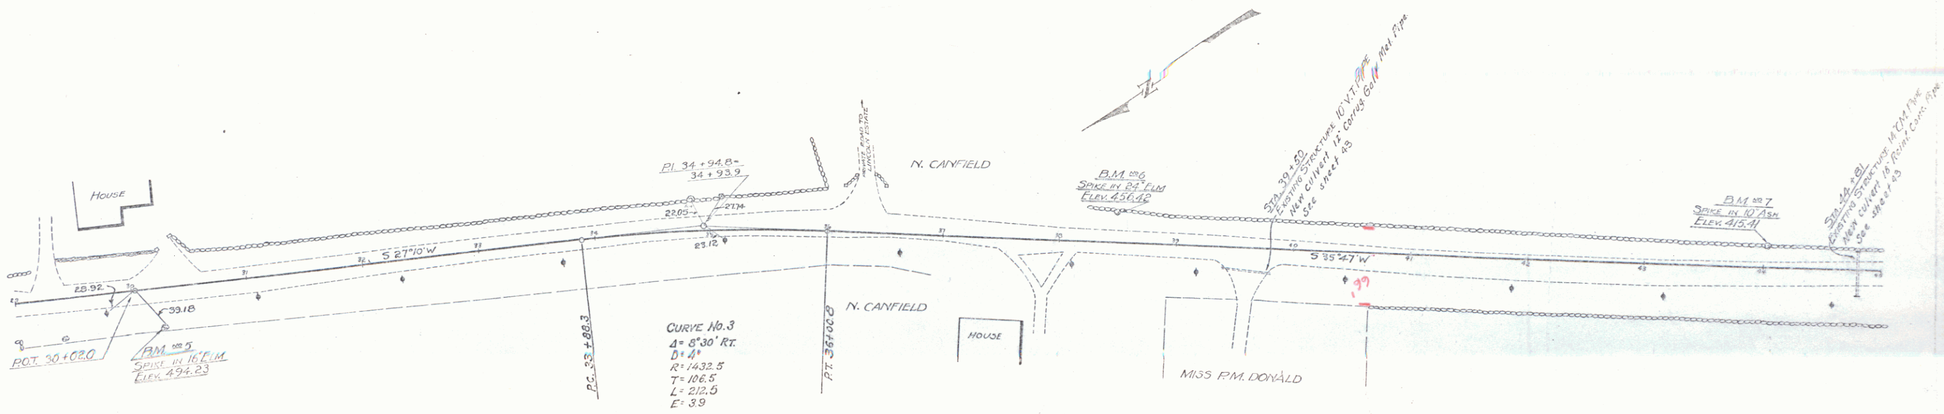

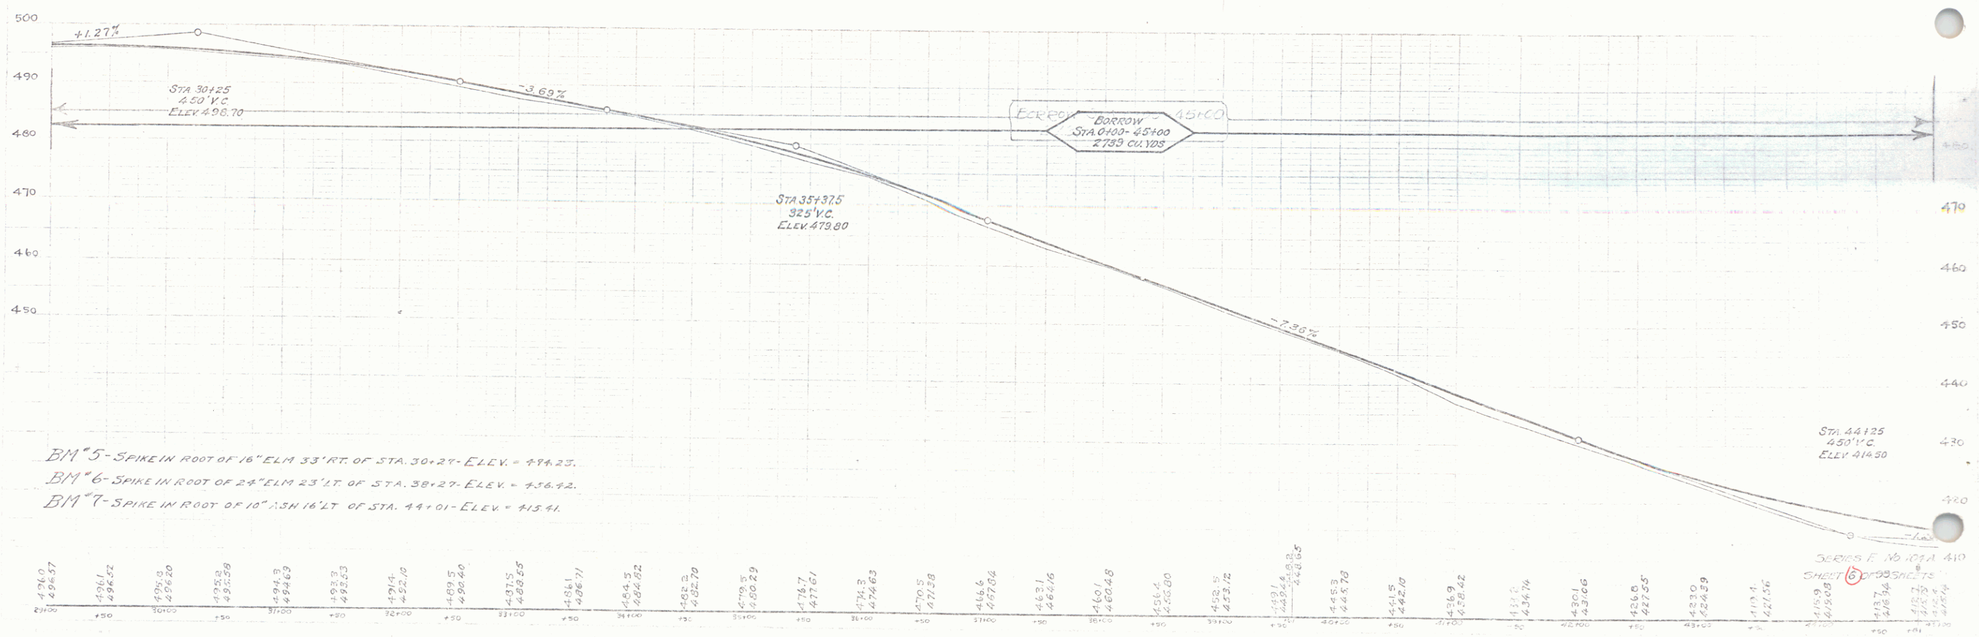

BM "5" - SPIKE IN ROOT OF 16" ELM 33' RT. OF STA. 30+27 - ELEV. = 494.23.

BM "6" - SPIKE IN ROOT OF 24" ELM 23' LT. OF STA. 38+27 - ELEV. = 456.42.

BM "7" - SPIKE IN ROOT OF 10" ASH 16' LT. OF STA. 44+01 - ELEV. = 415.41.

Station	Elev.

SERIES F. No. 104A 410

SHEET 6 OF 99 SHEETS

4