WOOD GUARD RAIL REQUIRED

Stations	Left	Right
299+28-299+52	24 ft.	24 ft.

NEW REINF. CONC. PIPE CULVERTS REQUIRED

Station	Diam.	Leng.	Conc. R.	Steel
299+40	24"	32 ft.	~~Lcy.~~ 3.9	~~64#~~ 68#

104A 1929 24 99

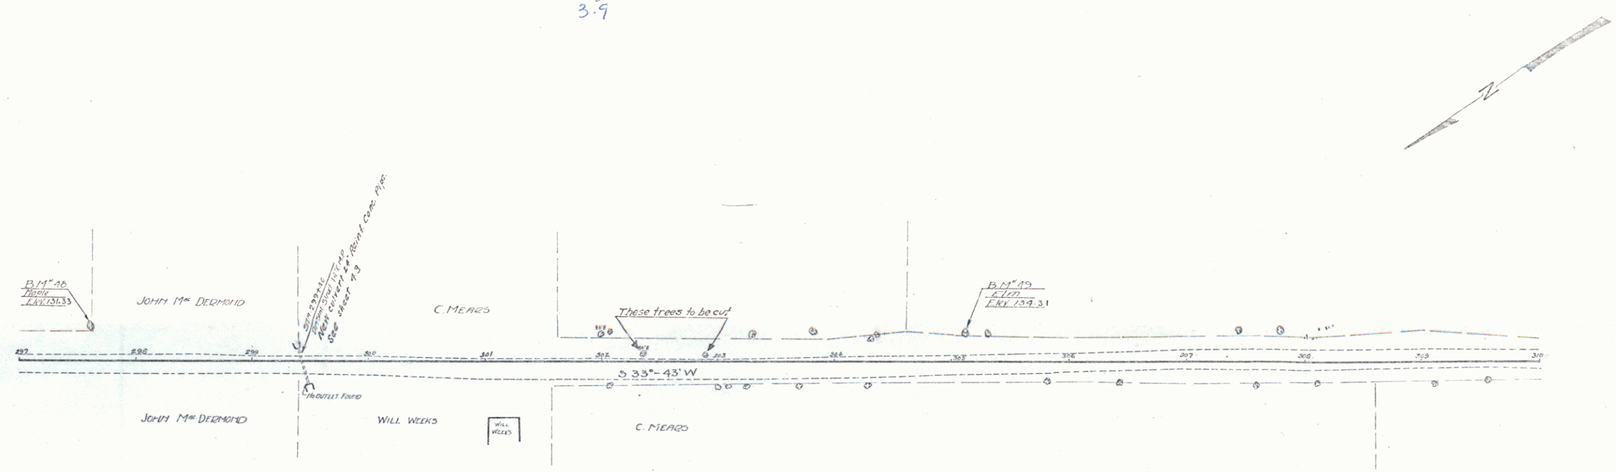

B.M.# 48 SPIKE IN ROOT OF MAPLE 24 FT. LT. OF STA. 297+63 - ELEV. 131.33

B.M.# 49 SPIKE IN ROOT OF ELM 20 FT. LT. OF STA. 305+18 - ELEV. 134.31

SERIES E NO. 104-A
SHEET 24 OF 98

23