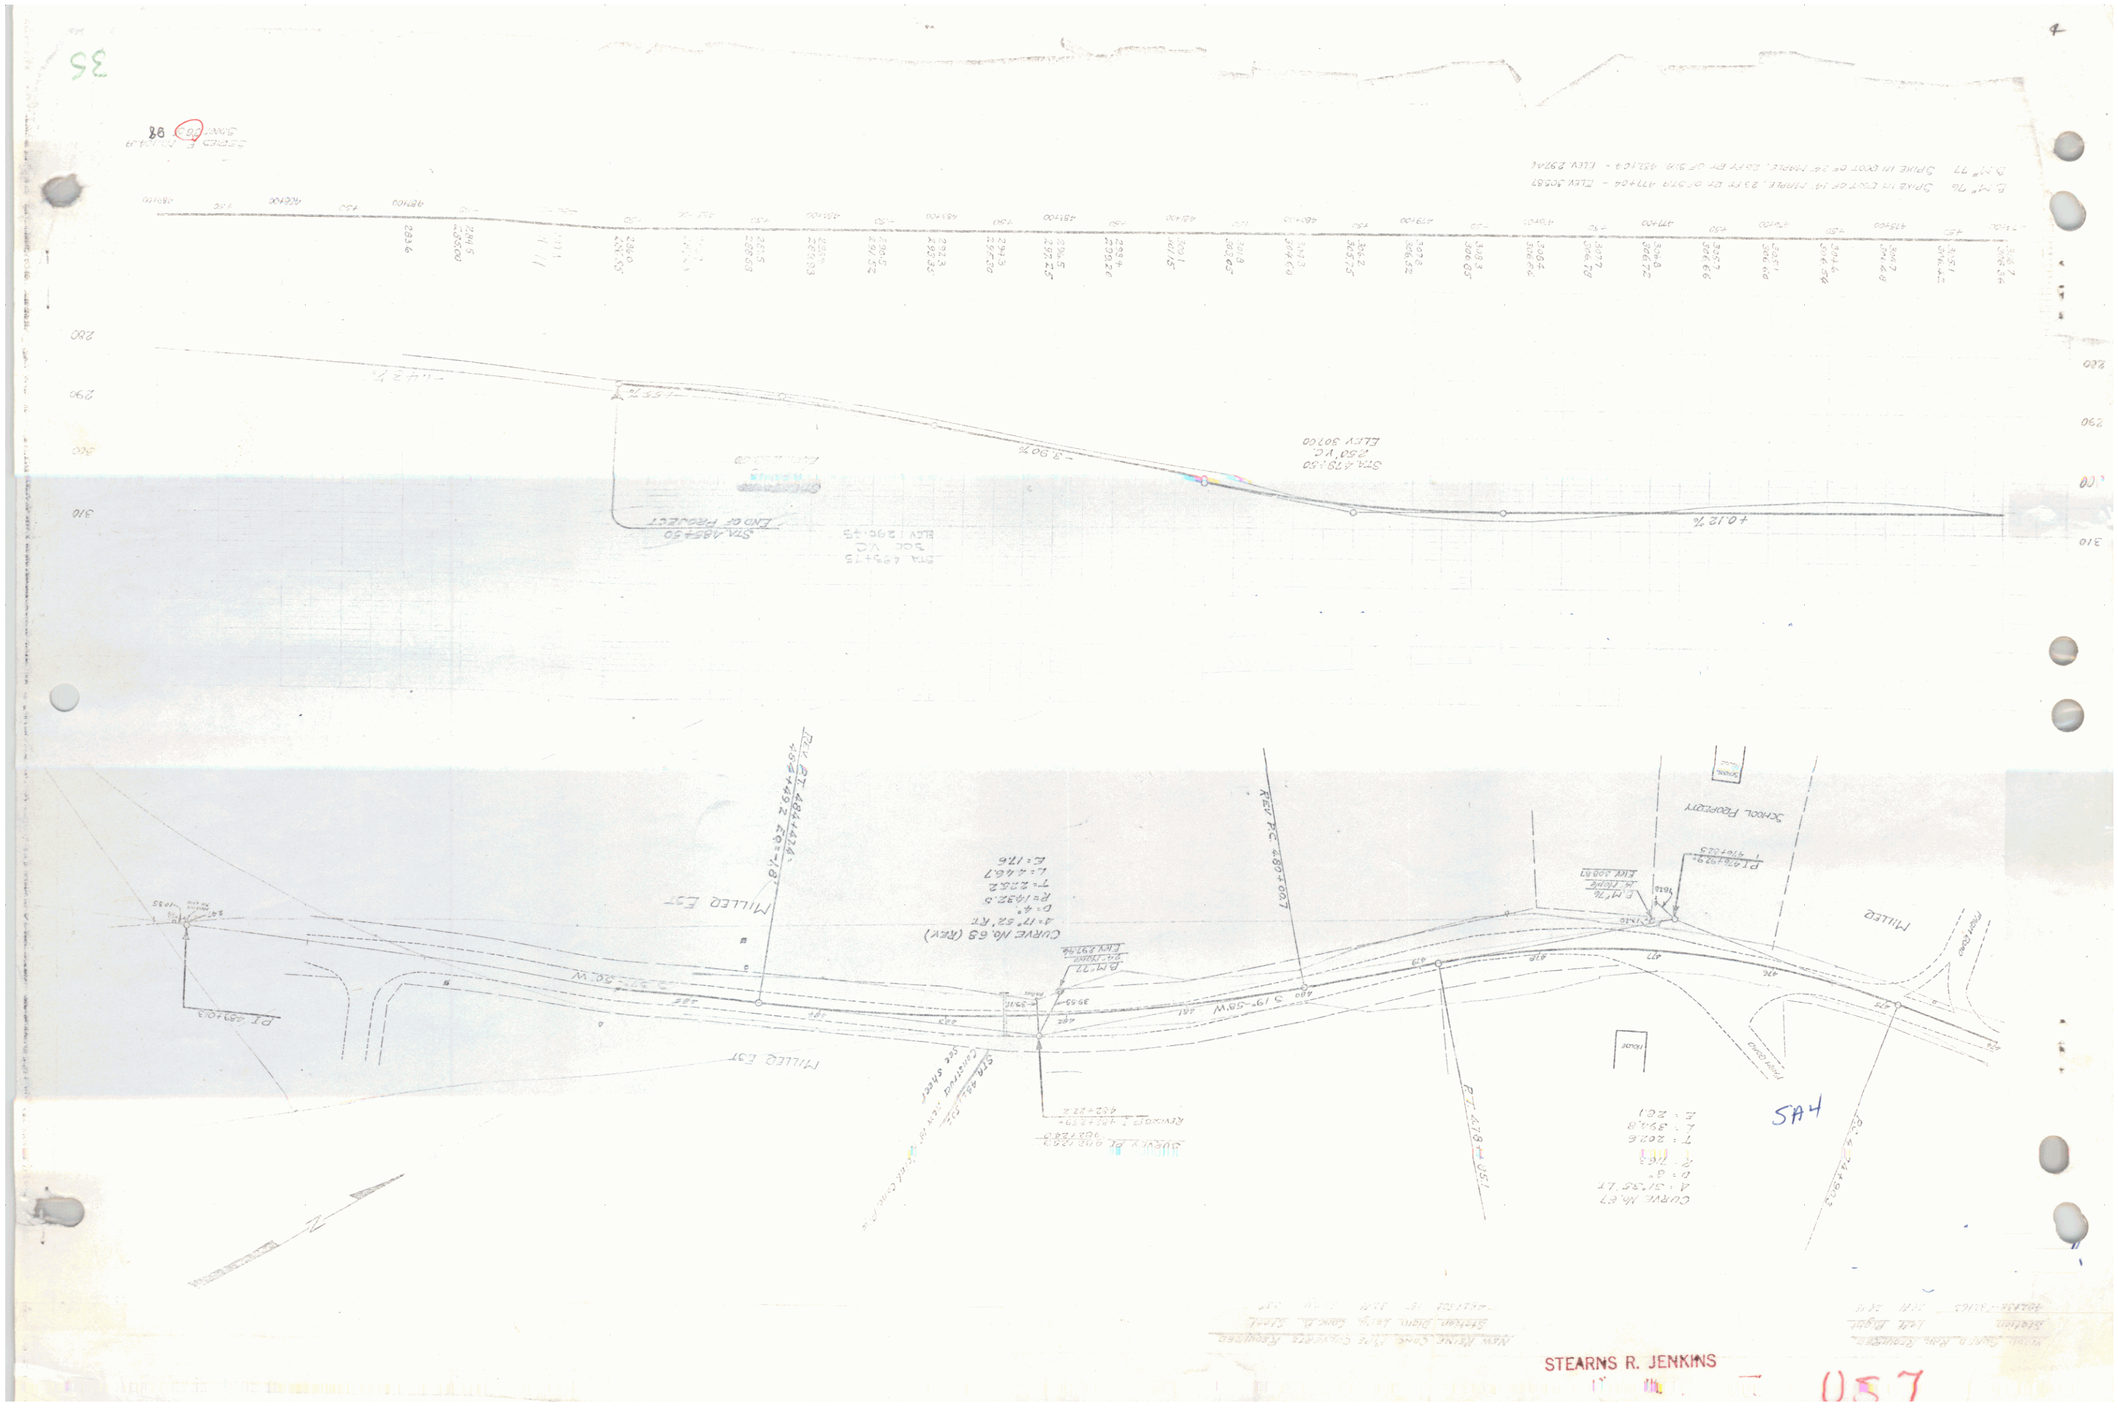
STEARNS R. JENKINS
SA4
Miller
Miller Est
School Property
Curve No. 67
Curve No. 68 (Rev)
