

THREE CABLE GUARD RAIL WITH STEEL POSTS ITEM 543		
STATION	STATION	POS.
1313+00	1315+25	LT
1321+34.47	1323+09.97	LT
1322+65.27	1323+34.32	RT
1325+74.5	1328+00	LT
1326+02.7	1328+00	RT
1327+17.0	1329+63.6	LT
1327+28.6	1329+62.36	RT

PROPERTY LINE FENCE WITH STEEL POSTS ITEM 553 (MIN.)		
STATION	STATION	POS.
1320+00	1323+00	LT
1323+35	1325+39.9	RT
1325+47.5	1328+00	LT

Median of Bridges  
1331+30 RT of RT Lane to  
1323+00 LT of LT Lane  
1328+00 RT of LT Lane to  
1332+20 RT of RT Lane


DRILLING & BLASTING OF SOLID ROCK SUB GRADE ITEM 114 (MOD)		
STATION	STATION	POS.
1313+50	1314+25	LT

DRILLING & BLASTING OF SOLID ROCK SUB GRADE ITEM 114 (MOD)		
STATION	STATION	POS.
1314+00	1314+65	LT
1316+00	1321+00	RT
1317+20	1324+04	RT

CONSTRUCT DRIVE		
STATION	STATION	POS.
1328+40	1328+40	LT

Bituminous Concrete Curb Item 555		
STATION	STATION	POS.
1328+04	1329+61	LT
1326+70	1329+35	RT
1321+44	1323+00	LT
1322+42	1323+33	RT
1325+74	1327+26	LT
1326+06	1328+00	RT

Bituminous Gutter Item 554		
STATION	STATION	POS.
1327+50	1327+50	LT
1323+23	1323+23	RT

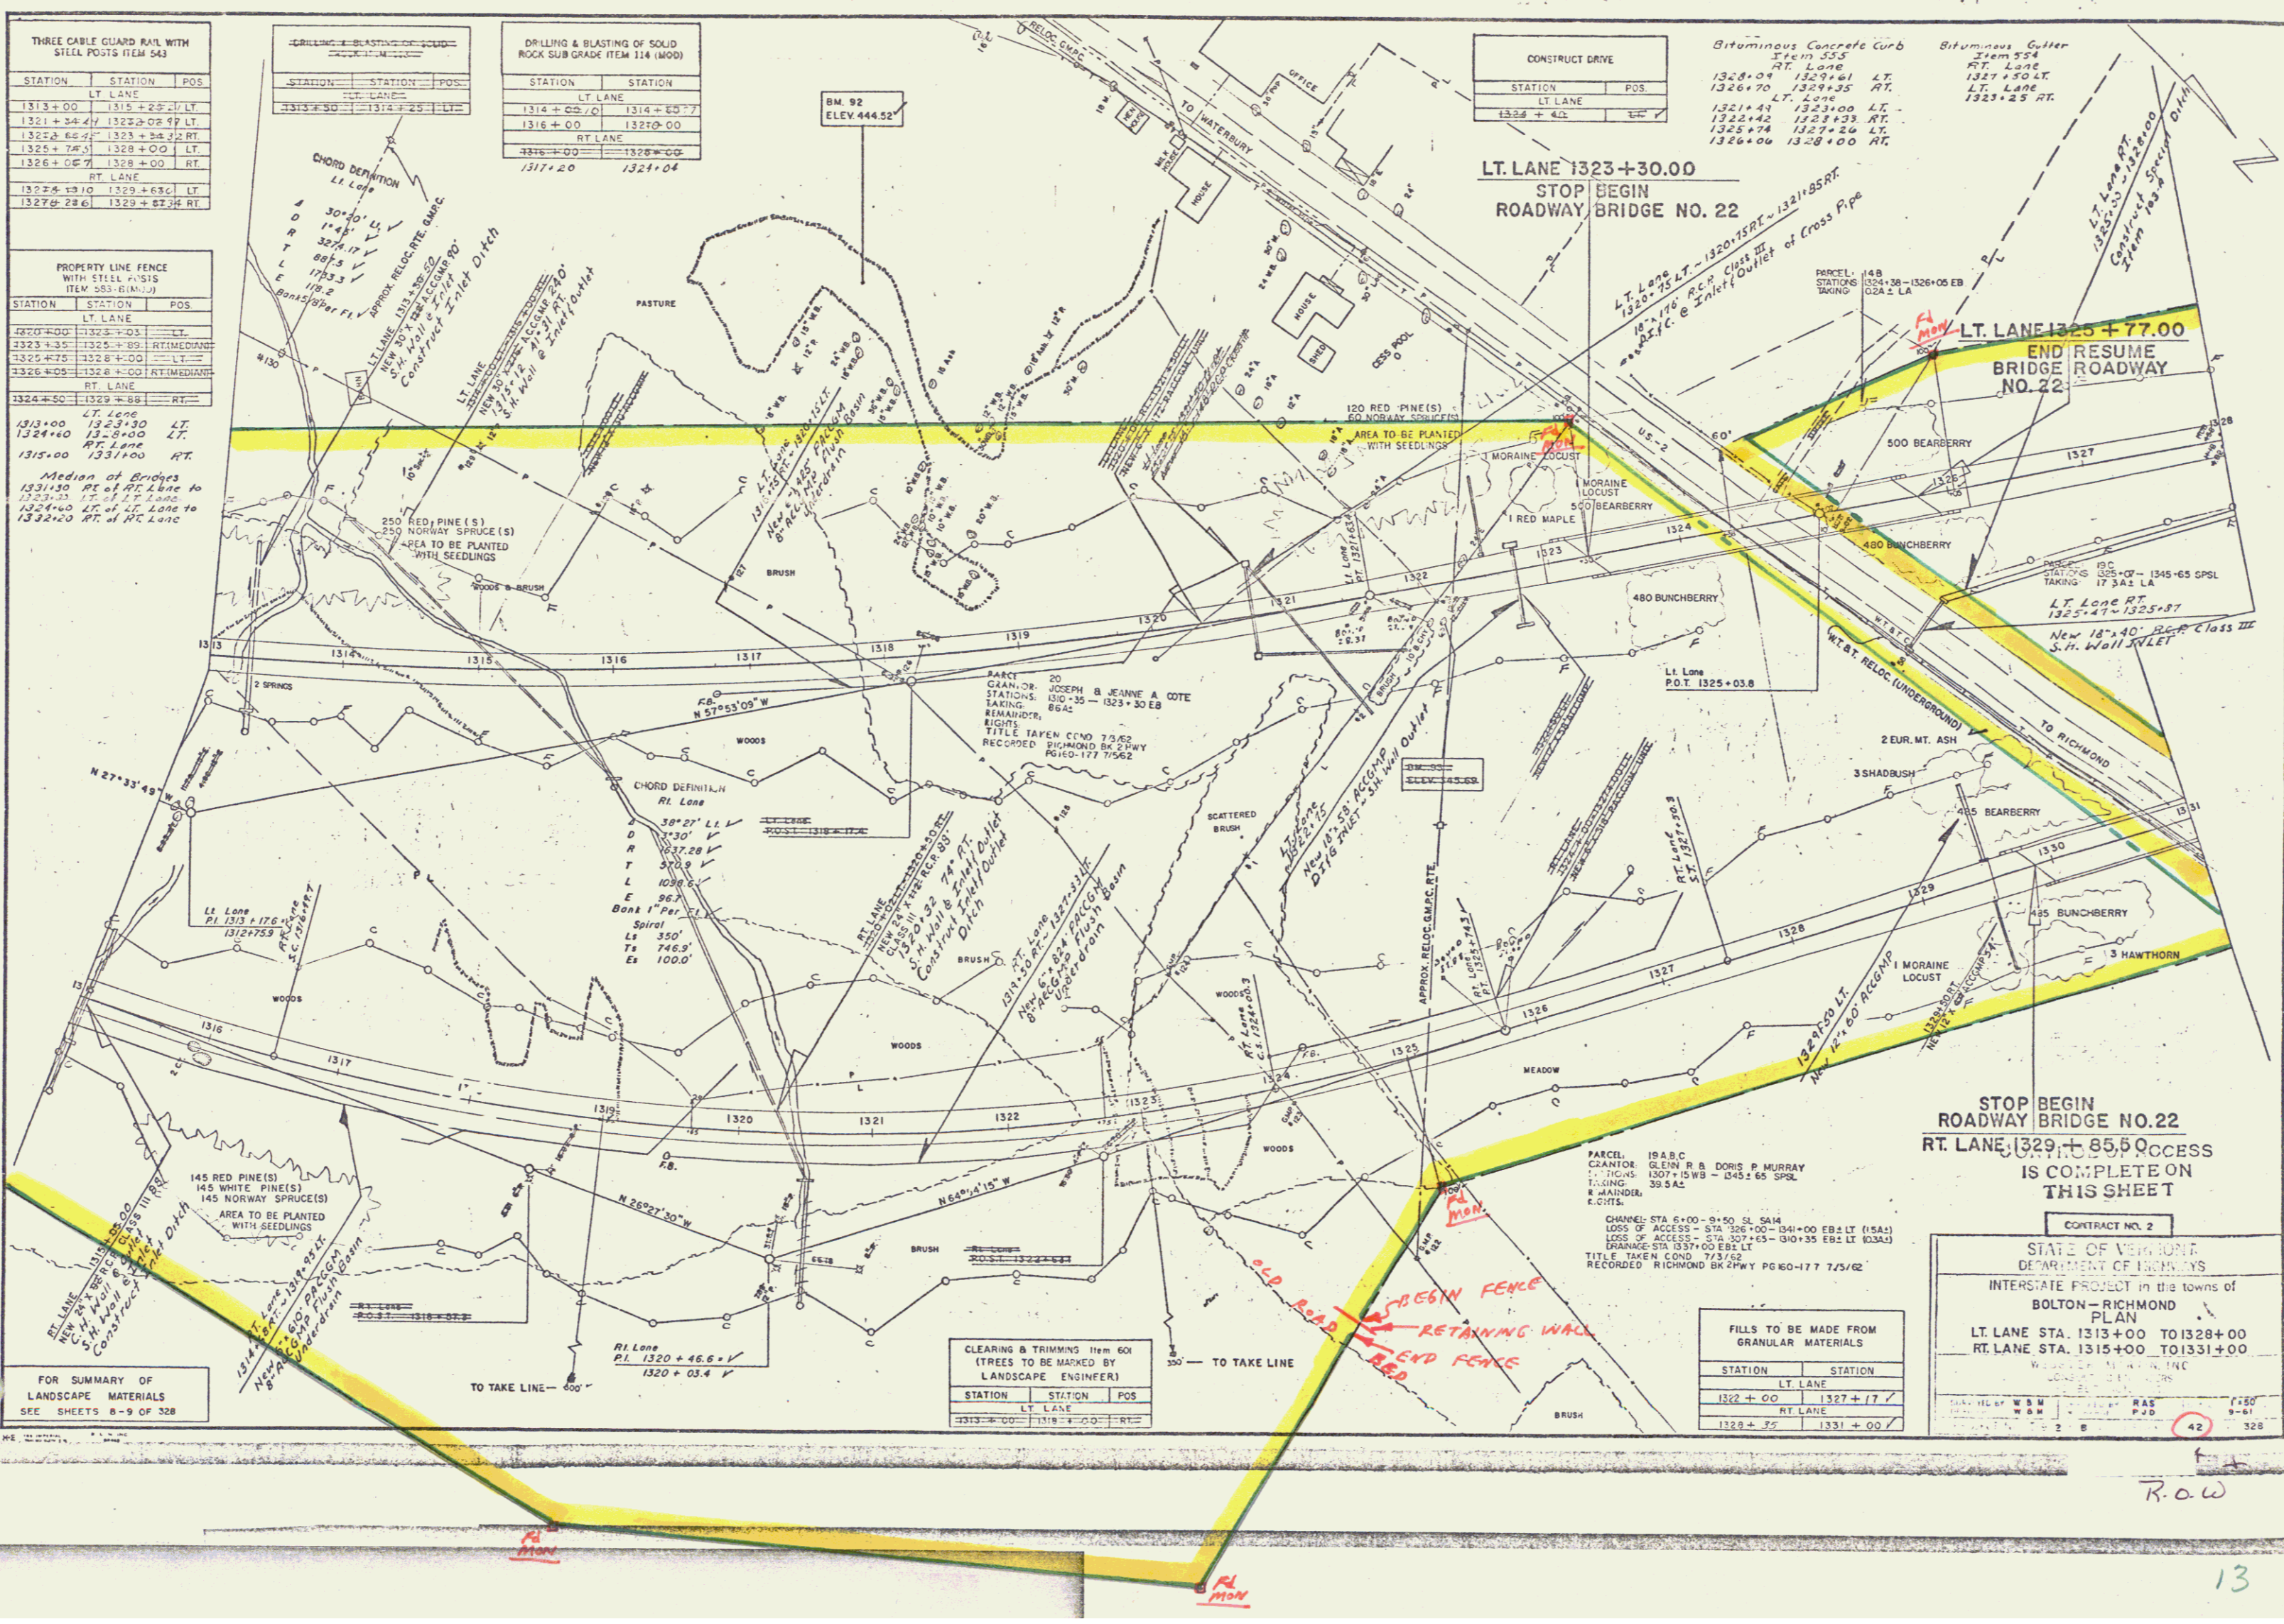

LT. LANE 1323+30.00  
STOP BEGIN  
ROADWAY BRIDGE NO. 22

LT. LANE 1325+77.00  
END RESUME  
BRIDGE ROADWAY  
NO. 22

STOP BEGIN  
ROADWAY BRIDGE NO. 22  
RT. LANE 1329+85.50  
ACCESS  
IS COMPLETE ON  
THIS SHEET

CLEARING & TRIMMING Item 601 (TREES TO BE MARKED BY LANDSCAPE ENGINEER)		
STATION	STATION	POS.
1313+00	1318+00	RT

FILLS TO BE MADE FROM GRANULAR MATERIALS		
STATION	STATION	POS.
1322+00	1327+17	LT
1328+35	1331+00	RT

CONTRACT NO. 2

STATE OF VERMONT  
DEPARTMENT OF HIGHWAYS

INTERSTATE PROJECT in the towns of  
BOLTON - RICHMOND  
PLAN

LT. LANE STA. 1313+00 TO 1328+00  
RT. LANE STA. 1315+00 TO 1331+00


42 328

R.O.W