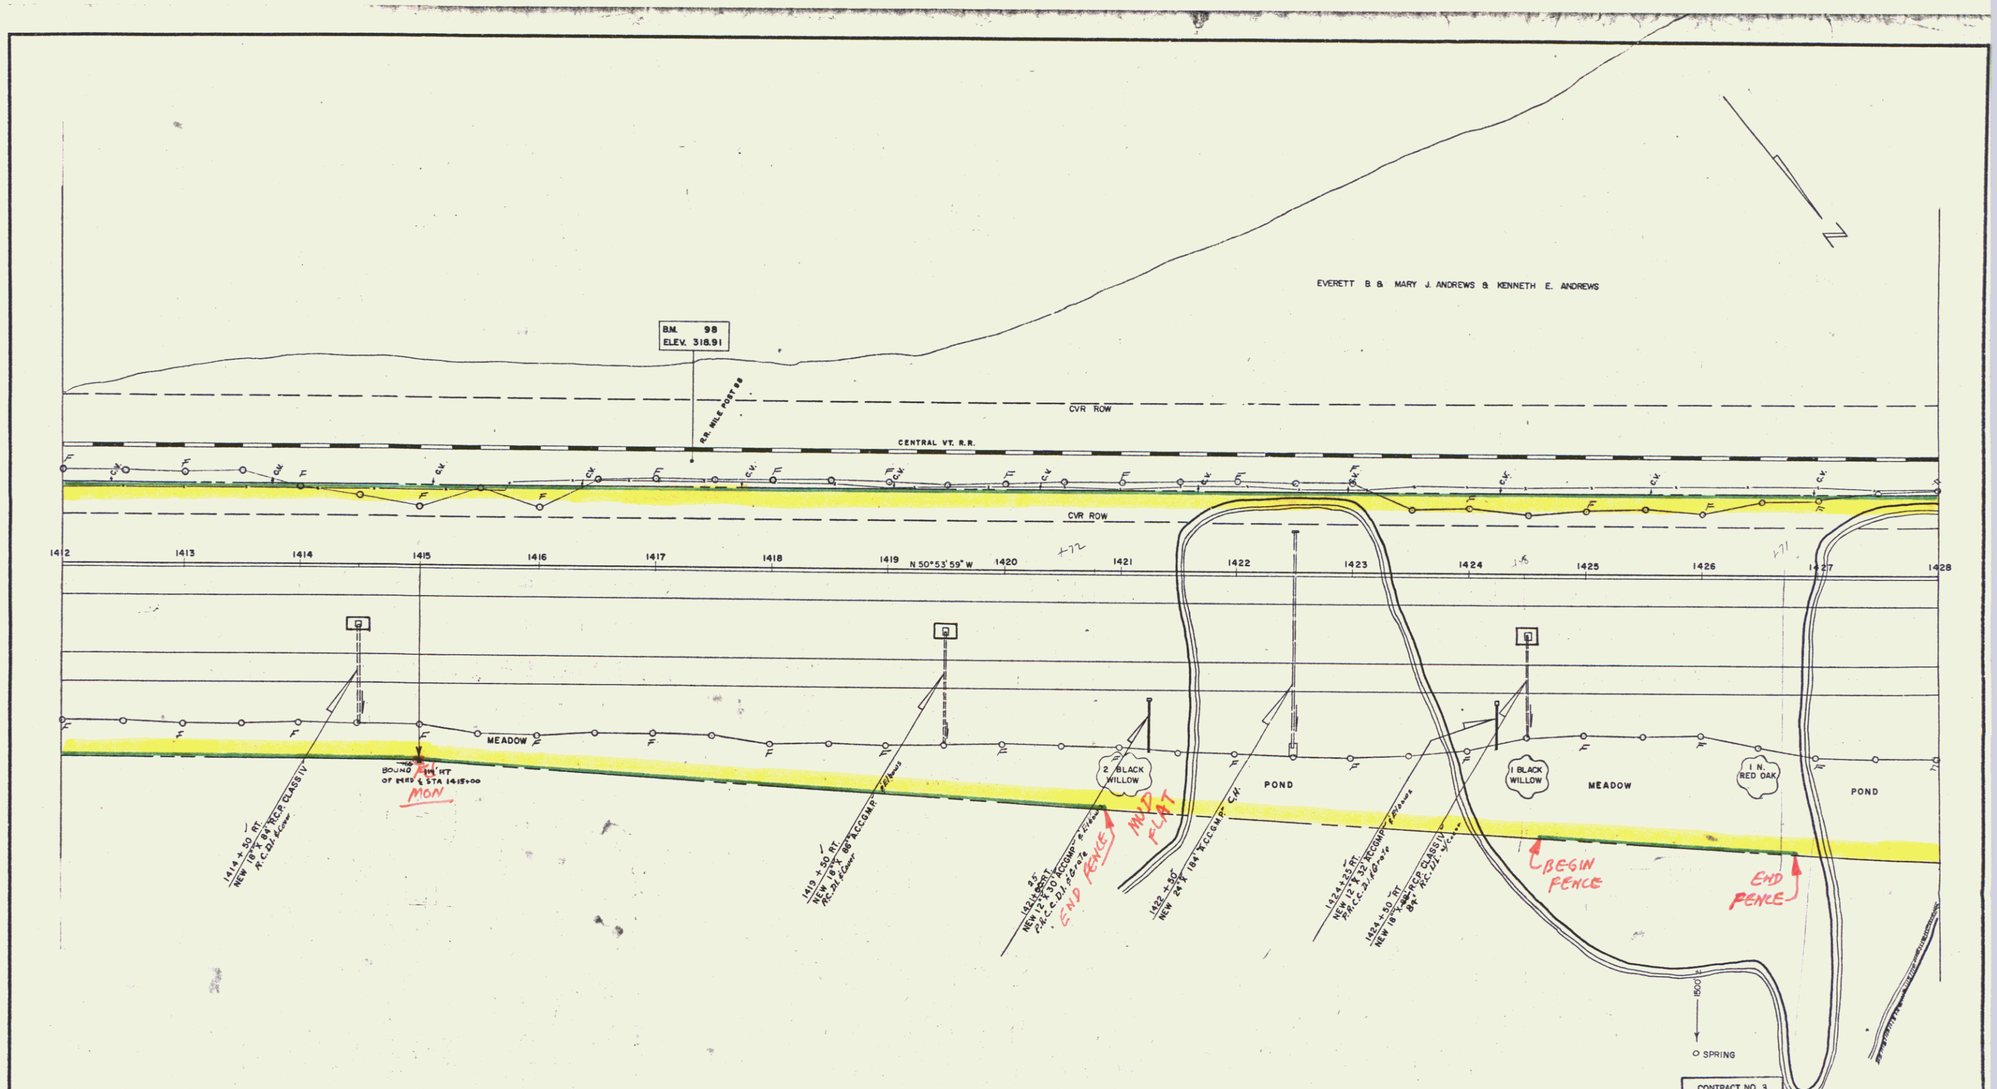

THREE CABLE GUARD RAIL WITH STEEL POSTS ITEM 543		
STATION	STATION	POS.
LT. LANE		
1412+00	1428+00	LT.
RT. LANE		
1412+00	1428+00	RT.

STA.	STA.	POS.
RT LANE		
1412+00	1420+72	RT
1424+43	1426+71	RT
LT LANE		
1412+00	1428+00	LT

PROPERTY LINE FENCE WITH STEEL POSTS ITEM 563-B(MOD)		
STATION	STATION	POS.
~~LT. LANE~~		
~~1412+00~~	~~1428+00~~	~~RT.~~

~~ROCK FILL MUCK EXCAVATION ITEM 116 (MOD)~~	
STATION	STATION
1421+00	~~1422+50~~

FOR SUMMARY OF LANDSCAPE MATERIALS SEE SHEET 6 OF 118

CONTROL OF ACCESS IS COMPLETE ON THIS SHEET

CONTRACT NO. 3

STATE OF VERMONT
DEPARTMENT OF HIGHWAYS
INTERSTATE PROJECT in the towns of
BOLTON—RICHMOND
PLAN
STA. 1412+00 TO 1428+00

WEBSTER MARTIN, INC.
CONSULTING ENGINEERS
SO. BURLINGTON, VT.

SURVEYED BY W.B.M.	CHECKED BY R.A.S.	1" = 50'	
DRAWN BY W.B.M.	IN CHARGE P.J.D.	DATE 10-61	
PROJECT NO. 189-2 (8)	SHEET 17	OF 118	

Const. Rec.

20