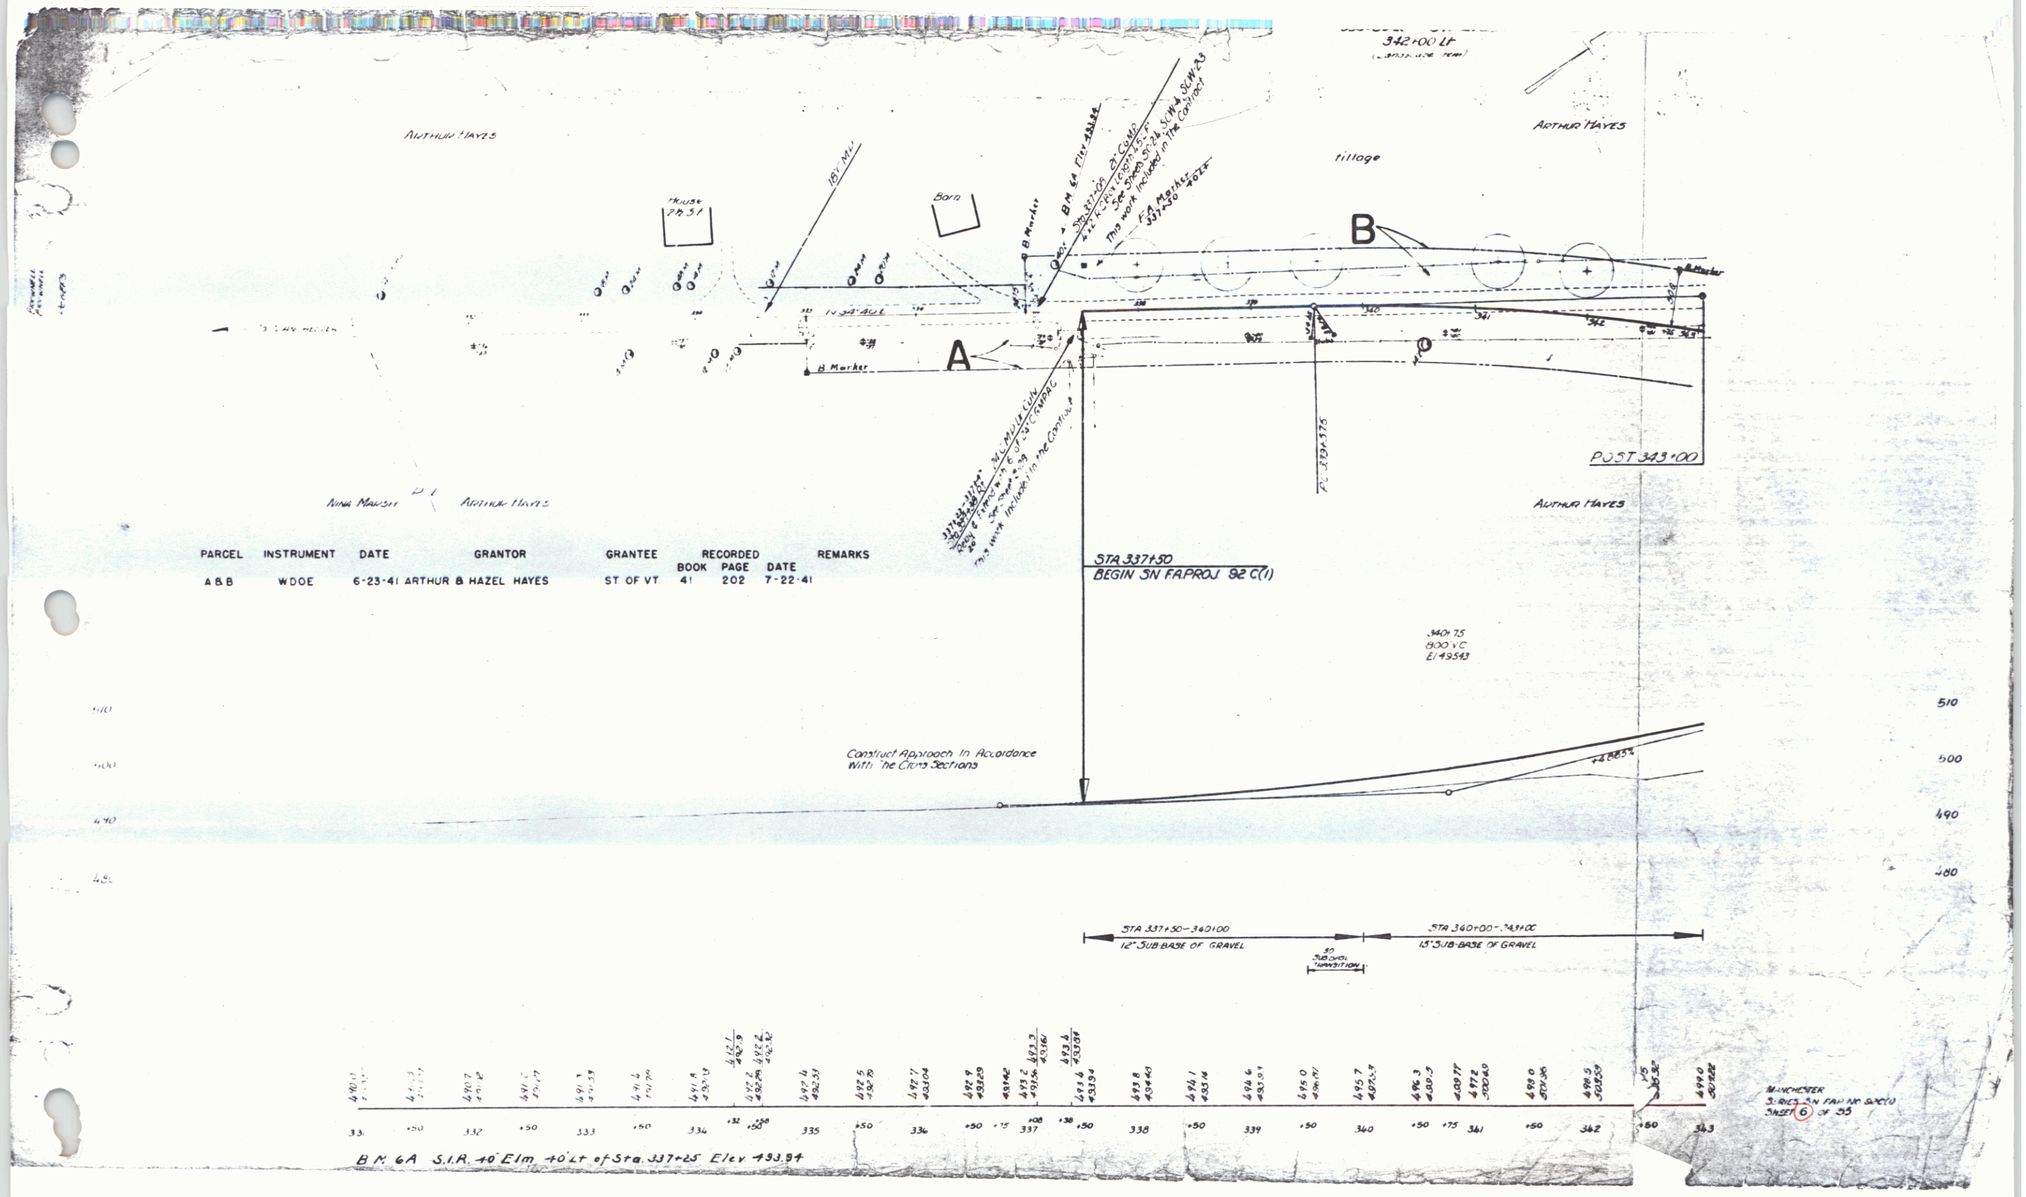

PARCEL	INSTRUMENT	DATE	GRANTOR	GRANTEE	RECORDED BOOK	PAGE	DATE	REMARKS
A & B	WDOE	6-23-41	ARTHUR & HAZEL HAYES	ST OF VT	41	202	7-22-41	

2