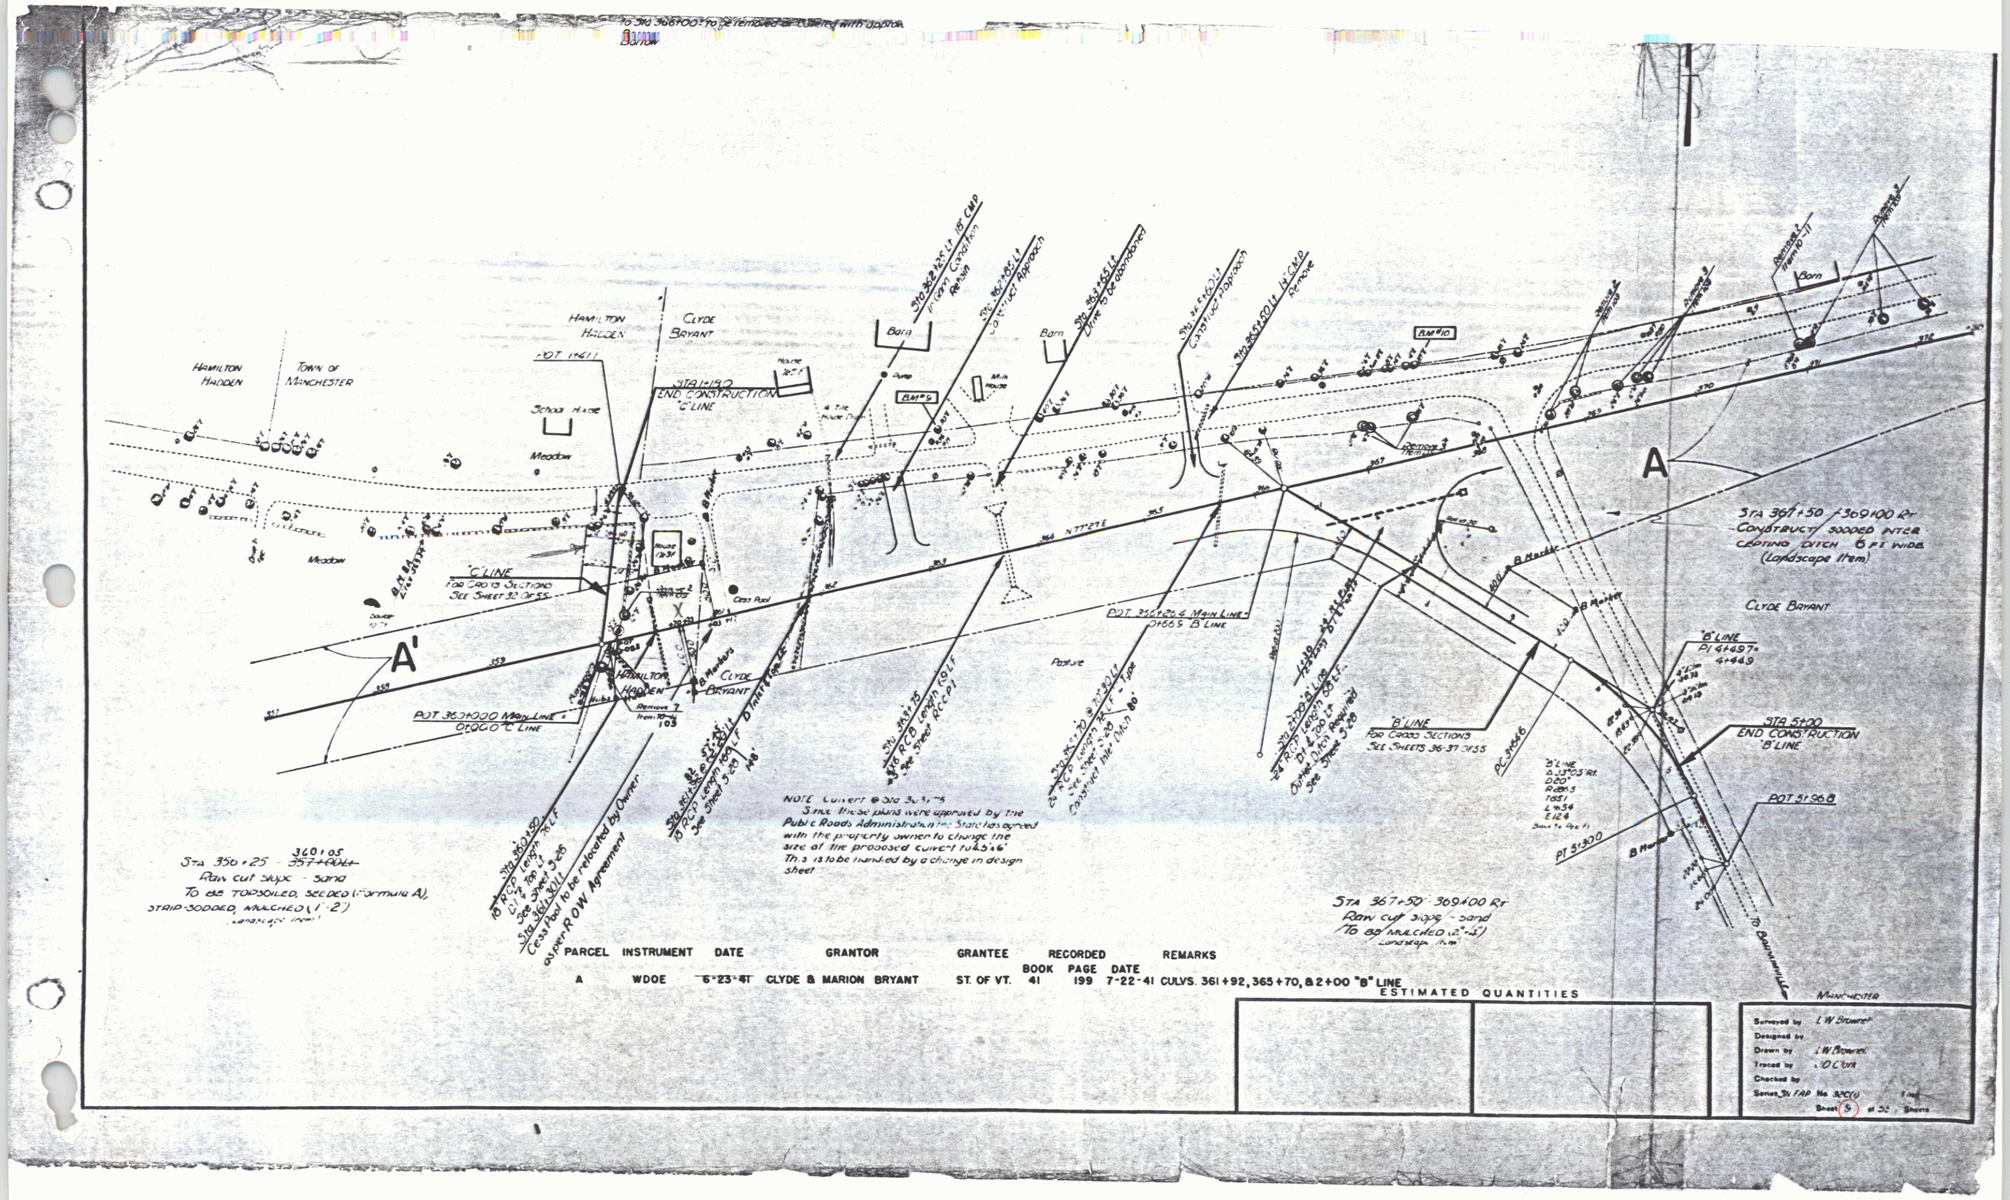
Hamilton Hadden
Town of Manchester
Hamilton Hadden
Clyde Bryant
School House
Meadow
Meadow
STA 1+90 END CONSTRUCTION "C" LINE
"C" LINE
For Cross Sections See Sheet 32 of 55
A'
A
POT 360+000 Main Line = 0+000 "C" Line
Hamilton Hadden
Clyde Bryant
Barn
Barn
Barn
Pasture
POT 350+26.4 Main Line = 0+65.5 "B" Line
B Marker
"B" LINE For Cross Sections See Sheets 36-37 of 55
"B" LINE PI 4+49.7 = 4+44.9
STA 5+00 END CONSTRUCTION "B" LINE
POT 5+96.8
PI 5+30.0
Clyde Bryant
Manchester
Sta 350+25 - 360+05
Raw cut slope - sand
To be topsoiled, seeded (Formula A), strip-sodded, mulched (1"-2")
Landscape Item
Sta 367+50 - 369+00 Rt
Raw cut slope - sand
(To be mulched (2"-4")
Landscape Item
Sta 367+50 - 369+00 Rt
Construct sodded inter cepting ditch 6 ft wide
(Landscape Item)
NOTE Culvert @ Sta 3[illegible]
Since these plans were approved by the Public Roads Administration, the State has agreed with the property owner to change the size of the proposed culvert to 4'x6'. This is to be handled by a change in design sheet
Cess Road to be relocated by Owner as per R.O.W. Agreement
Remove 7 Item 103
Remove 7 Item 110
Remove 7 Item 111
Remove 7 Item