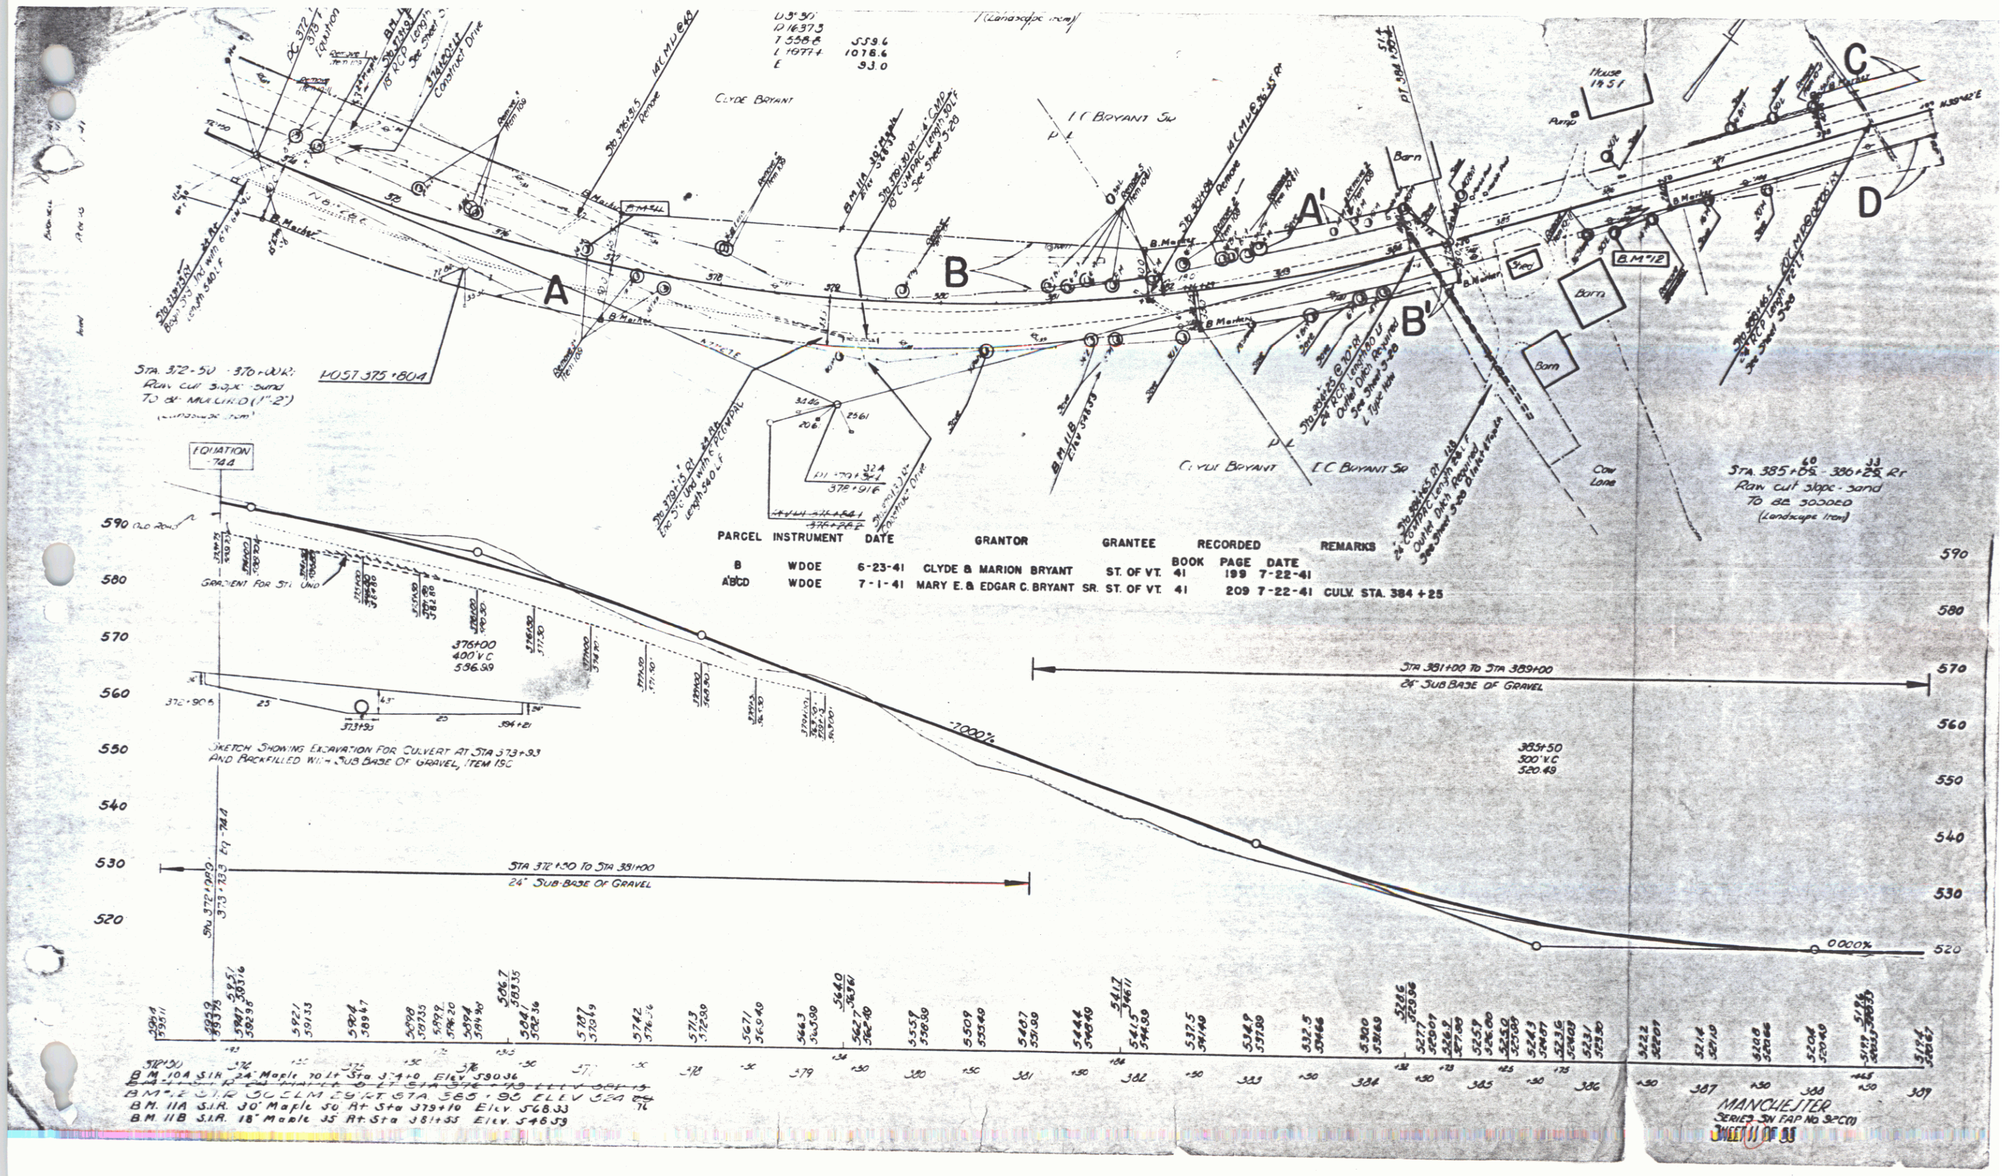

PARCEL	INSTRUMENT	DATE	GRANTOR	GRANTEE	RECORDED BOOK	PAGE	DATE	REMARKS
B	WDOE	6-23-41	CLYDE & MARION BRYANT	ST. OF VT.	41	199	7-22-41	
A'B'CD	WDOE	7-1-41	MARY E. & EDGAR C. BRYANT SR.	ST. OF VT.	41	209	7-22-41	CULV. STA. 384+25

5