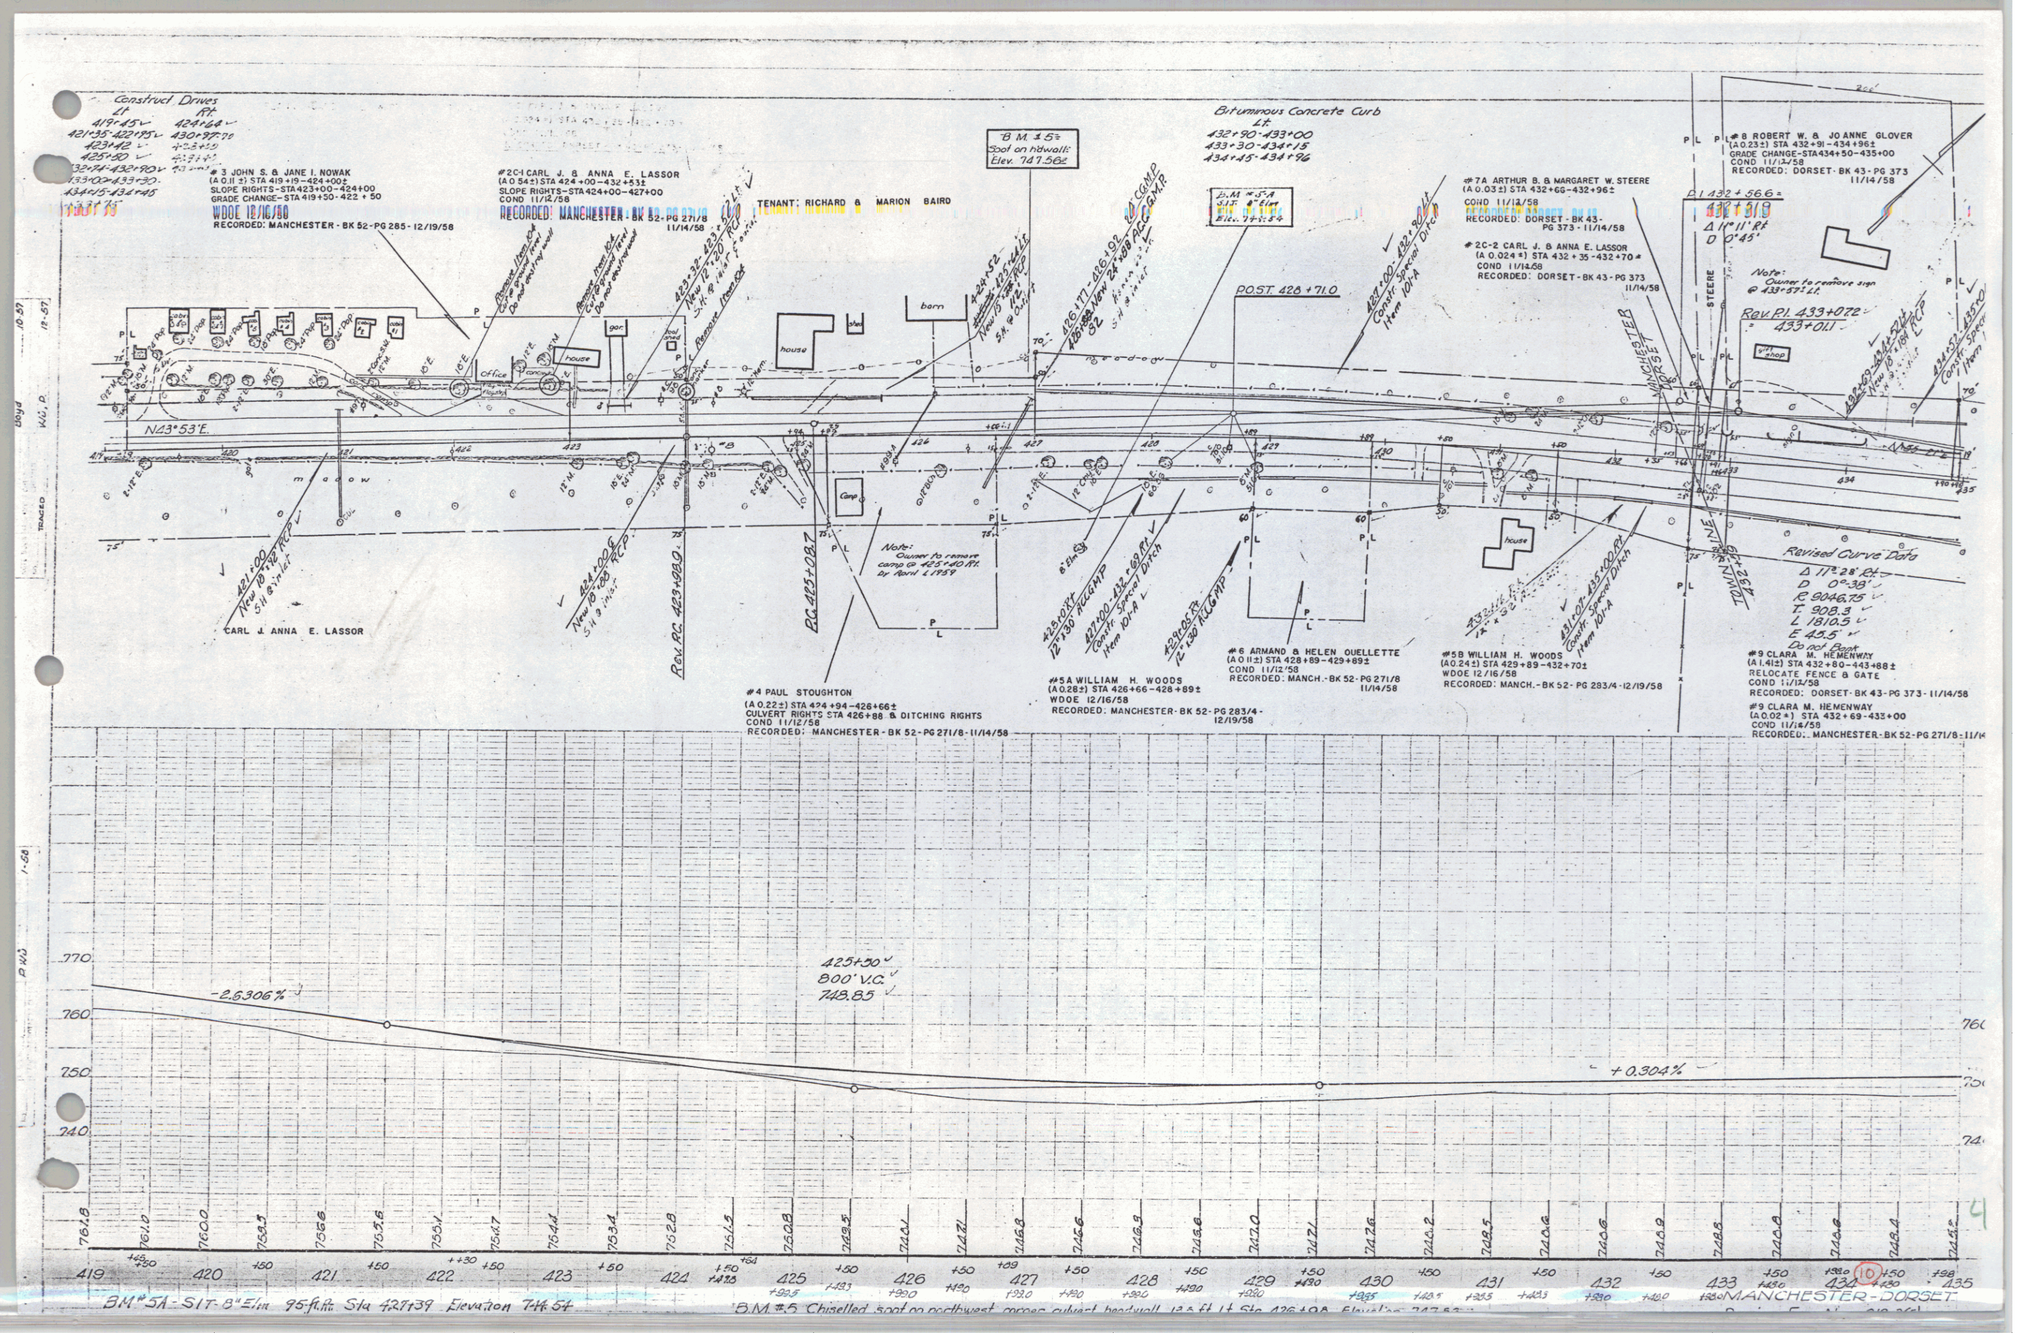

Construct Drives
Bituminous Concrete Curb
Lt.
432+90-433+00
433+30-434+15
434+45-434+96
B.M. #5A
S.I.T. 8" Elm
Elev. 744.54
#3 JOHN S. & JANE I. NOWAK
(A 0.11 ±) STA 419+19-424+00±
SLOPE RIGHTS-STA 423+00-424+00
GRADE CHANGE-STA 419+50-422+50
WDOE 12/16/58
RECORDED: MANCHESTER-BK 52-PG 285-12/19/58
#2C-1 CARL J. & ANNA E. LASSOR
(A 0.54±) STA 424+00-432+53±
SLOPE RIGHTS-STA 424+00-427+00
COND 11/12/58
RECORDED: MANCHESTER-BK 52-PG 271/8
11/14/58
TENANT: RICHARD & MARION BAIRD
#7A ARTHUR B. & MARGARET W. STEERE
(A 0.03±) STA 432+66-432+96±
COND 11/12/58
RECORDED: DORSET-BK 43-PG 373-11/14/58
#2C-2 CARL J. & ANNA E. LASSOR
(A 0.024±) STA 432+35-432+70±
COND 11/12/58
RECORDED: DORSET-BK 43-PG 373
11/14/58
#8 ROBERT W. & JOANNE GLOVER
(A 0.23±) STA 432+91-434+96±
GRADE CHANGE-STA 434+50-435+00
COND 11/12/58
RECORDED: DORSET-BK 43-PG 373
11/14/58
P.I. 432+56.6
Δ 11°11' Rt
D 0°45'
Note:
Owner to remove sign
@ 433+57± Lt.
Rev. P.I. 433+07.2
433+01.1
P.O.S.T. 428+71.0
N43°53'E.
house
office
barn
Camp
Note:
Owner to remove
camp @ 425+40 Rt.
by April 1959
CARL J. ANNA E. LASSOR
Rev. P.C. 423+98.9
P.C. 425+08.7
#4 PAUL STOUGHTON
(A 0.22±) STA 424+94-426+66±
CULVERT RIGHTS STA 426+88 & DITCHING RIGHTS
COND 11/12/58
RECORDED: MANCHESTER-BK 52-PG 271/8-11/14/58
#5A WILLIAM H. WOODS
(A 0.28±) STA 426+66-428+89±
WDOE 12/16/58
RECORDED: MANCHESTER-BK 52-PG 283/4-12/19/58
#6 ARMAND & HELEN OUELLETTE
(A 0.11±) STA 428+89-429+89±
COND 11/12/58
RECORDED: MANCH.-BK 52-PG 271/8
11/14/58
#5B WILLIAM H. WOODS
(A 0.24±) STA 429+89-432+70±
WDOE 12/16/58
RECORDED: MANCH.-BK 52-PG 283/4-12/19/58
Revised Curve Data
Δ 11°28' Rt
D 0°38'
R 9046.75
T 908.3
L 1810.5
E 45.5
Do not Bank
#9 CLARA M. HEMENWAY
(A 1.41±) STA 432+80-443+88±
RELOCATE FENCE & GATE
COND 11/12/58
RECORDED: DORSET-BK 43-PG 373-11/14/58
#9 CLARA M. HEMENWAY
(A 0.02±) STA 432+69-433+00
COND 11/12/58
RECORDED: MANCHESTER-BK 52-PG 271/8-11/14
425+50
800' V.C.
748.85
-2.6306%
+0.304%
770
760
750
740
419
420
421
422
423
424
425
426
427
428
429
430
431
432
433
434
435
BM #5A-SIT-8" Elm 95 ft. Rt. Sta 427+39 Elevation 744.54
MANCHESTER-DORSET