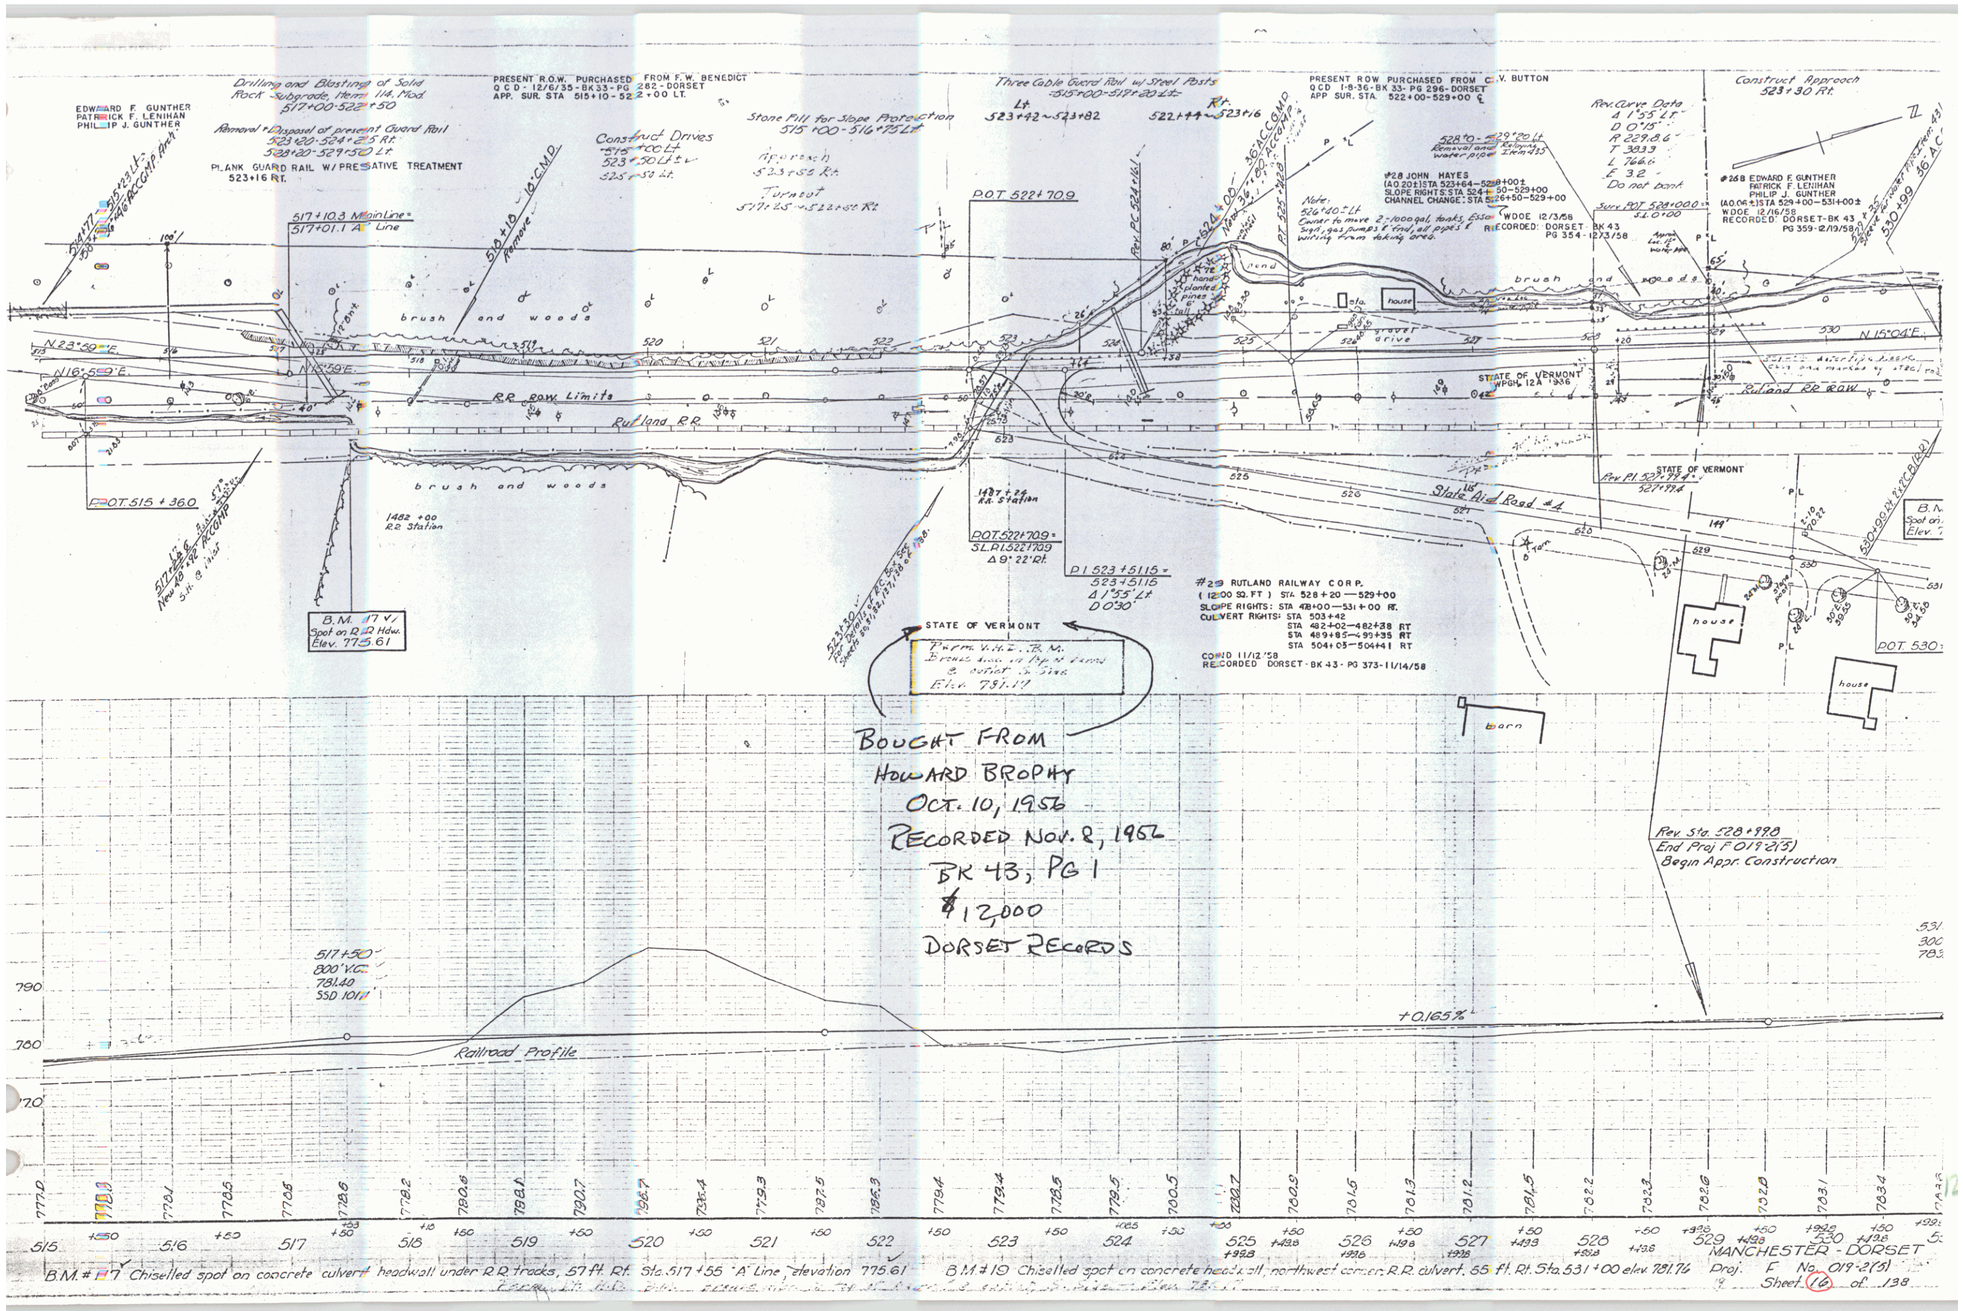


B.M. #17 Chiselled spot on concrete culvert headwall under R.R. tracks, 57 ft. Rt. Sta. 517+55 "A" Line, elevation 775.61

B.M. #19 Chiselled spot on concrete head wall, northwest corner R.R. culvert, 55 ft. Rt. Sta. 531+00 elev. 781.76